

# OTTAWA COUNTY ENGINEERS OFFICE

REFERENCE NO. 4-6-13-B  
NORTH QUARTER POST SEC. 4  
CLAY TWP.  
SHEET 1 OF 1.

ROUTE: STATE ROUTE #163

TOWNSHIP: CLAY

SECTION: 4

T 6 NR 13 E.


PERSONNEL:  
M. WITTMAN, P.S.  
J. ALLEN

NORTHING:

EASTING:

DATUM:

DATE / WEATHER / TEMP:  
AUGUST 29, 2013  
SUNNY  
83° F

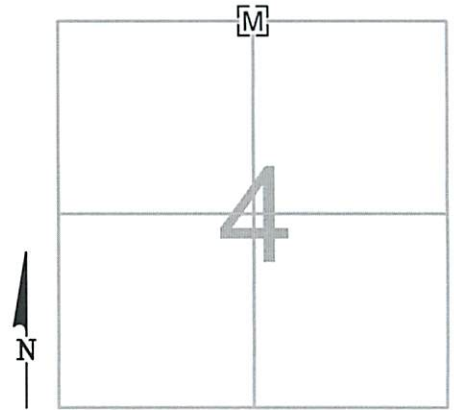

## MONUMENT INFORMATION

MONUMENT TYPE: FD. 1" Ø IRON PIN IN MON BOX  
ON SURFACE - BELOW:  
LEFT - CL PAV'T - RIGHT:



## MISC. INFORMATION

