

OTTAWA COUNTY ENGINEERS OFFICE

REFERENCE NO. 4-6-13-C
NE CORNER POST SEC. 4
CLAY TWP.
SHEET 1 OF 1.

PERSONNEL:
M. WITTMAN, P.S.
J. ALLEN

DATE / WEATHER / TEMP:
AUGUST 29, 2013
SUNNY
83° F

ROUTE: STATE ROUTE #163
@ MAIN STREET

TOWNSHIP: CLAY


SECTION: 4

T 6 NR 13 E.

NORTHING:

EASTING:

DATUM:

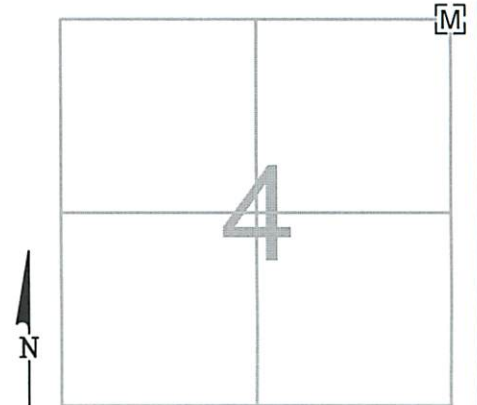

MONUMENT INFORMATION

MONUMENT TYPE: FD. 1" Ø IRON PIN IN MON BOX
ON SURFACE - BELOW:
LEFT - CL PAV'T - RIGHT: 0.4'



MISC. INFORMATION

