

# OTTAWA COUNTY ENGINEERS OFFICE

REFERENCE NO. 4-6-13-D  
 WEST QUARTER POST SEC. 4  
 CLAY TWP.  
 SHEET 1 OF 1.

ROUTE: T-53 REIMAN RD.

TOWNSHIP: CLAY

SECTION: 4

T 6 NR 13 E.

PERSONNEL:  
 M. WITTMAN, P.S.  
 J. ALLEN


NORTHING:

EASTING:

DATE / WEATHER / TEMP:

JUNE 28, 2016  
 OVERCAST - NW  
 70° F

DATUM:

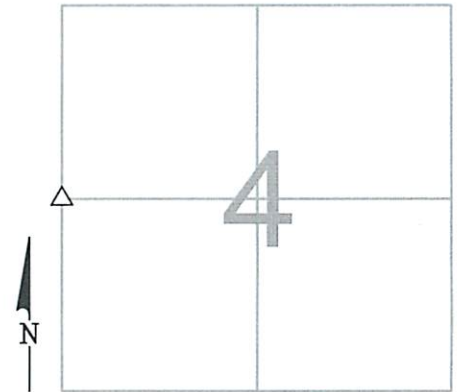

### MONUMENT INFORMATION

MONUMENT TYPE: FD 5" x 6" x 12" STONE  
 ON SURFACE - BELOW: 1.50'  
LEFT - CL PAV'T - RIGHT: 2.00'

USED HIGH POINT ON WEST END OF STONE.




### MISC. INFORMATION

FD 5/8" Ø x 10" LONG IRON PIN 0.02' BELOW SURFACE, TIED W/ X-TIES AND DUG FOR STONE. POINT USED ON STONE WAS DIRECTLY UNDER FD PIN AND MATCHED 3'-0" SHORT TIES N,S,E & W. THIS STONE PREVIOUSLY DUG BY BEC ASSOCIATES ON 6-27-1997, ALL LONG TIES WERE LOCATED AND USED.

JUNE 28, 2016

SET 1" SQUARE IRON PIN IN MONUMENT BOX OVER STONE

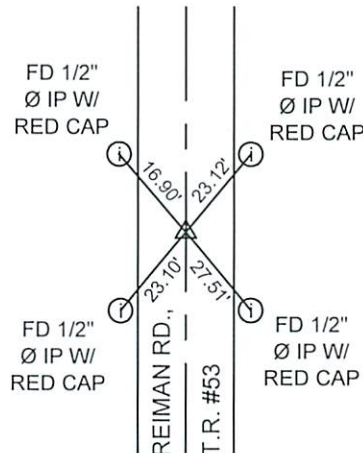

**\*\*ALL TIE DISTANCES ARE PLUMB**