

OTTAWA COUNTY ENGINEERS OFFICE

REFERENCE NO. 4-6-13-H
SOUTH QUARTER POST SEC. 4
CLAY TWP.
SHEET 1 OF 1.

ROUTE: T-4 CAMPER RD.

TOWNSHIP: CLAY

SECTION: 4

T 6 NR 13 E.

PERSONNEL:

J. ALLEN
M. ULLRICH
S. ULLRICH


NORTHING:

EASTING:

DATE / WEATHER / TEMP:

AUGUST 28, 2008
CLOUDY
65° F

DATUM:

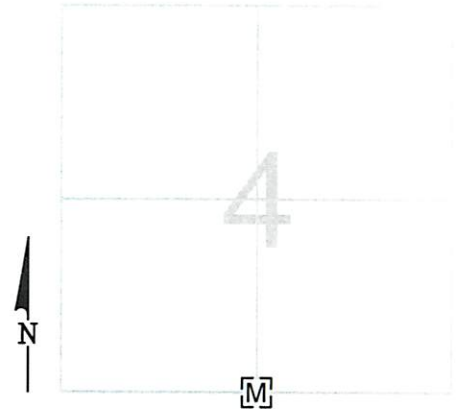

MONUMENT INFORMATION

MONUMENT TYPE: FD. 1" Ø IRON PIN IN
MONUMENT BOX
ON SURFACE - BELOW:
LEFT - CL PAV'T - RIGHT: 0.50'



MISC. INFORMATION

