

# OTTAWA COUNTY ENGINEERS OFFICE

**REFERENCE NO.** 5-6-13-A  
 NW CORNER POST SECTION 5  
 CLAY TWP.  
**SHEET** 1 OF 1.

**ROUTE:** T-54 BILLMAN RD.  
 @ STATE ROUTE #163

**TOWNSHIP:** CLAY

**SECTION:** 5

**T** 6 **NR** 13 **E.**

**PERSONNEL:**  
 M. WITTMAN, P.S.  
 J. ALLEN  
 VARIOUS ODOT  
 PERSONNEL


**NORTHING:**

**EASTING:**

**DATE / WEATHER / TEMP:**

10-3-22  
 SUNNY  
 61° F

**DATUM:**

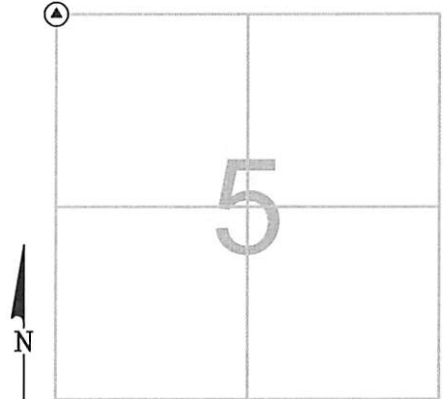

### MONUMENT INFORMATION

MONUMENT TYPE: SET ALUMINUM ODOT DISK  
ON SURFACE - BELOW:  
LEFT - CL PAV'T - RIGHT: 2.0' BILLMAN ROAD  
LEFT - CL PAV'T - RIGHT: 50.5' STATE ROUTE 163



### MISC. INFORMATION

FOUND RAILROAD SPIKE 0.58' BELOW SURFACE - REMOVED RAILROAD SPIKE. FD BLACK MARBLE GRANITE STONE 1.6' BELOW SURFACE. RAILROAD SPIKE WAS 4.5' SOUTH AND 0.5' EAST OF STONE.

1" ROUND IRON PIN IN MOUMENT BOX SET PER 2002 ODOT S.R. #163 RE-LOCATION PLANS RECORDED 4-23-02 IN THE OTTAWA COUNTY RECORDERS OFFICE. IRON PIN, MONUMENT BOX AND STONE REMOVED FOR O.D.O.T. BRIDGE RECONSTRUCTION PROJECT, TIED BY GPS AND RESET AS ALUMINUM O.D.O.T DISK ON 10-3-2022.

ALL TIES ARE TO THE NOTED ANCHOR BOLT FOR THE GUARDRAIL ASSEMBLY ONTO THE HEADWALL

