

OTTAWA COUNTY ENGINEERS OFFICE

REFERENCE NO. 5-6-13-B
NORTH QUARTER POST SEC. 5
CLAY TWP.
SHEET 1 OF 1.

ROUTE: STATE ROUTE #163

TOWNSHIP: CLAY

SECTION: 5

T 6 NR 13 E.


PERSONNEL:
M. WITTMAN, P.S.
J. ALLEN

NORTHING:

EASTING:

DATUM:

DATE / WEATHER / TEMP:
AUGUST 29, 2013
SUNNY
83° F

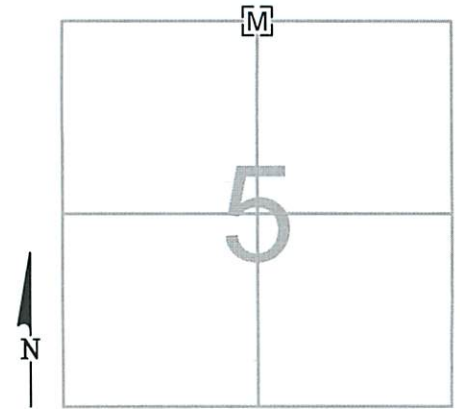

MONUMENT INFORMATION

MONUMENT TYPE: FD. 1" Ø IRON PIN IN MON BOX
ON SURFACE - BELOW:
LEFT - CL PAV'T - RIGHT: 23.60'



MISC. INFORMATION

IN DRIVE TO RESIDENCE #23515

