OTTAWA COUNTY ENGINEERS OFFICE

REFERENCE NO. 5-6-13-D
WEST QUARTER POST SEC. 5

CLAY TWP.

SHEET 1 OF 1.

ROUTE: T-54 BILLMAN RD.

TOWNSHIP: CLAY

SECTION: 5

T 6 NR 13 E.

PERSONNEL:


M. WITTMAN, P.S. J. ALLEN

NORTHING:

EASTING:

DATE / WEATHER / TEMP:

OCTOBER 8, 2009 CLOUDY - S 58° F DATUM:

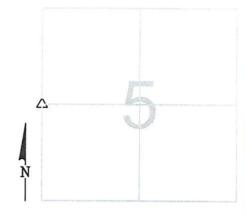

MONUMENT INFORMATION

MONUMENT TYPE: FD. POINTED HARDHEAD STONE

ON SURFACE - <u>BELOW</u>: 1.08' <u>LEFT</u> - CL PAV'T - RIGHT: 1.30'

RECTANGULAR STONE: 11" x 13"

MISC. INFORMATION

FD. RAILROAD SPIKE 0.25' BELOW SURFACE. TIED WITH CROSS TIES AND DUG FOR STONE. FOUND STONE IS POINTED WITH HIGH POINT BEING ON THE NORTH EDGE OF STONE. CHECKED HIGH POINT WITH RR SPIKE CROSS TIES AND THEY MATCHED. USED HIGH POINT OF STONE.



OCTOBER 8, 2009

SET 1" SQUARE IRON PIN IN MONUMENT BOX OVER STONE

