

OTTAWA COUNTY ENGINEERS OFFICE

REFERENCE NO. 5-6-13-G
SW CORNER SECTION 5
CLAY TWP.
SHEET 1 OF 1.

ROUTE: T-4 CAMPER RD.
@ T-54 BILLMAN RD.

TOWNSHIP: CLAY

SECTION: 5

T 6 NR 13 E.


NORTHING:

EASTING:

DATUM:

PERSONNEL:
J. ALLEN
M. ULLRICH
S. ULLRICH

DATE / WEATHER / TEMP:
AUGUST 28, 2008
CLOUDY
65° F

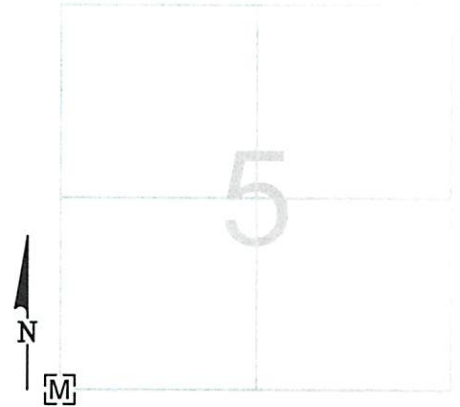

MONUMENT INFORMATION

MONUMENT TYPE: FD. 1" Ø IRON PIN IN
MONUMENT BOX
ON SURFACE - BELOW: 0.36'
LEFT - CL PAV'T - RIGHT: 3.0' BILLMAN NORTH



MISC. INFORMATION

