

OTTAWA COUNTY ENGINEERS OFFICE

REFERENCE NO. 5-6-13-H
SOUTH QUARTER POST SEC. 5
CLAY TWP.
SHEET 1 OF 1.

ROUTE: T-4 CAMPER RD.

TOWNSHIP: CLAY

SECTION: 5

T 6 NR 13 E.

PERSONNEL:

J. ALLEN
M. ULLRICH
S. ULLRICH


NORTHING:

EASTING:

DATE / WEATHER / TEMP:

AUGUST 29, 2008
CLOUDY
84° F

DATUM:

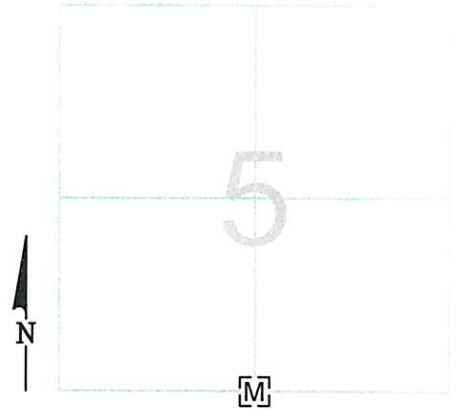

MONUMENT INFORMATION

MONUMENT TYPE: FD. 1" Ø IRON PIN IN
MONUMENT BOX
ON SURFACE - BELOW: 0.36'
LEFT - CL PAV'T - RIGHT: 3.0'



MISC. INFORMATION

