

OTTAWA COUNTY ENGINEERS OFFICE

REFERENCE NO. 6-6-13-C
 NE CORNER POST SECTION 6
 CLAY TWP.
SHEET 1 OF 1.

ROUTE: T-54 BILLMAN RD.
 @ STATE ROUTE #163

TOWNSHIP: CLAY

SECTION: 6


T 6 NR 13 E.

PERSONNEL:
 R. NUHFER, P.S.
 M. BROUGH
 VARIOUS ODOT
 PERSONNEL

NORTHING:

EASTING:

DATUM:

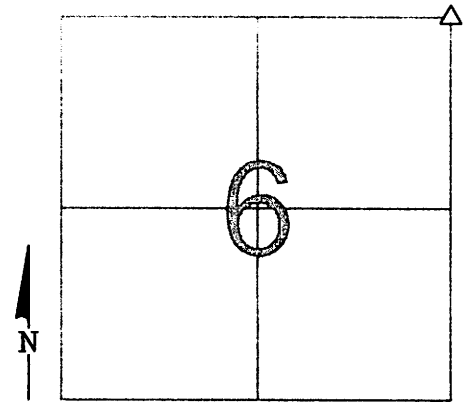

DATE / WEATHER / TEMP:

JULY 19, 2001
 SUNNY - HAZE
 90° F

MONUMENT INFORMATION

MONUMENT TYPE: FD BLACK MARBLE GRANITE
 ON SURFACE - BELOW: 1.6'
 LEFT - CL PAV'T - RIGHT:
 ROUND STONE: 12" DIAMETER

MISC. INFORMATION

FOUND RAILROAD SPIKE 0.58' BELOW SURFACE -
 REMOVED RAILROAD SPIKE. RAILROAD SPIKE WAS
 4.5' SOUTH AND 0.5' EAST OF STONE.

1" ROUND IRON PIN IN MOUMENT BOX SET PER 2002
 ODOT S.R. #163 RE-LOCATION PLANS RECORDED 4-23-02 IN
 THE OTTAWA COUNTY RECORDERS OFFICE.

PHOTO OF STONE NOT AVAILABLE

