


# OTTAWA COUNTY ENGINEERS OFFICE

REFERENCE NO. 6-6-13-D  
 WEST QUARTER POST SEC. 6  
 CLAY TWP.  
 SHEET 1 OF 1.

ROUTE: C-2 FOSTORIA RD.  
 TOWNSHIP: CLAY  
 SECTION: 6  
 T 6 NR 13 E.

PERSONNEL:  
 M. WITTMAN, P.S.  
 J. ALLEN  
 B. BRADY  
 T. FOCHT  
 A. STAIB - WOOD CO.

NORTHING:  
 EASTING:  
 DATUM:

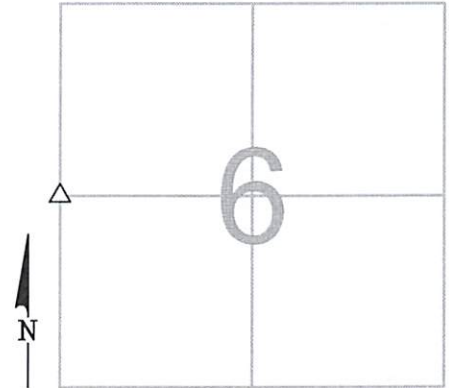

DATE / WEATHER / TEMP:  
 MAY 6, 2024  
 CLOUDY E-NE  
 57° F

### MONUMENT INFORMATION

MONUMENT TYPE: FD. HARDHEAD STONE  
 ON SURFACE - BELOW: 1.27'  
LEFT - CL PAV'T - RIGHT: 5.2'  
 FD. 8" X 7" DOMED HARDHEAD STONE



### MISC. INFORMATION

FD. RR SPIKE 0.46' BELOW SURFACE, TIES WITH GPS AND DUG FOR STONE OF RECORD FROM 1939. SET 1" SQ. IRON PIN IN MONUMENT OVER HIGH POINT ON DOMED STONE. RR SPIKE WAS 0.81' EAST AND 0.03' NORTH OF POINT USED ON STONE. POINT IS 0.02' EAST OF COUNTY LINE.  
**THIS IS A CLOSING CORNER**


MAY 6, 2024

SET 1" SQUARE IRON PIN  
 IN MONUMENT BOX OVER  
 STONE

RR SPIKE SET BY  
 WOOD COUNTY  
 EAST 1/4 POST

E/W HALF SECTION LINE  
 TROY TWP. SECTION 1, T6N R12E

WOOD COUNTY

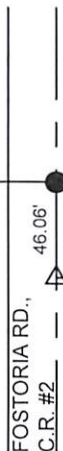

OTTAWA COUNTY

E/W HALF SECTION LINE  
 CLAY TWP. SECTION 6, T6N R13E