

# OTTAWA COUNTY ENGINEERS OFFICE

REFERENCE NO. 6-6-13-F  
EAST QUARTER POST SEC. 6  
CLAY TWP.  
SHEET 1 OF 1.

ROUTE: T-54 BILLMAN RD.

TOWNSHIP: CLAY

SECTION: 6

T 6 NR 13 E.

**PERSONNEL:**

M. WITTMAN, P.S.  
J. ALLEN


NORTHING:

EASTING:

DATUM:

**DATE / WEATHER / TEMP:**

OCTOBER 8, 2009  
CLOUDY - S  
58° F

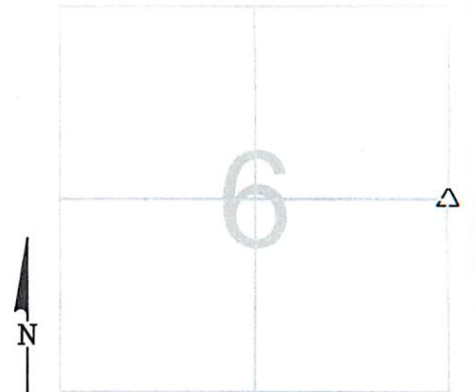

MONUMENT INFORMATION

MONUMENT TYPE: FD. POINTED HARDHEAD STONE  
ON SURFACE - BELOW: 1.08'  
LEFT - CL PAV'T - RIGHT: 1.30'

RECTANGULAR STONE: 11" x 13"



MISC. INFORMATION

FD. RAILROAD SPIKE 0.25' BELOW SURFACE. TIED WITH CROSS TIES AND DUG FOR STONE. FOUND STONE IS POINTED WITH HIGH POINT BEING ON THE NORTH EDGE OF STONE. CHECKED HIGH POINT WITH RR SPIKE CROSS TIES AND THEY MATCHED. USED HIGH POINT OF STONE.

OCTOBER 8, 2009

SET 1" SQUARE IRON PIN  
IN MONUMENT BOX OVER  
STONE

