

OTTAWA COUNTY ENGINEERS OFFICE

REFERENCE NO. 6-6-13-H
SOUTH QUARTER POST SEC. 6
CLAY TWP.
SHEET 1 OF 1.

PERSONNEL:
J. ALLEN
M. ULLRICH
S. ULLRICH

DATE / WEATHER / TEMP:
AUGUST 29, 2008
CLOUDY
84° F

ROUTE: T-4 CAMPER RD.

TOWNSHIP: CLAY


SECTION: 6

T 6 NR 13 E.

NORTHING:

EASTING:

DATUM:

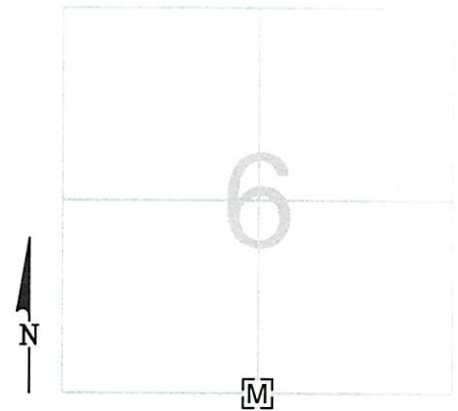

MONUMENT INFORMATION

MONUMENT TYPE: FD. 1" Ø IRON PIN IN
MONUMENT BOX
ON SURFACE - BELOW: 0.36'
LEFT - CL PAV'T - RIGHT: 1.0'



MISC. INFORMATION

