


LEFT SIDE ELEVATION 1/4" = 1'-0"
SEE TYP. NOTES FRONT ELEVATION

GARBER'S
PRINTING - NOVELTIES - OFFICE FURNITURE
22 S. SANDUSKY DELAWARE, OHIO 363-7884

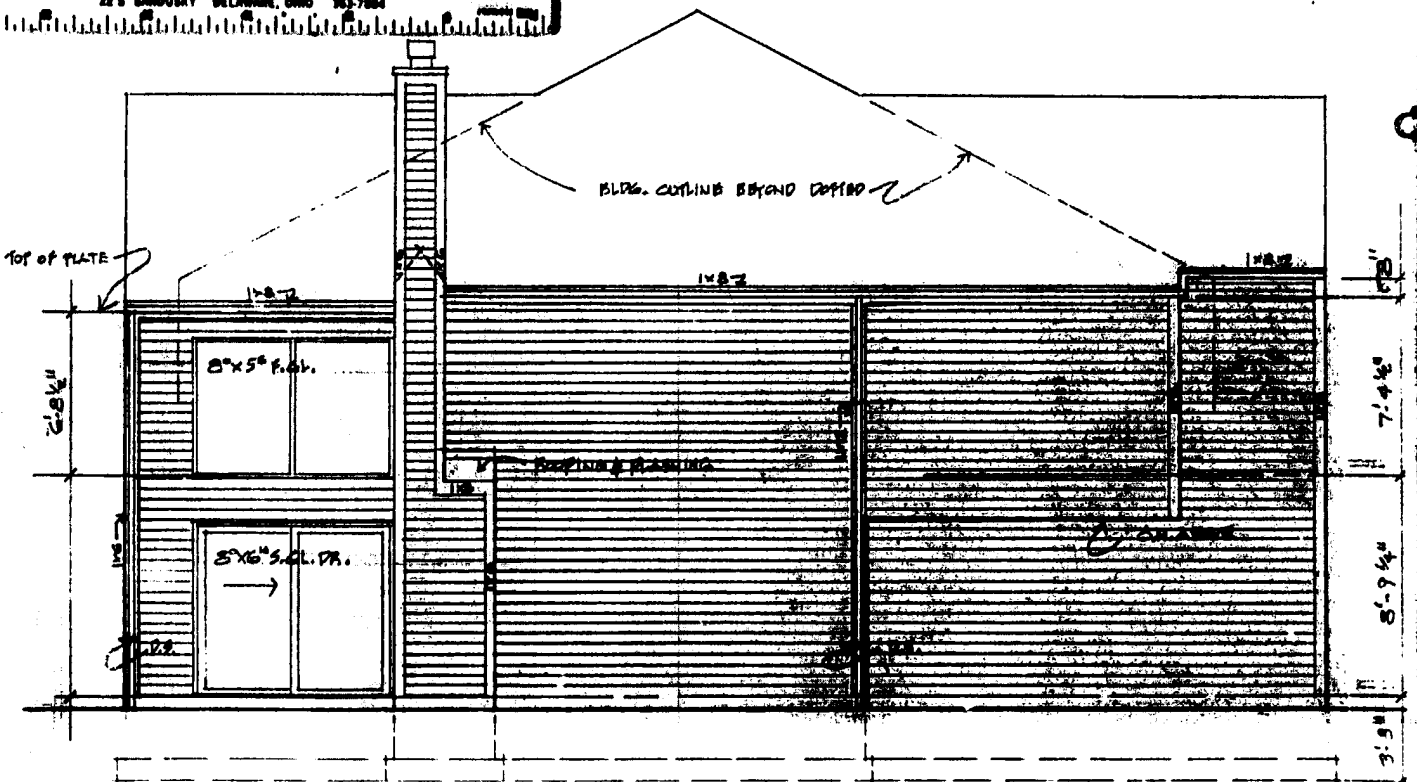

RIGHT SIDE ELEVATION 1/4" = 1'-0"
SEE TYP. NOTES FRONT ELEVATION


#19092

Received January 11, 1954 at 11:45 AM
Recorded 1/11/54 by W. H. V. 102

William R. Kassar

William R. Kassar
Cleveland, Ohio

Per S. 10.00

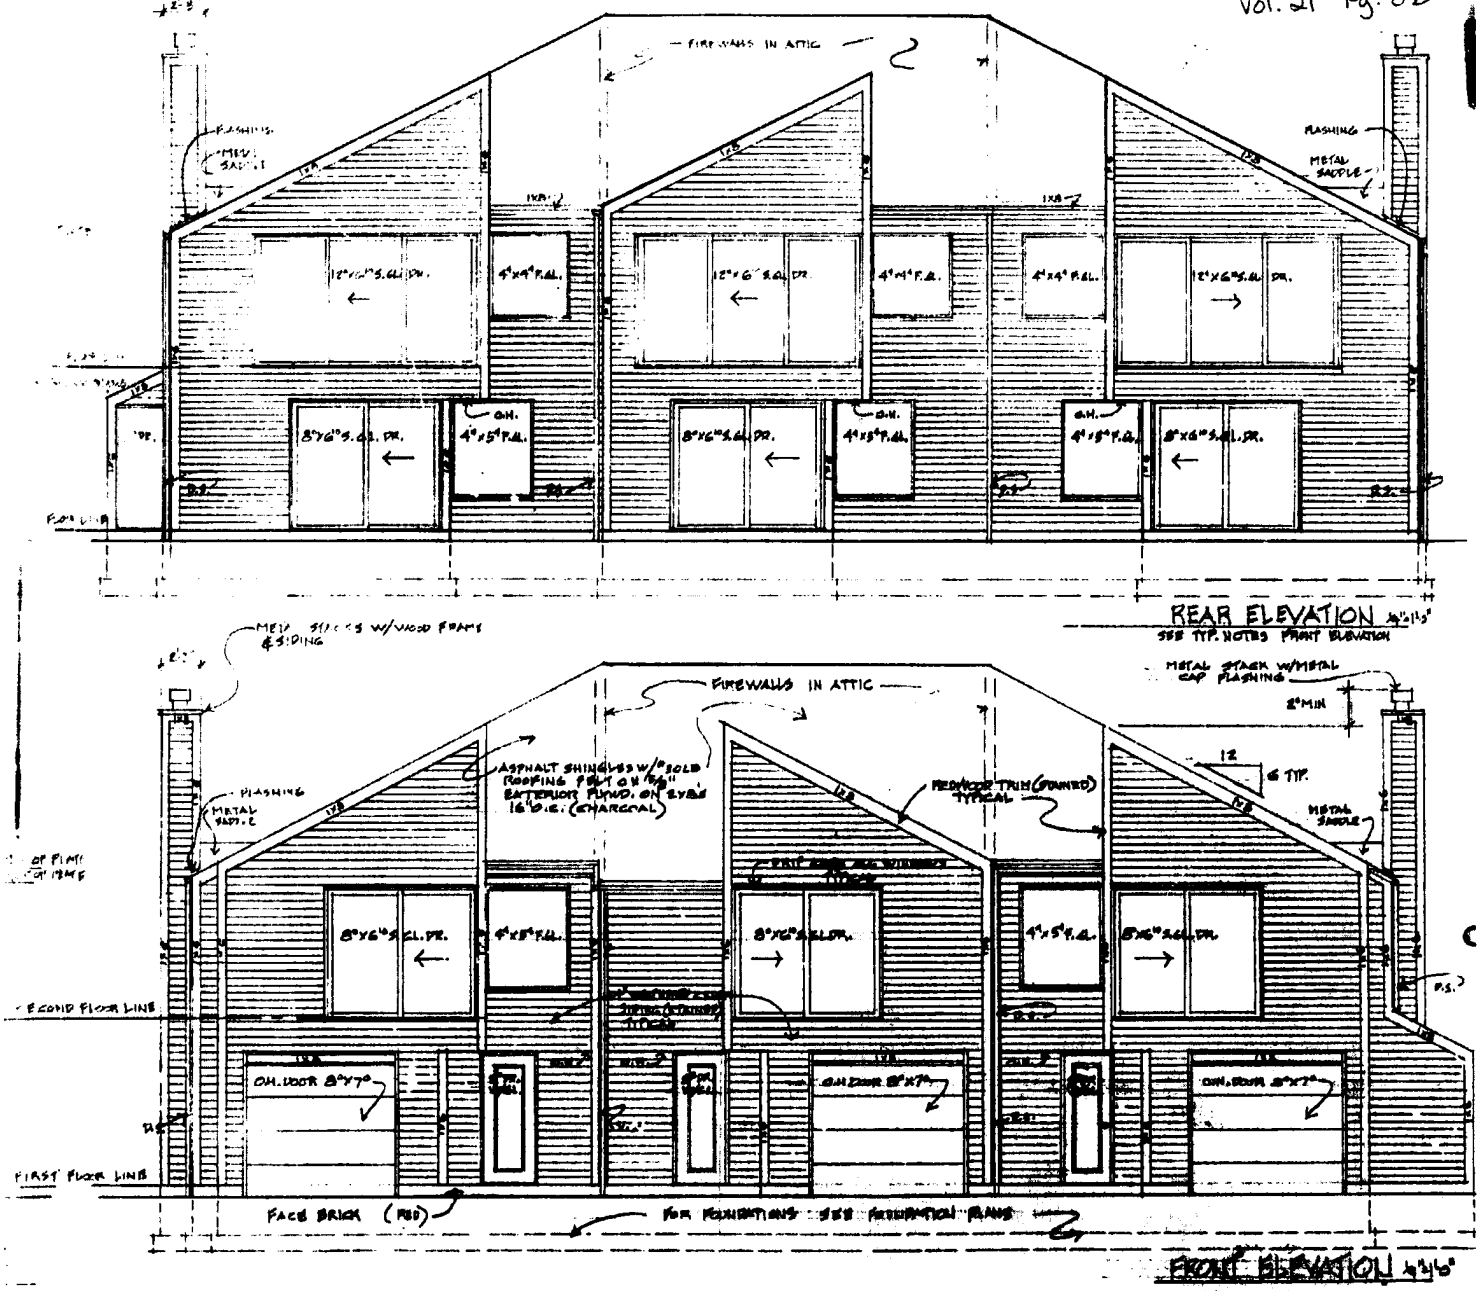

REAR ELEVATION 44'11"

FRONT ELEVATION 44'6"



RECORD SET OF DRAWINGS
ELEVATIONS FOR PLANS C, B, C. 1/4"=1'-0"

41002
 Prepared by *[Signature]*
 Checked by *[Signature]*
 Date *[Date]*


BLUE WATER CONDOMINIUMS
 8925 NORTH SHORE BLVD LAKESIDE-HARLEHEAD, OHIO 43440
 ARCHITECT FREDERICK F. LEONARD
 19301 LORAIN ROAD - FAIRMONT PARK, OHIO 44126
 1-216-336-1122



#18042

Prepared by: *[Signature]*
 Checked by: *[Signature]*
 Date: *[Date]*

SEE NOTES & DETAILS
 DWG. A-2 DATED: REBID 10/14/84

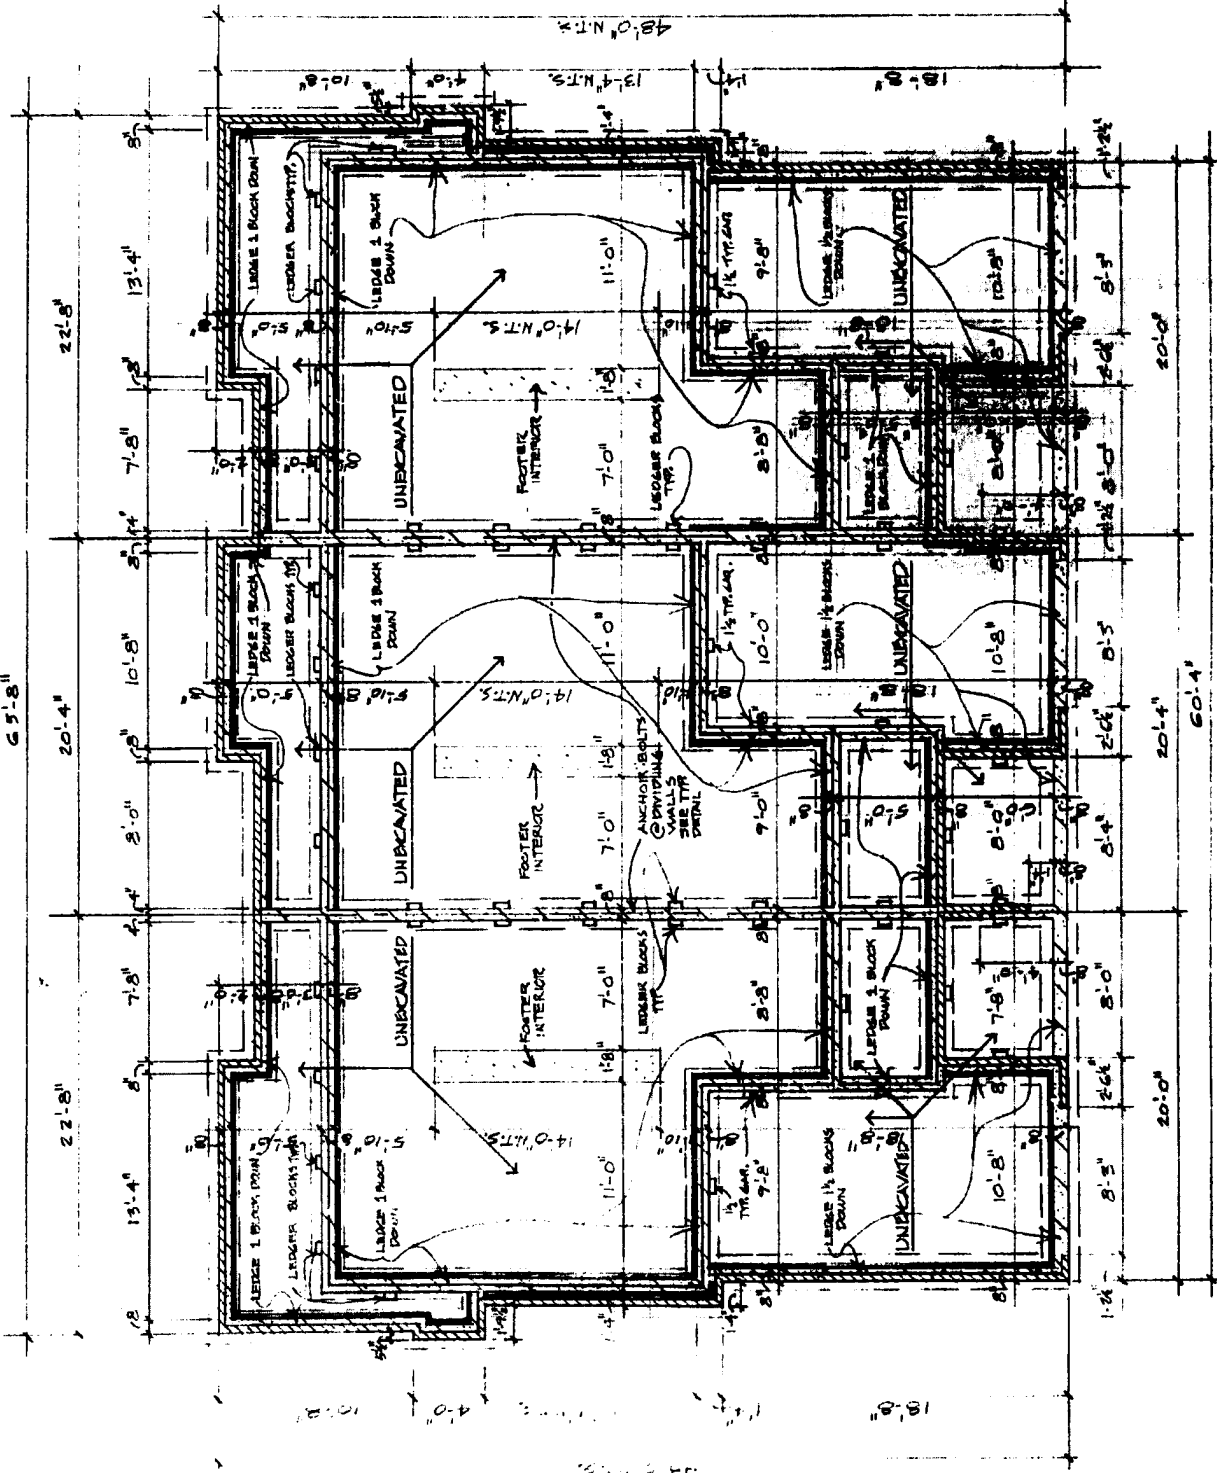


FOUNDATION PLANS UNITS 518, 519, 520
 54 CONDOMINIUMS @ DANBURY TWP. OHIO

Prepared by: *[Signature]*
 Checked by: *[Signature]*
 Date: *[Date]*

10-1-1980

410042

WILLIAM F. BAKER
ARCHITECT
11111 LEXINGTON AVENUE
NEW YORK, N.Y. 10025

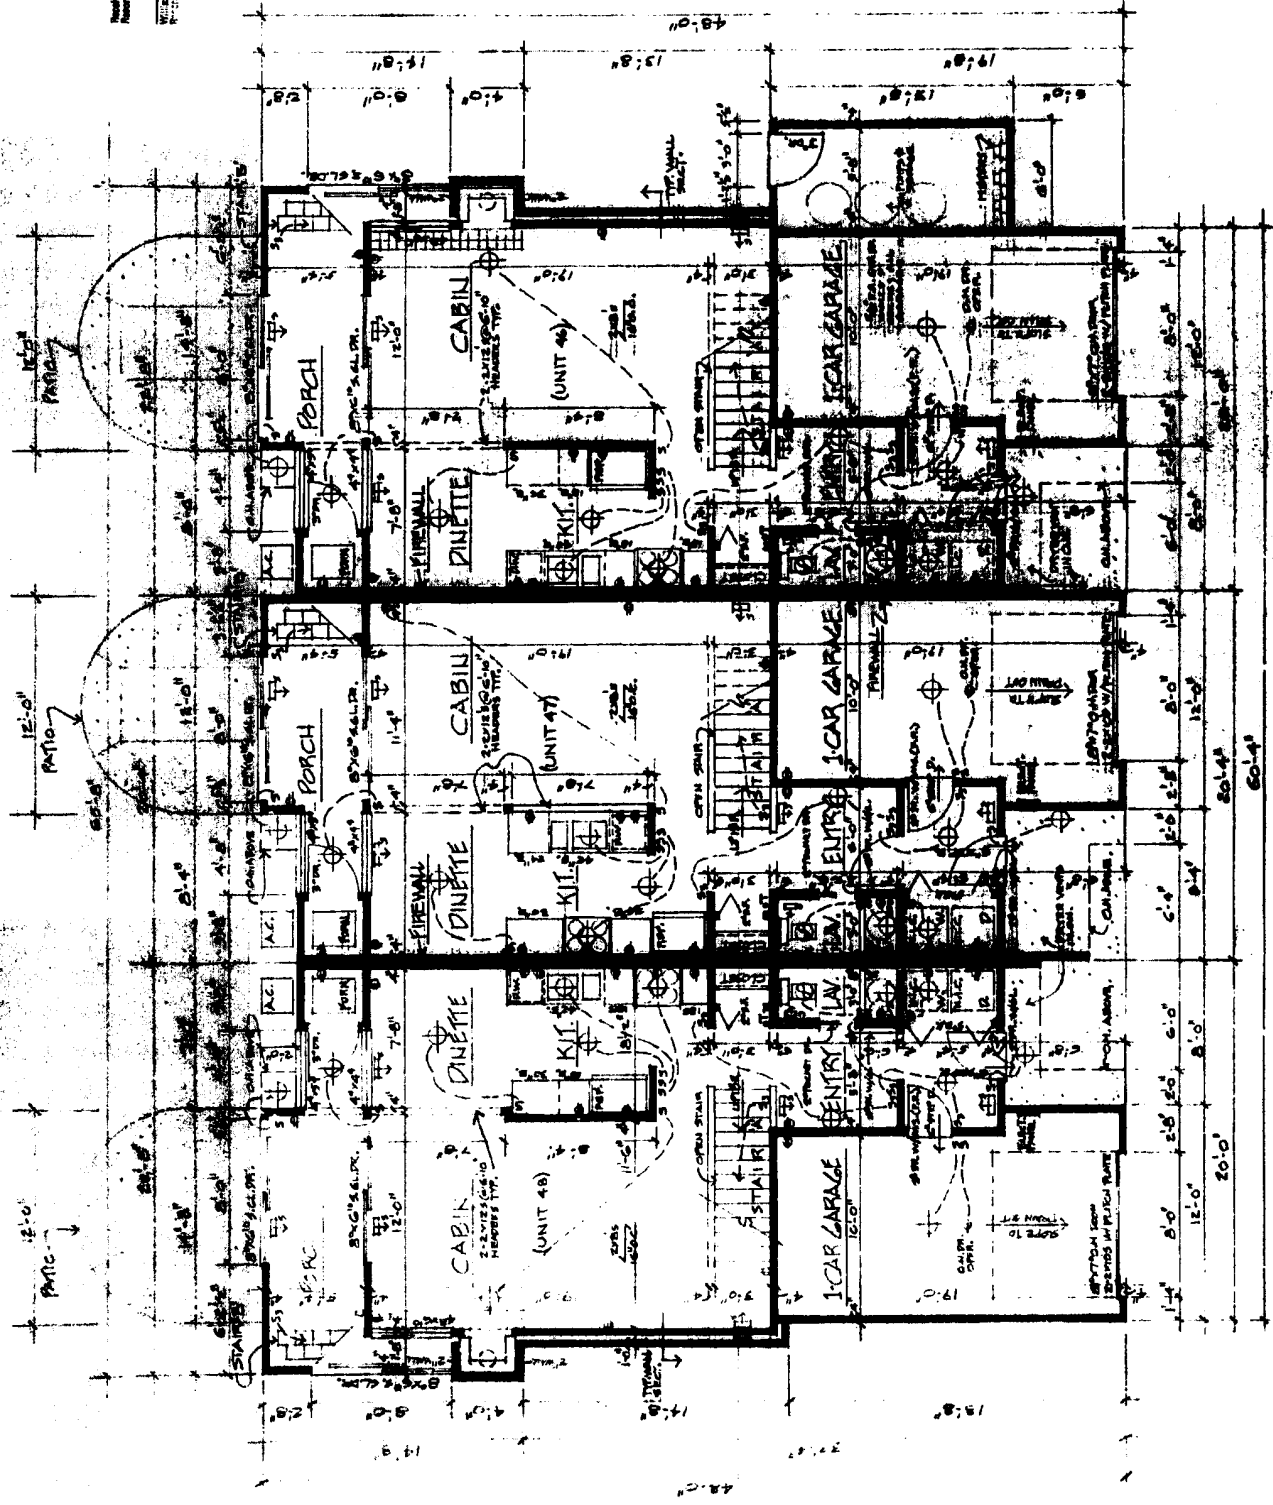


FIRST FLOOR PLANS C.B.C. 4-10'
 BLUE WATER CONDOMINIUMS
 11111 LEXINGTON AVENUE, NEW YORK, N.Y. 10025

WILLIAM F. BAKER
 ARCHITECT
 11111 LEXINGTON AVENUE
 NEW YORK, N.Y. 10025

STATE OF OHIO
 LICENSE NO. 10000
 WILLIAM F. BAKER
 ARCHITECT

1942
RECORD SET OF DRAWINGS
C.B.C. ARCHITECTS
1000 EAST 12TH ST.
CINCINNATI, OHIO

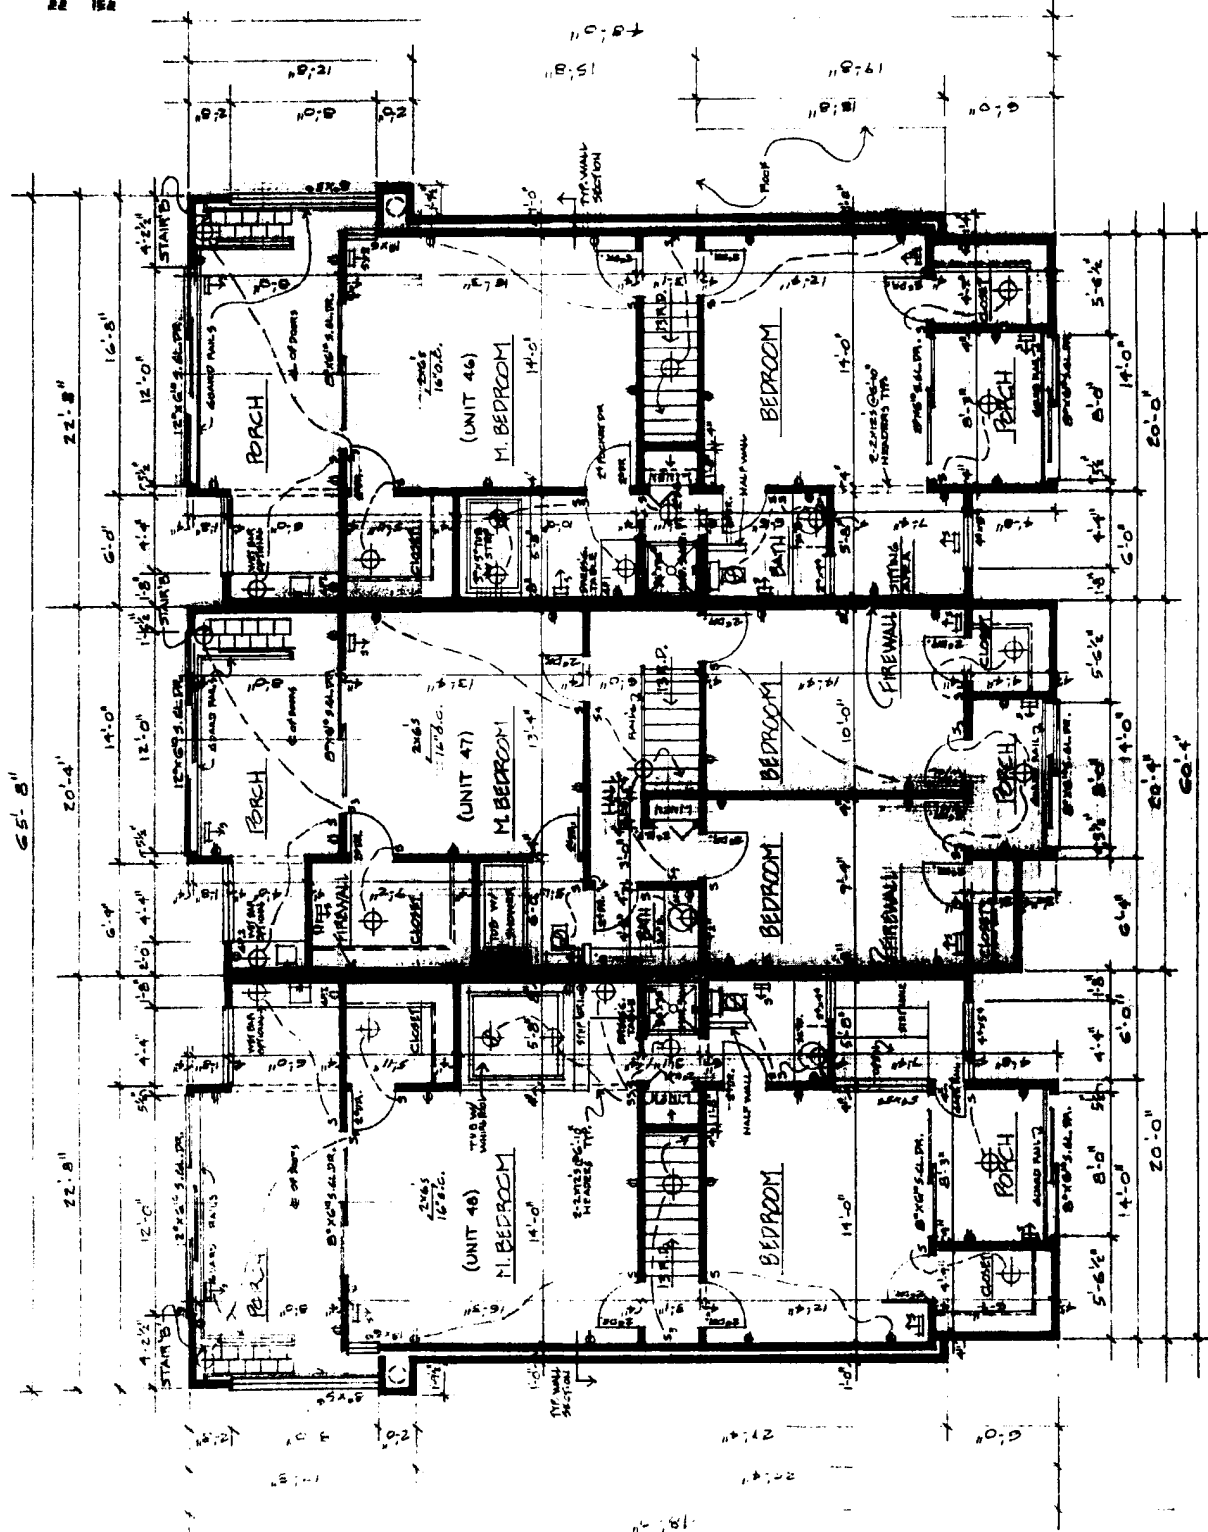

RECORD SET OF DRAWINGS
SECOND FLOOR PLANS C.B.C. 4-10'
BLUE WATER CONDOMINIUMS
2025 NORTH SHORE BLVD. LAKE SHORE MARLBOROUGH, OHIO 43040
ARCHITECT: FREDERICK F. LEONARD
1000 EAST 12TH ST. CINCINNATI, OHIO 45202

