



CONTRACTOR: GARDNER S. GARDNER
200 S. UNIVERSITY AVENUE, SUITE 100
ANN ARBOR, MICHIGAN 48106

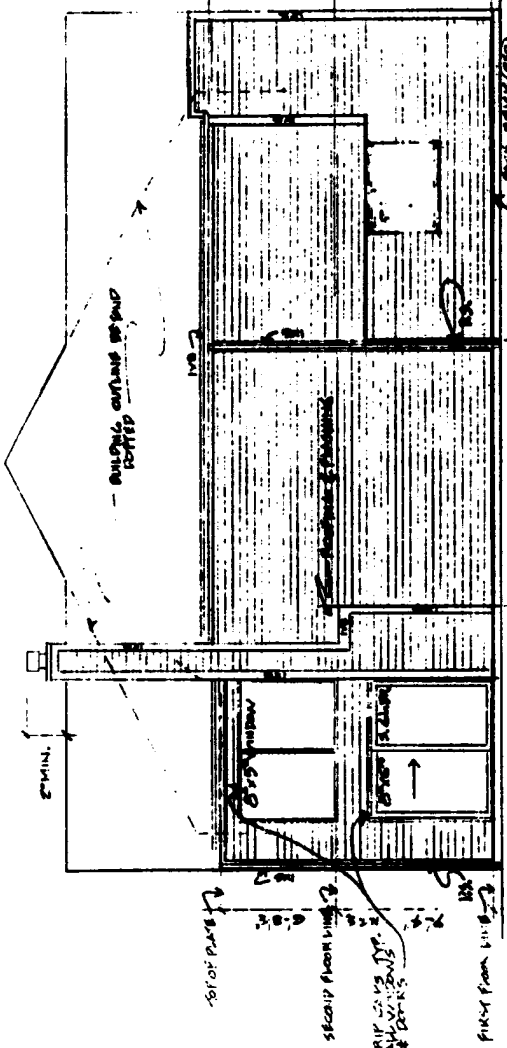

RIGHT SIDE ELEVATION 1/4" = 1'-0"

SEE TOP NOTES FRONT ELEVATION

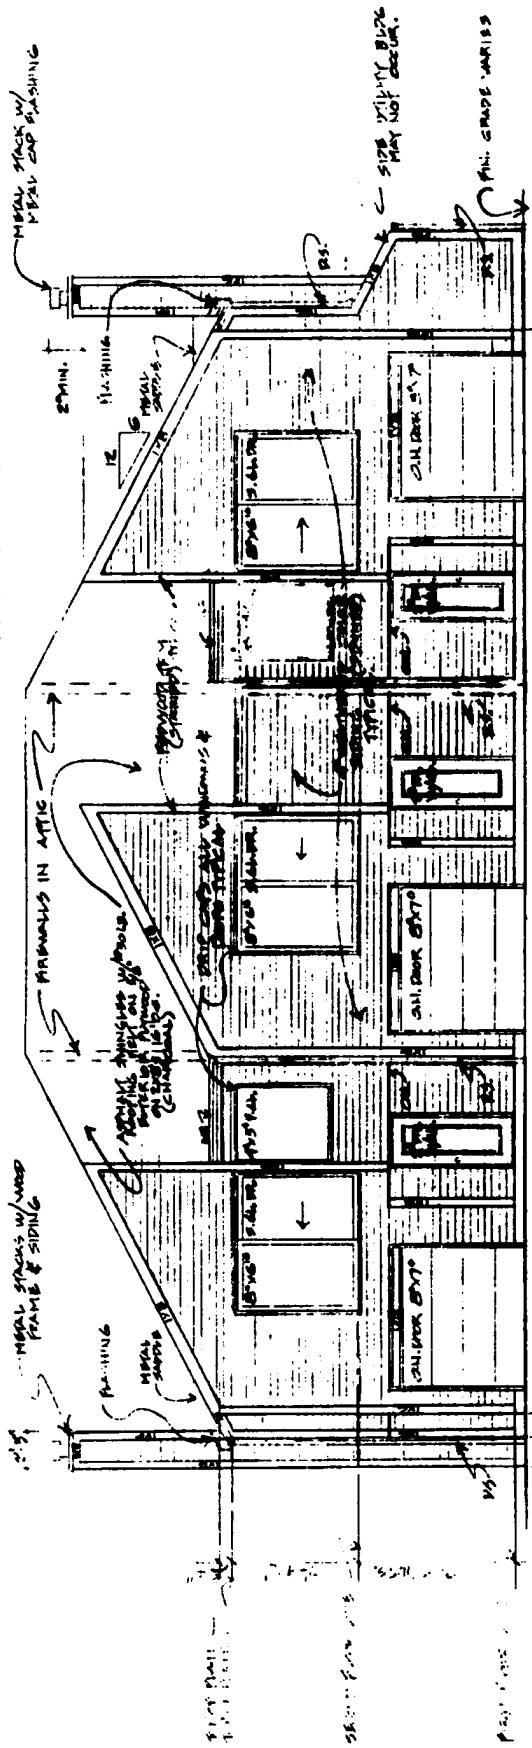

FRONT ELEVATION 1/4" = 1'-0"

SEE FOUNDATIONS 988 FOUNDATION PLANS 27



BOARD SET OF DRAWINGS
ELEVATIONS UNITS C.B.C. 4/10

BLUE WATER CONDOMINIUMS
2005 NORTHSHORE BLVD. LAKESIDE, MICHIGAN 48140
ARCHITECT: FREDERICK FLEHARD
7510 LORAIN RD., ANN ARBOR, MI 48106
TEL: 973-956-1422 FAX: 973-956-1425

3/4/95
Revised: August 28, 1997 at 5:20 PM.
Revised: August 29, 1997
At 2:14 PM at 8/29/97
William H. Hays, Registrar




I HEREBY CERTIFY THAT THE WITHIN DRAWINGS WERE DRAWN BY ME OR UNDER MY CLOSE PERSONAL SUPERVISION AND THAT I AM A LICENSED PROFESSIONAL ENGINEER IN THE STATE OF OHIO AT THE TIME AND PLACE WHERE THESE DRAWINGS WERE PREPARED.




PROFESSIONAL ENGINEER LICENSE NO. 14872
DATE: 10/25/95
STATE OF OHIO
REGISTERED ARCHITECT: 4814

GARBER'S
 ARCHITECTS
 210 UNIVERSITY AVENUE, SUITE 200
 BOSTON, MASSACHUSETTS 02118
 TEL: 552-488-1111 FAX: 552-488-1112

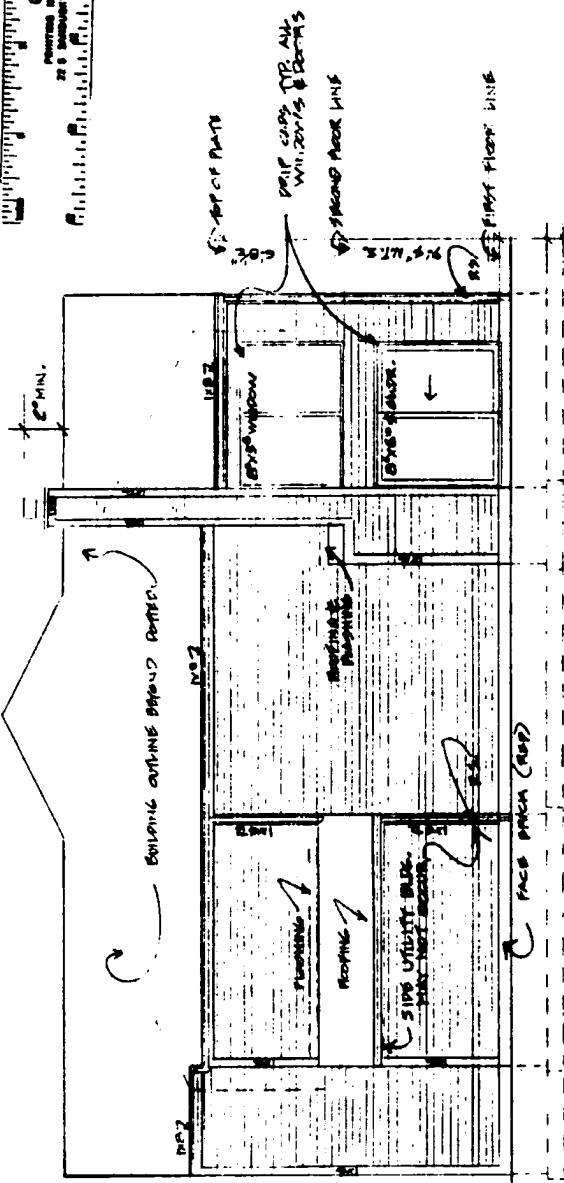

LEFT SIDE ELEVATION 4'-0" x 10'-0"
 SEE ATTACHED NOTES FRONT ELEVATION

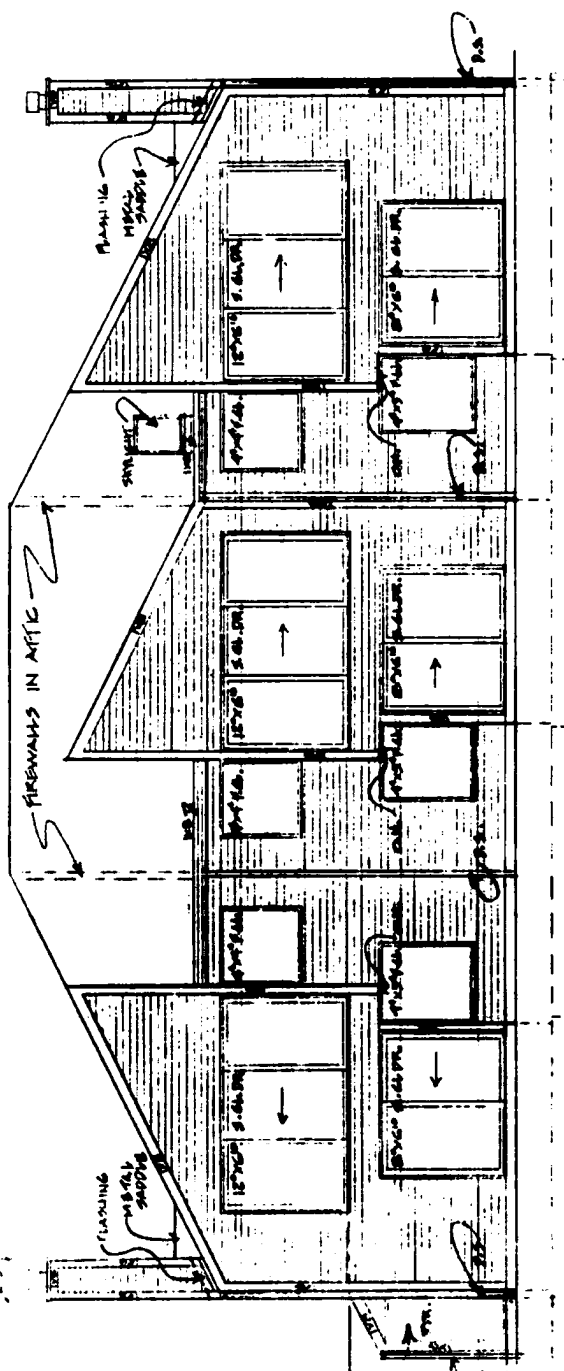

REAR ELEVATION 4'-0" x 10'-0"




RECORD SET OF DRAWINGS
 ELEVATIONS UNITS C' B' C 4'-0"

10/1/03
 DRAWING: CHECKED BY: [Signature]
 DATE: 10/1/03
 PROJECT: BLUE WATER COND. UNITS

BLUE WATER CONDOMINIUMS
 2855 WASHINGTON BLVD. LANSING, MICHIGAN 48204
 ARCHITECT: GARBER'S ARCHITECTS, INC.
 PROJECT NO.: 03-001
 DATE: 10/1/03

PROFESSOR BARBER'S
23 1/2 HOURS
REQUIREMENTS

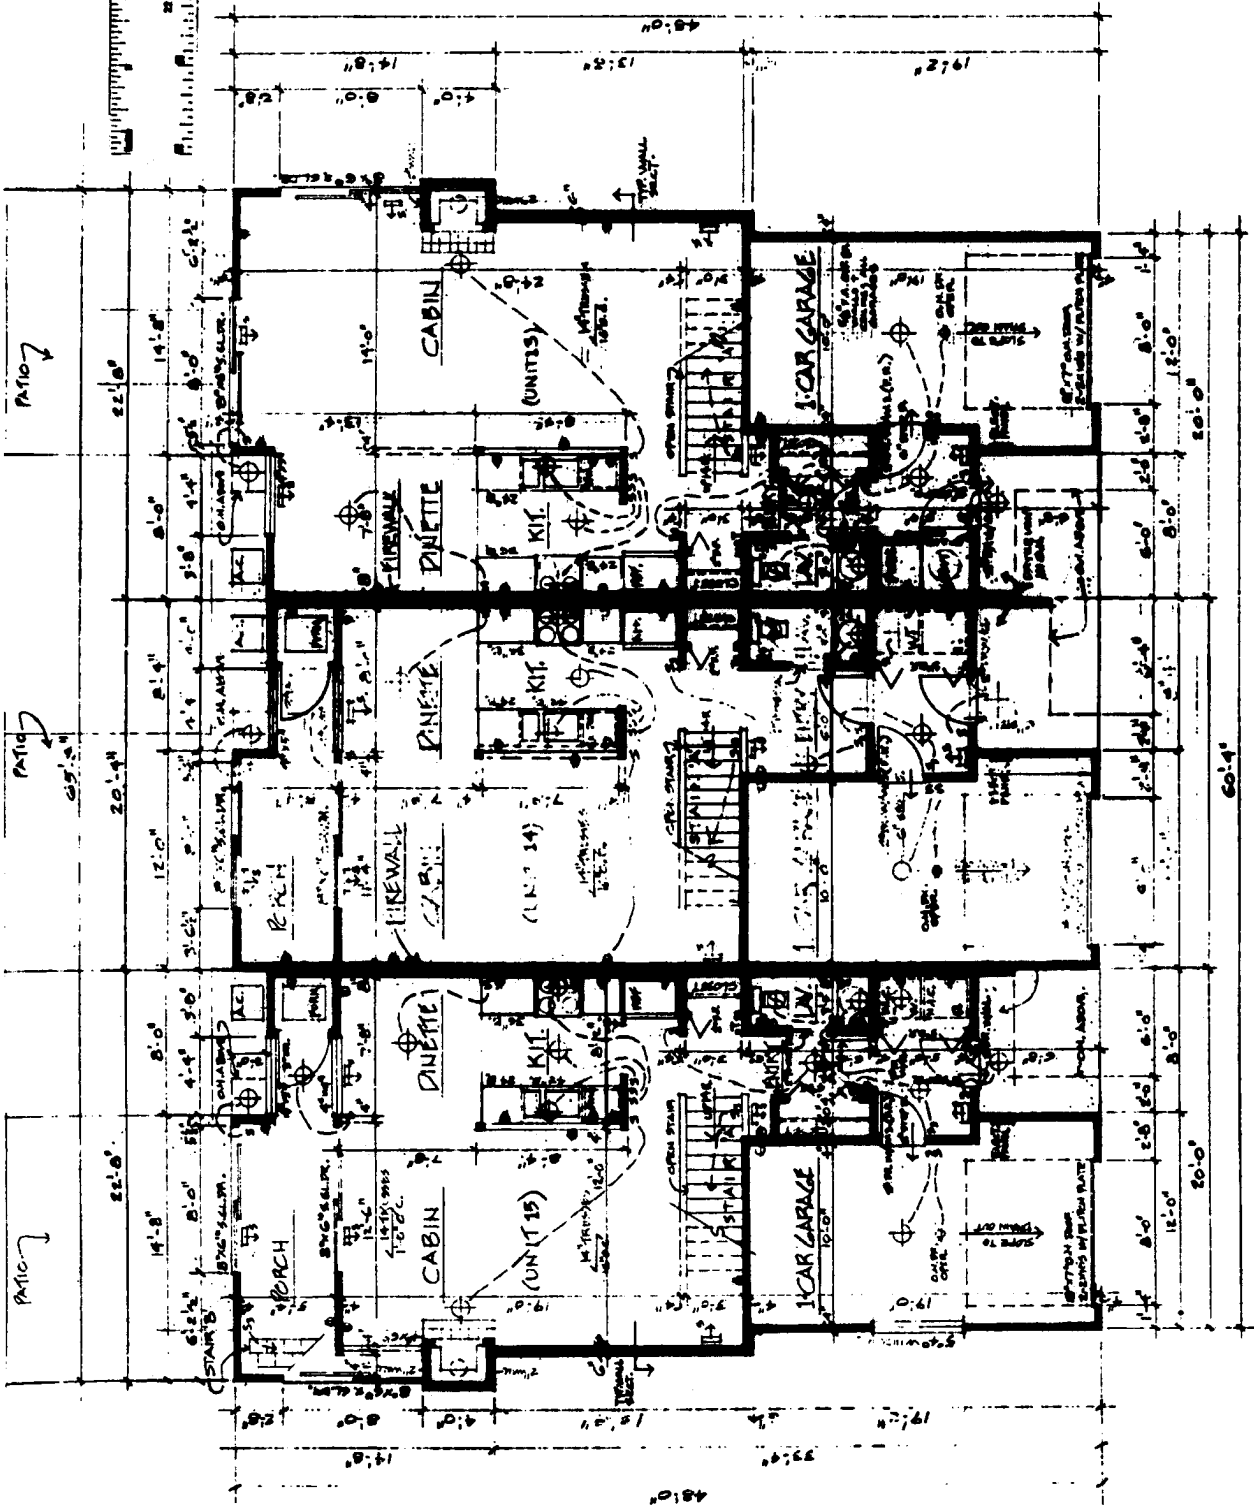


RECORD SET OF DRAWINGS
FIRST FLOOR PLANS C.B.C. 4.10'
OF THE PROJECT LOCATIONS

BLUE WATER CONDOMINIUMS
8885 NORTH SHORE BLVD., LAKEVIEW-HARBORHEAD, OHIO 43140
ARCHITECT: FREDERICK F. UNGERLIND
14561 DORRAN RD., FARMERS MARKET, OHIO 43122
TEL: 614-885-1122



4th 24-012
Revised: October 24, 1991 at 2:30 P.M.
Checked: October 24, 1991
By: F. F. Ungerlind, P.E.
F. F. Ungerlind, P.E.

A-4000
6-30-87 MARK
7-30-87 MARK

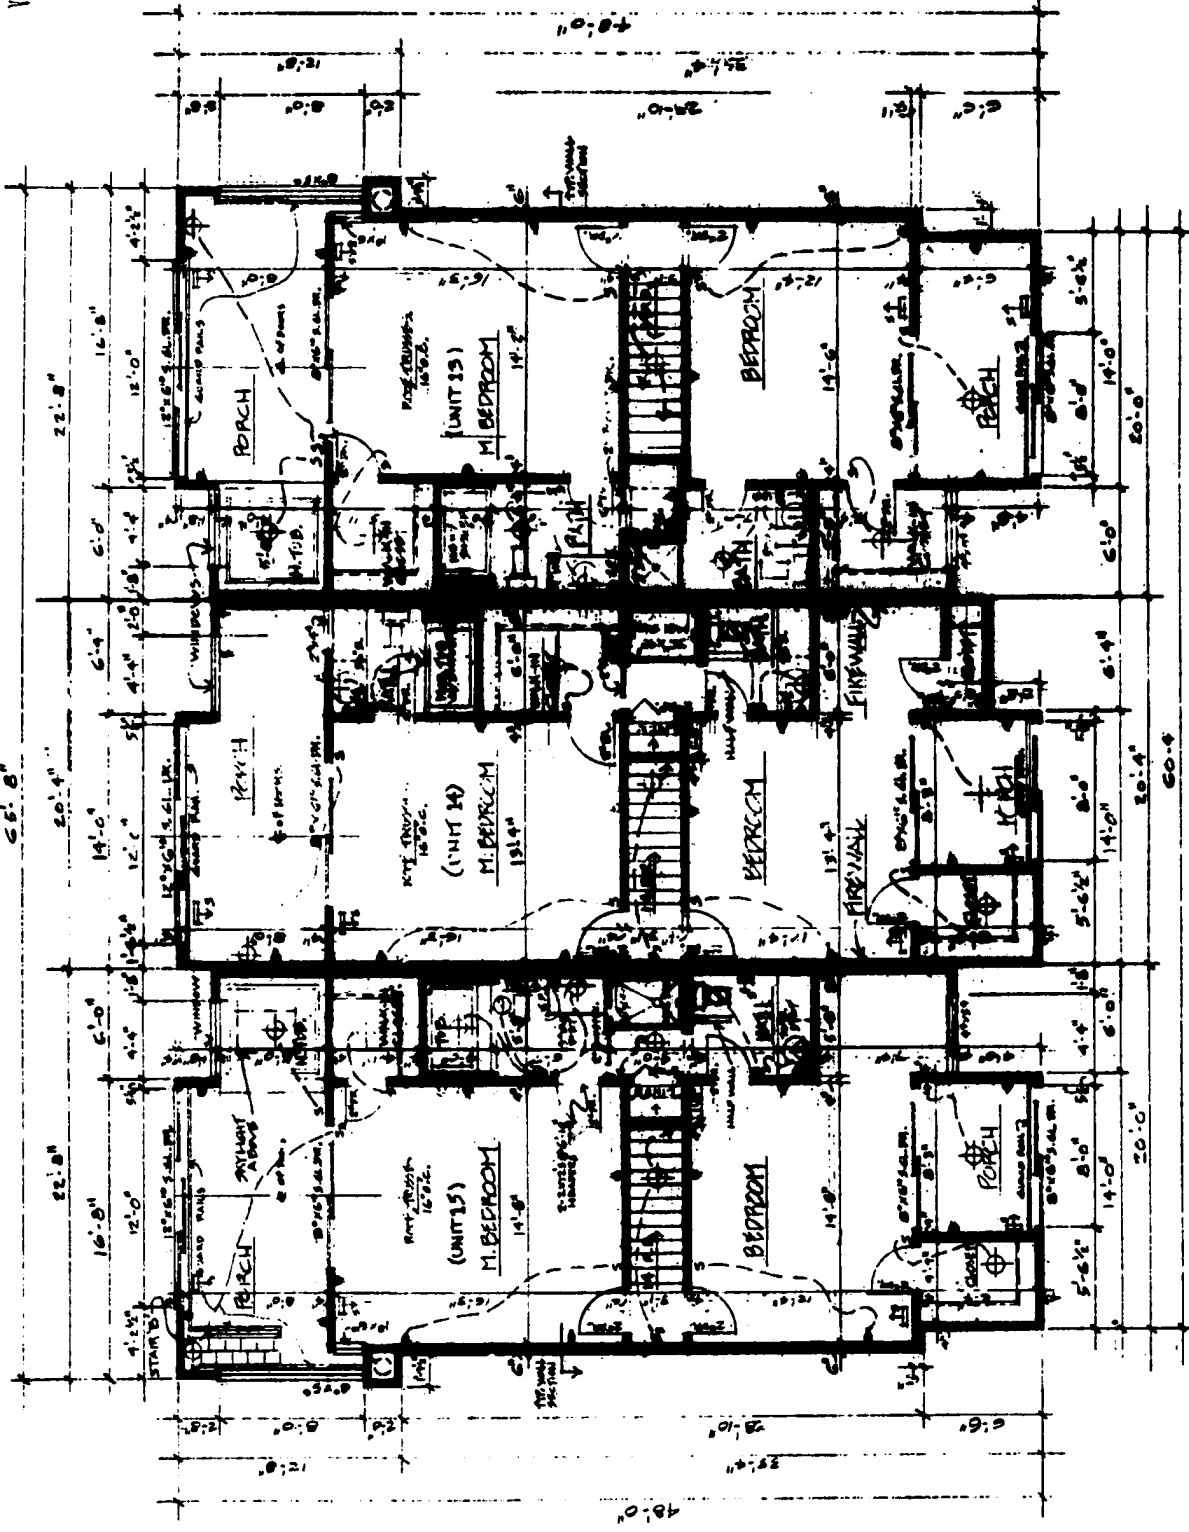

RECORD SET OF DRAWINGS
 SECOND FLOOR PLANS C.B.C. 4-10'

BLUE WATER CONDOMINIUMS

2022 WASH STATE BLVD LAKEVIEW, WARDENBURG, OHIO 43080

APPROVED FOR RECORDING BY THE
 OHIO DEPARTMENT OF REVENUE, 12/1/79

6-20-79 10:15 A-50016
 T. S. 1017 12/1/79

NOTES:
 1. CONSTRUCTION OF THIS SET SHALL BE IN ACCORDANCE WITH THE OHIO CONSTRUCTION CODE, AS AMENDED.
 2. ALL DIMENSIONS ARE TO FACE UNLESS OTHERWISE NOTED.