










20D 5

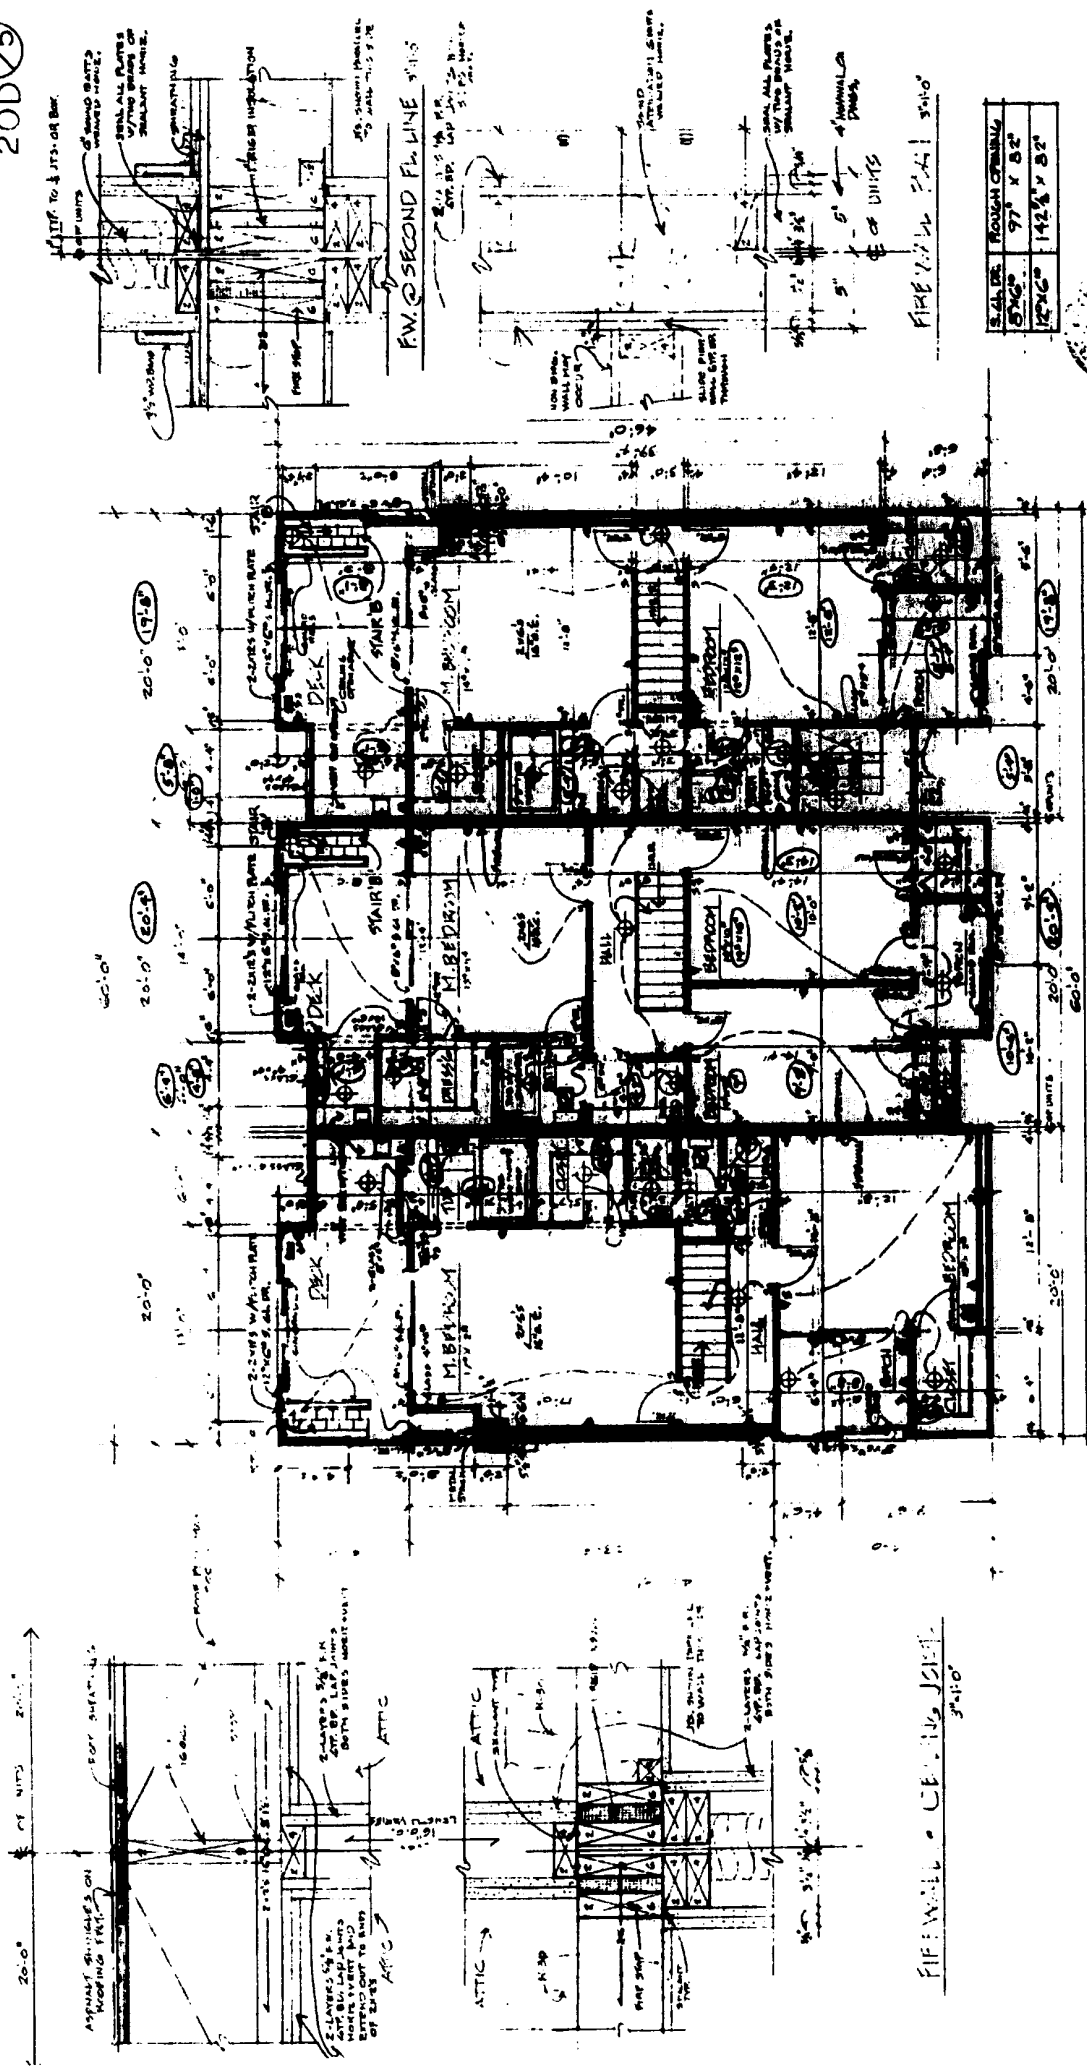

SECOND FLOOR LEVELS 1/4"=1'-0"

54 CONDOMINIUMS & DANBURY TROCH

NOTE: W.S. DIMENSIONS VARY FROM SHIFTS.  
ALL HEIGHTS SHALL BE 2-1/2" MIN.

Revised Aug 23, 1988  
Revised Aug 30, 1988  
Final 20 D 5  
William R. Leonard, Designer  
# 76379

GARBER'S  
PRINTING SPECIALTIES - OFFICE FURNITURE  
23 SANDUSKY BELLEVUE, OHIO 44804  
TEL. 419-885-1111

ARCHITECT FREDERICK F. LEONARD  
19301 LORAIN ROAD FAIRVIEW PARK, OHIO 44130  
REVISED 20D 5  
JOHN R. CONDO DOCUMENTS 1-216-356-1122

NOTE: DIMENSIONS THAT ARE DIFFERENT FROM ORIGINAL DIMENSIONS ARE CORRECTED.