




INITIAL DECLARATION:
 S.O.S. STORAGE GARAGE CONDOMINIUM
 PART OF THE LOT 14, SEC. 4, FIRELANDS SURVEY
 DANBURY TOWNSHIP, OTTAWA COUNTY, OHIO
 2010

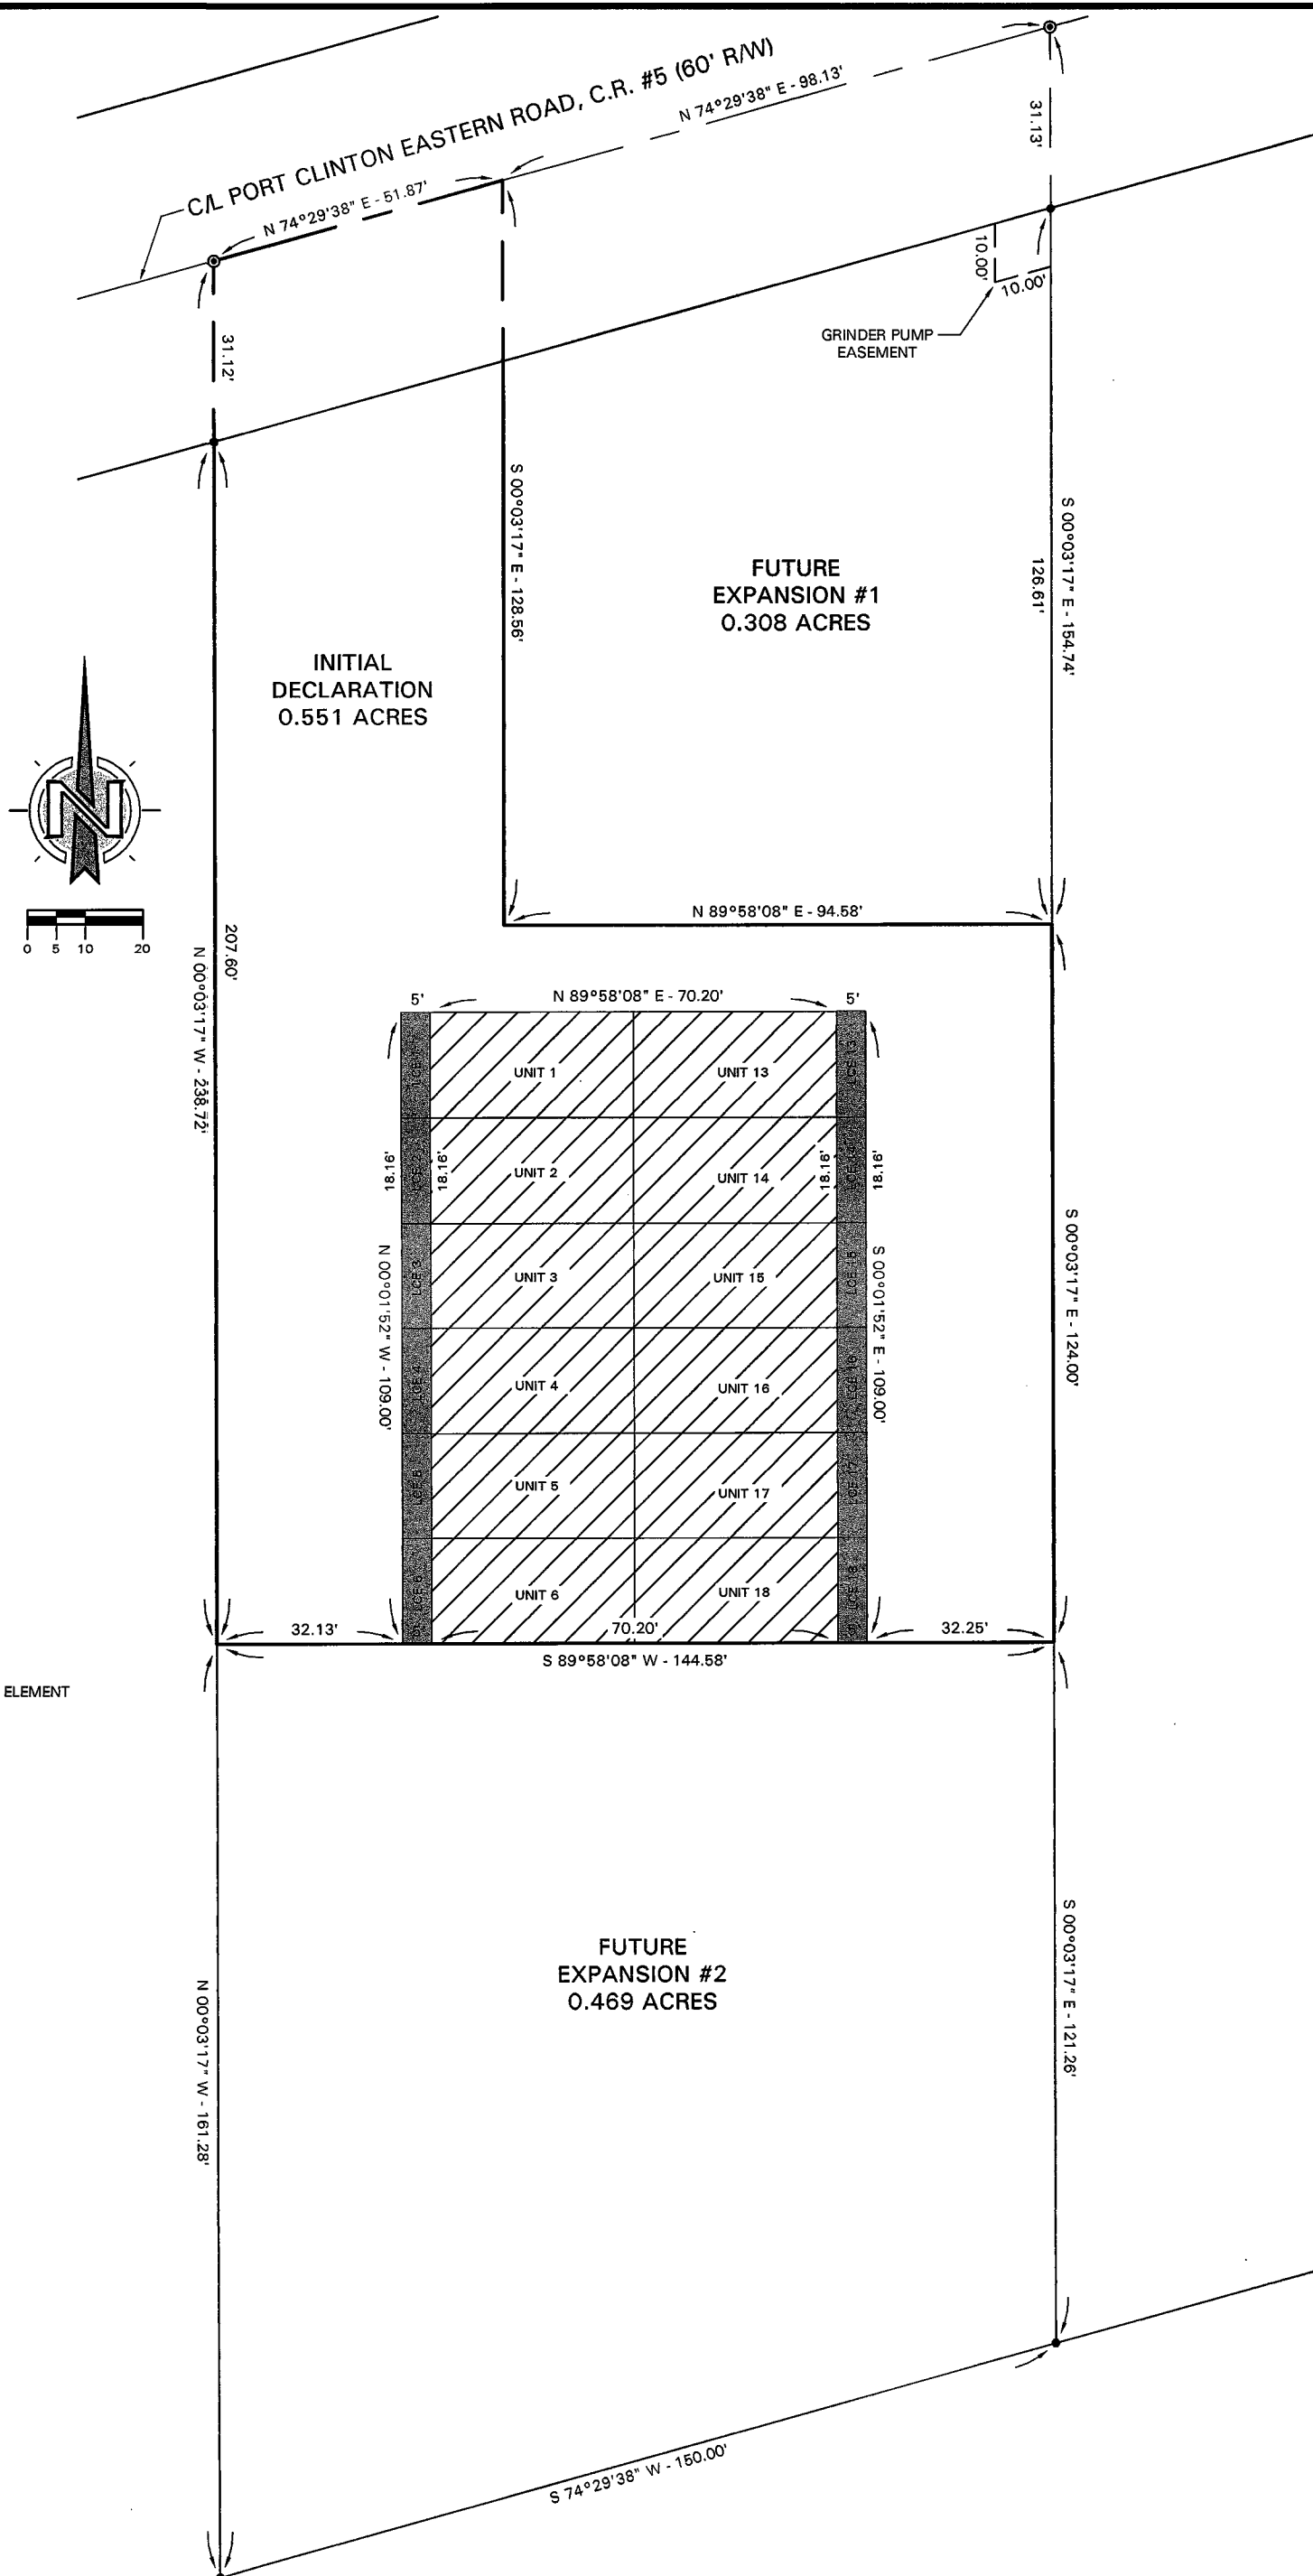

LEGEND
 = UNIT
 = L.C.E. LIMITED COMMON ELEMENT
 = COMMON ELEMENT

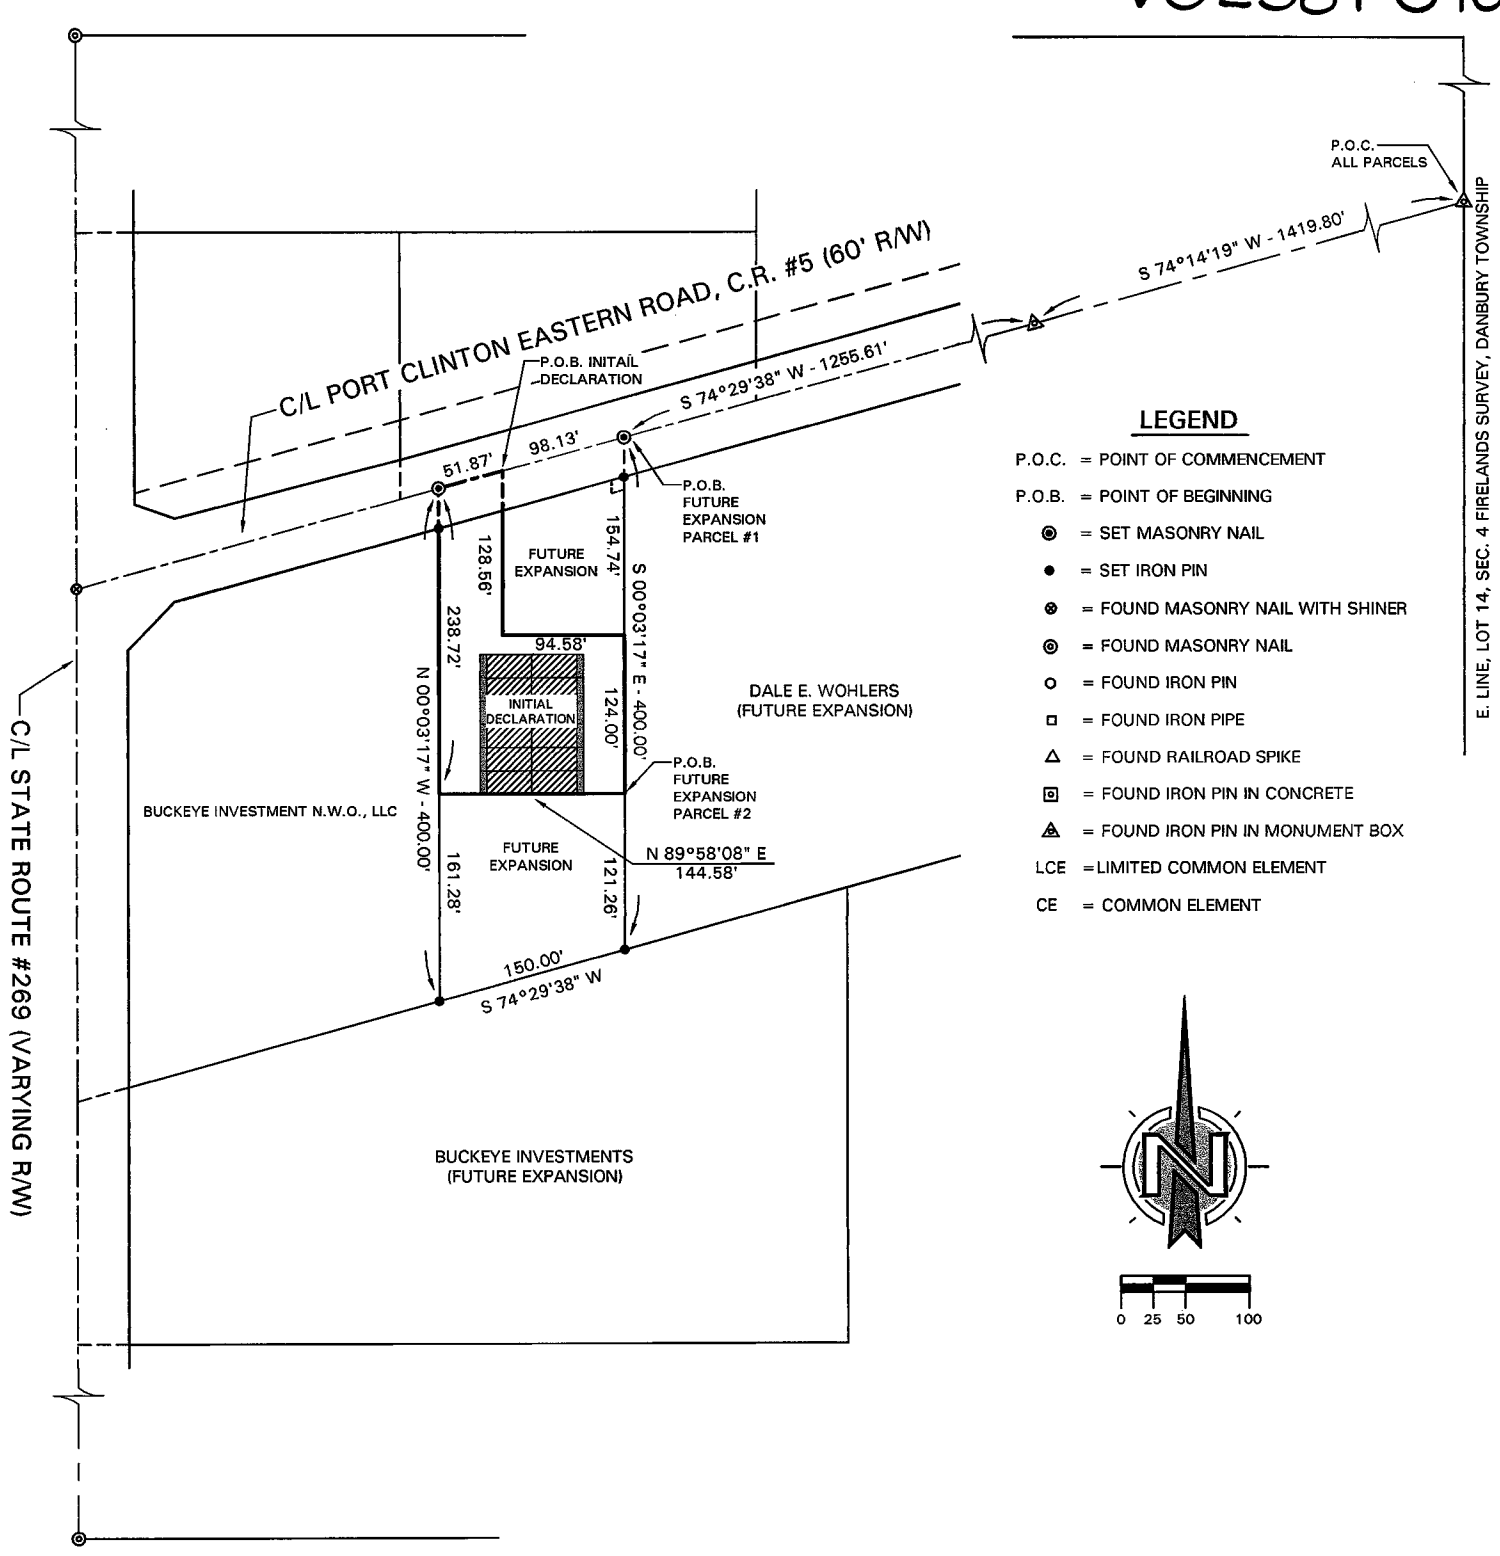


LEGEND
 P.O.C. = POINT OF COMMENCEMENT
 P.O.B. = POINT OF BEGINNING
 ● = SET MASONRY NAIL
 ● = SET IRON PIN
 ● = FOUND MASONRY NAIL WITH SHINER
 ● = FOUND MASONRY NAIL
 ○ = FOUND IRON PIN
 □ = FOUND IRON PIPE
 △ = FOUND RAILROAD SPIKE
 □ = FOUND IRON PIN IN CONCRETE
 ▲ = FOUND IRON PIN IN MONUMENT BOX
 LCE = LIMITED COMMON ELEMENT
 CE = COMMON ELEMENT

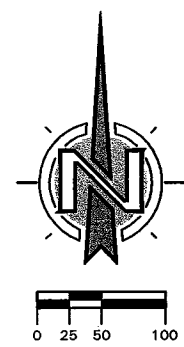

201000201611
 RECEIVED FOR RECORD 3/25/2010
 TIME 10:22am FEE \$312.80
 VOL 58 PG 16-19
 Virginia M. Park, Recorder
 VIRGINIA PARK, RECORDER OTTAWA COUNTY, OHIO

I HEREBY CERTIFY THAT THE DRAWING ACCURATELY SHOWS EACH BUILDING AS BUILT OR CONSTRUCTED
 Kenneth P. Schoenfeld
 KENNETH P. SCHOENFELD, ARCHITECT #9539
 3-16-10
 DATE

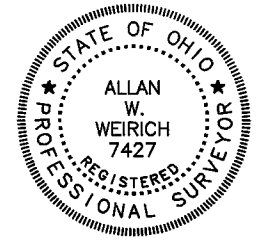

I HEREBY CERTIFY THAT THE DRAWING ACCURATELY REFLECTS THE LOCATION OF IMPROVEMENTS AND RECORDED EASEMENTS.
 Allan W. Weirich
 ALLAN W. WEIRICH, P.S. #7427
 OHIO PROFESSIONAL SURVEYOR
 3-16-10
 DATE