

SCALE: 1"=20'


**VOL 69 PG 35**

**LEGEND**

- MONUMENT FOUND
- MONUMENT SET
- (C) CALCULATED DISTANCE
- (M) MEASURED DISTANCE
- (REC) RECORD DISTANCE
- R/W RIGHT-OF-WAY
- P.O.B. POINT OF BEGINNING
- P.O.C. POINT OF COMMENCEMENT
- ▨ UNITS
- ▨ LIMITED COMMON ELEMENT
- FENCE

**REFERENCES**

- DEEDS AS SHOWN.
- SAFE HARBOR STORAGE CONDOMINIUM FIRST AMENDMENT, PLAT VOLUME 62, PAGE 24.
- SAFE HARBOR STORAGE CONDOMINIUM, PLAT VOLUME 60, PAGE 17.
- SAFE HARBOR STORAGE CONDOMINIUM THIRD AMENDMENT, PLAT VOLUME 63, PAGE 48.
- SAFE HARBOR STORAGE CONDOMINIUM FOURTH AMENDMENT, PLAT VOLUME 64, PAGE 29.
- SAFE HARBOR STORAGE CONDOMINIUM FIFTH AMENDMENT, PLAT VOLUME 65, PAGE 2.
- SAFE HARBOR STORAGE CONDOMINIUM SIXTH AMENDMENT, PLAT VOLUME 66, PAGE 17.
- SAFE HARBOR STORAGE CONDOMINIUM SEVENTH AMENDMENT, PLAT VOLUME 67, PAGE 36.
- SAFE HARBOR STORAGE CONDOMINIUM EIGHTH AMENDMENT, PLAT VOLUME 67, PAGE 50.

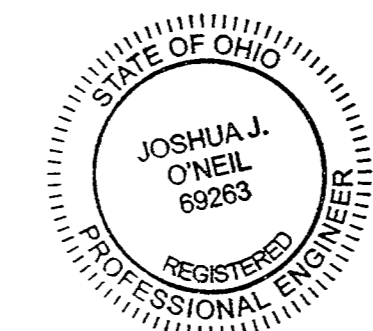


ENGINEER'S CERTIFICATION:  
I HEREBY DECLARE THAT THE DRAWING ACCURATELY SHOWS EACH BUILDING AS BUILT TO THE BEST OF MY KNOWLEDGE AND BELIEF.  
*Joshua J. O'Neil*  
JOSHUA J. O'NEIL, P.E.  
OHIO PROFESSIONAL ENGINEER NO. 69263  
DATE: 10-16-2019



SURVEYOR'S CERTIFICATION:  
I HEREBY DECLARE THAT THE DRAWING ACCURATELY REFLECTS THE LOCATION OF IMPROVEMENTS AND RECORDED EASEMENTS TO THE BEST OF MY KNOWLEDGE AND BELIEF.  
*Peter J. Segard*  
PETER J. SEGARD, P.S.  
OHIO PROFESSIONAL SURVEYOR NO. 7883  
DATE: 10-16-2019

Document # 289139 Vol. 69 PG 35 - 38  
Date October 17, 2019 Time 11:43 p.m.  
Fee \$307.20  
*Virginia M. Park*  
Virginia M. Park  
Recorder, Ottawa County Ohio

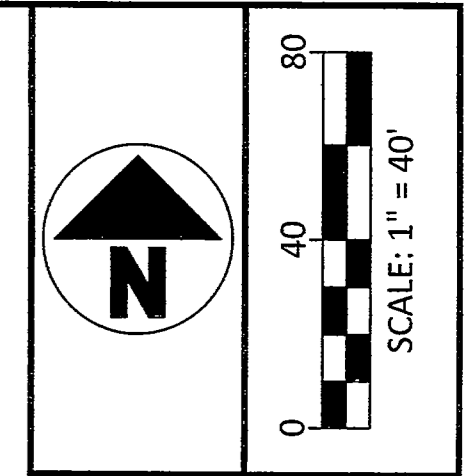

NO	REVISION	DATE
1	ADDED D-23-1 AND D-24-1 PER CLIENT CHANGE	10-16-19
2	CORRECTED HATCH FOR D-17-I, D-18-I, D-23-1, D-24-1	10-16-19
3		
4		
5		
6		
7		
8		
9		

**SAFE HARBOR STORAGE CONDOMINIUM TWELFTH AMENDMENT**  
LOCATED IN PART OF LOT 03, SECTION 04, DANBURY TOWNSHIP, OTTAWA COUNTY, OHIO.

FILE:	SH TWELFTH
JOB NO.:	15080
DRAWN BY:	KEY
ISSUED:	10/02/2019
<b>1/4</b>	

PLOTTED: Oct 16, 2019 - 12:04pm  
DRAWING: M:\19082 (Safe Harbor - 19 General Services Agreement)\Safe Harbor Condominium (SURVEY)\Dwg\22x34 Safe Harbor Condominiums TWELFTH Amendment.dwg: PAGES





