
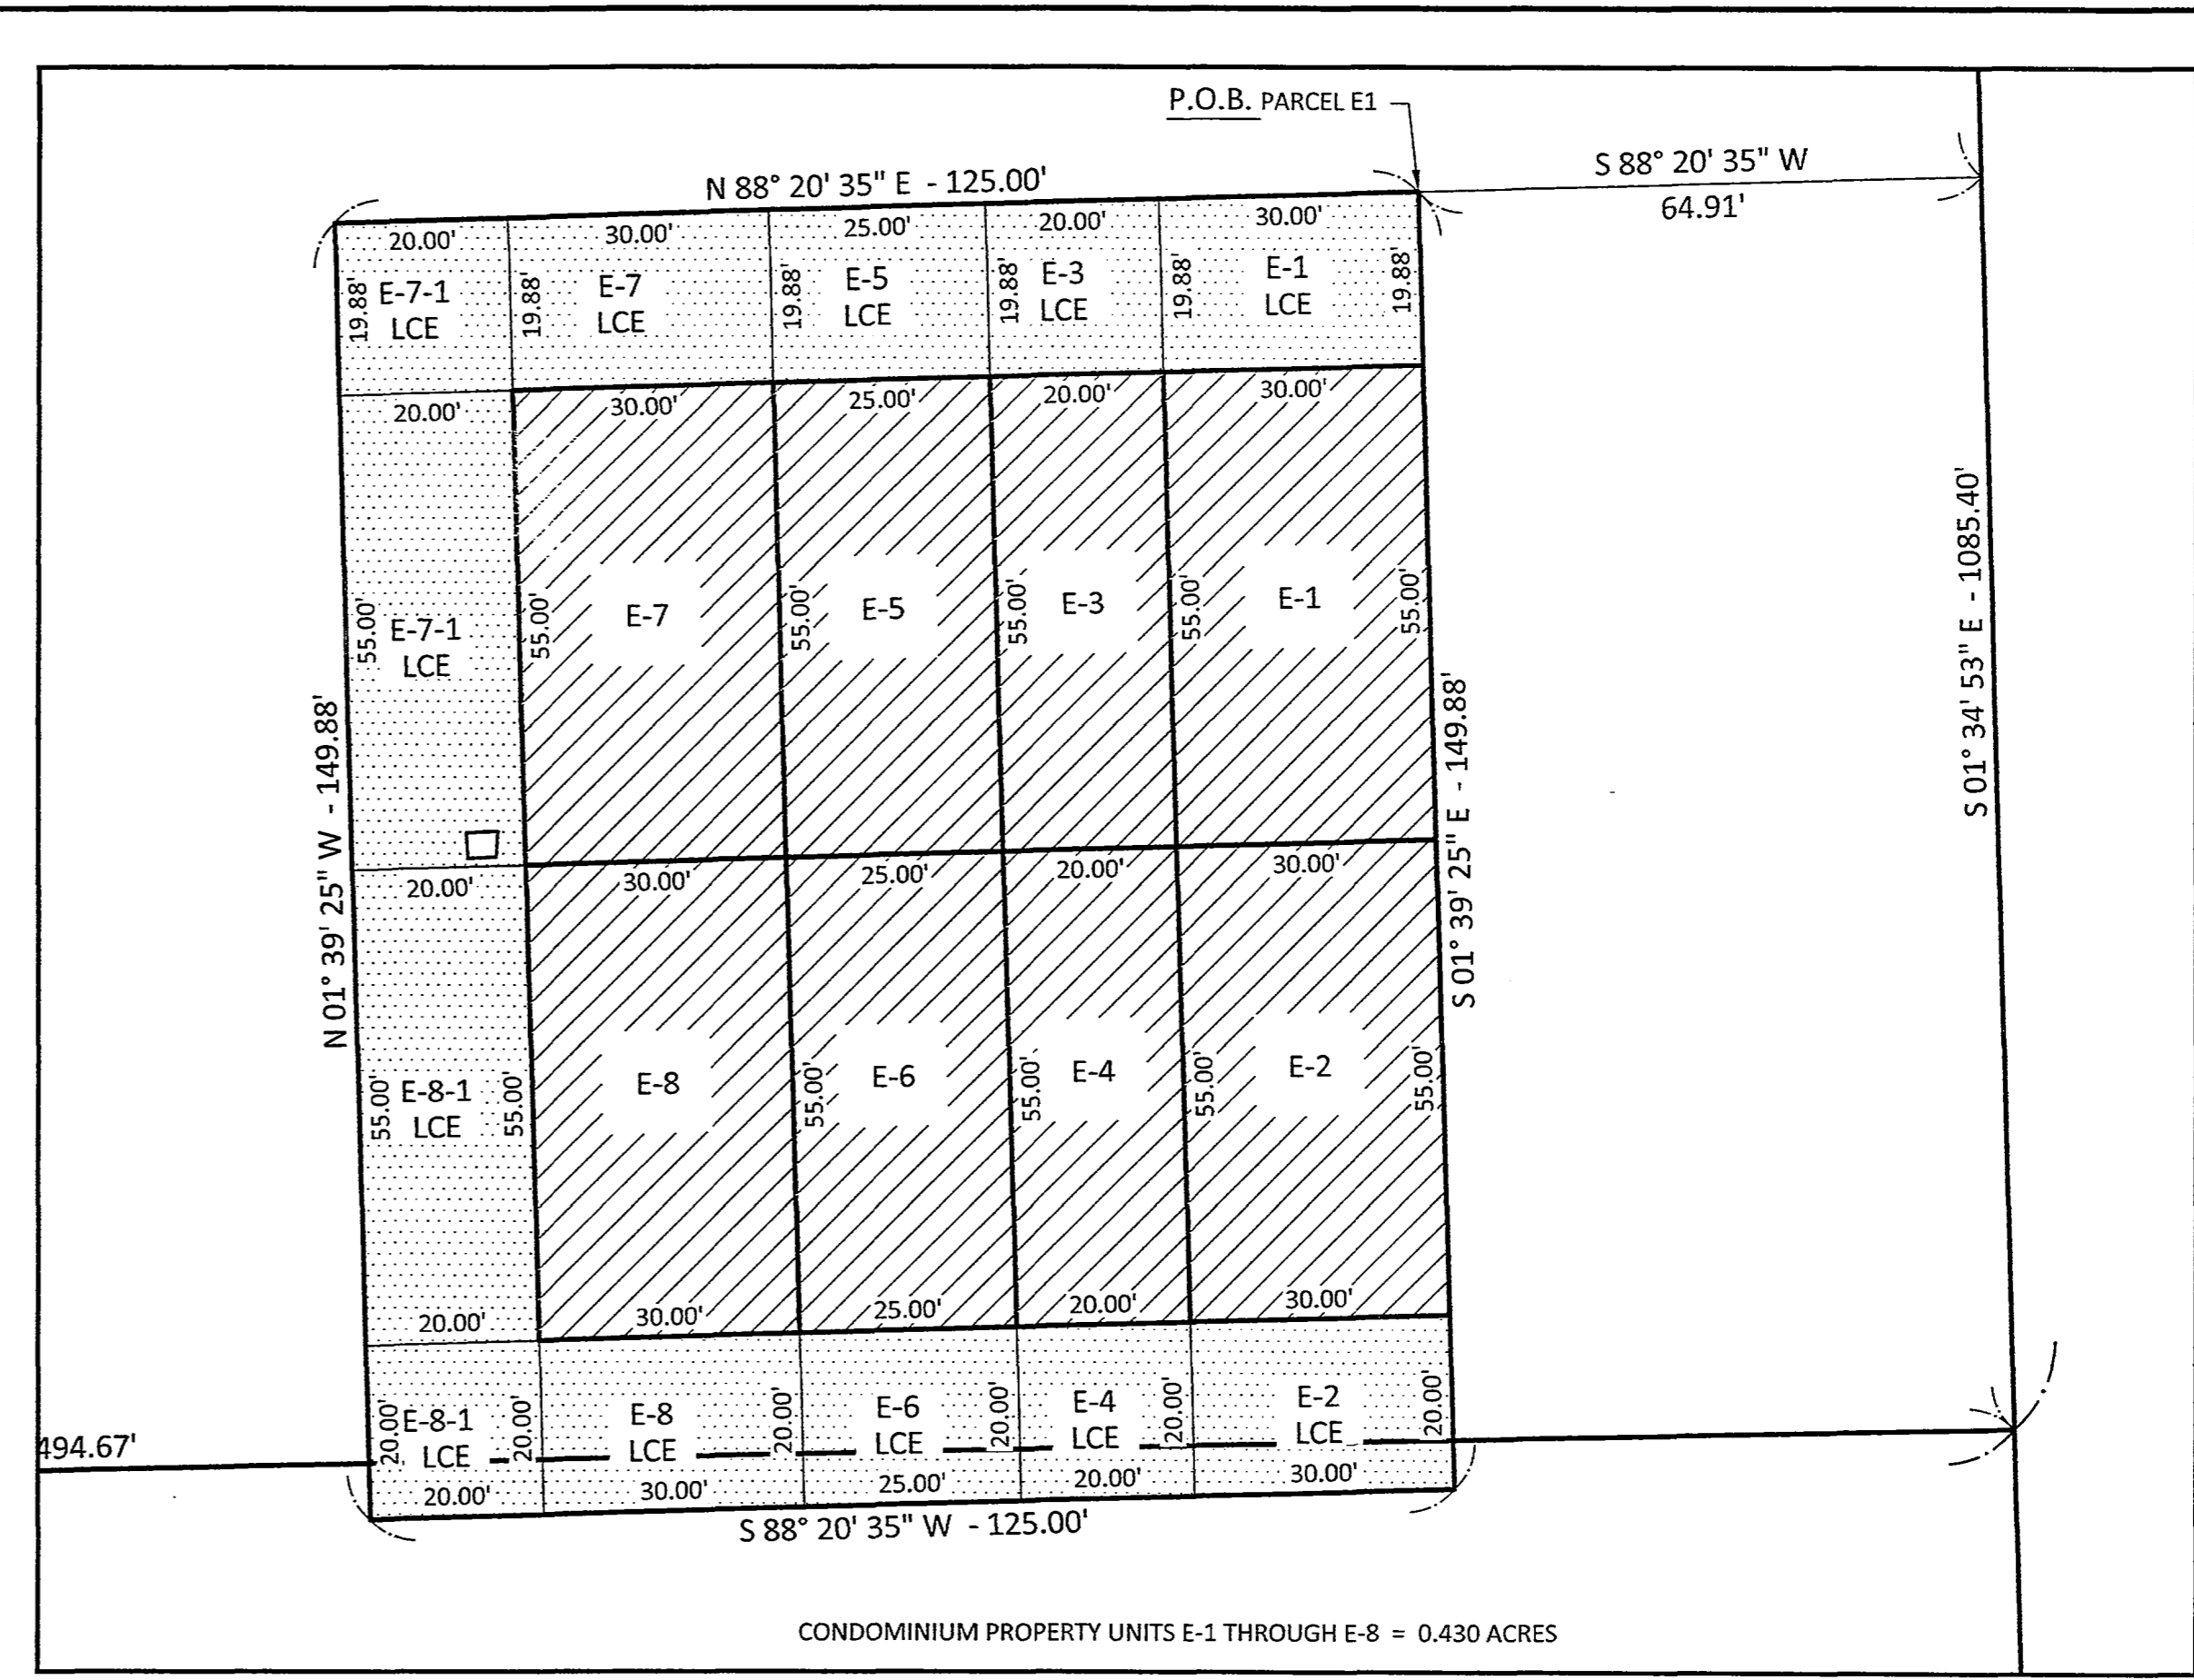


PLOTTED: Sep 21, 2020 - 1:35pm  
 DRAWING: M:\19082 (Safe Harbor - Condominium Thirteenth Amendment).dwg - PAGE1

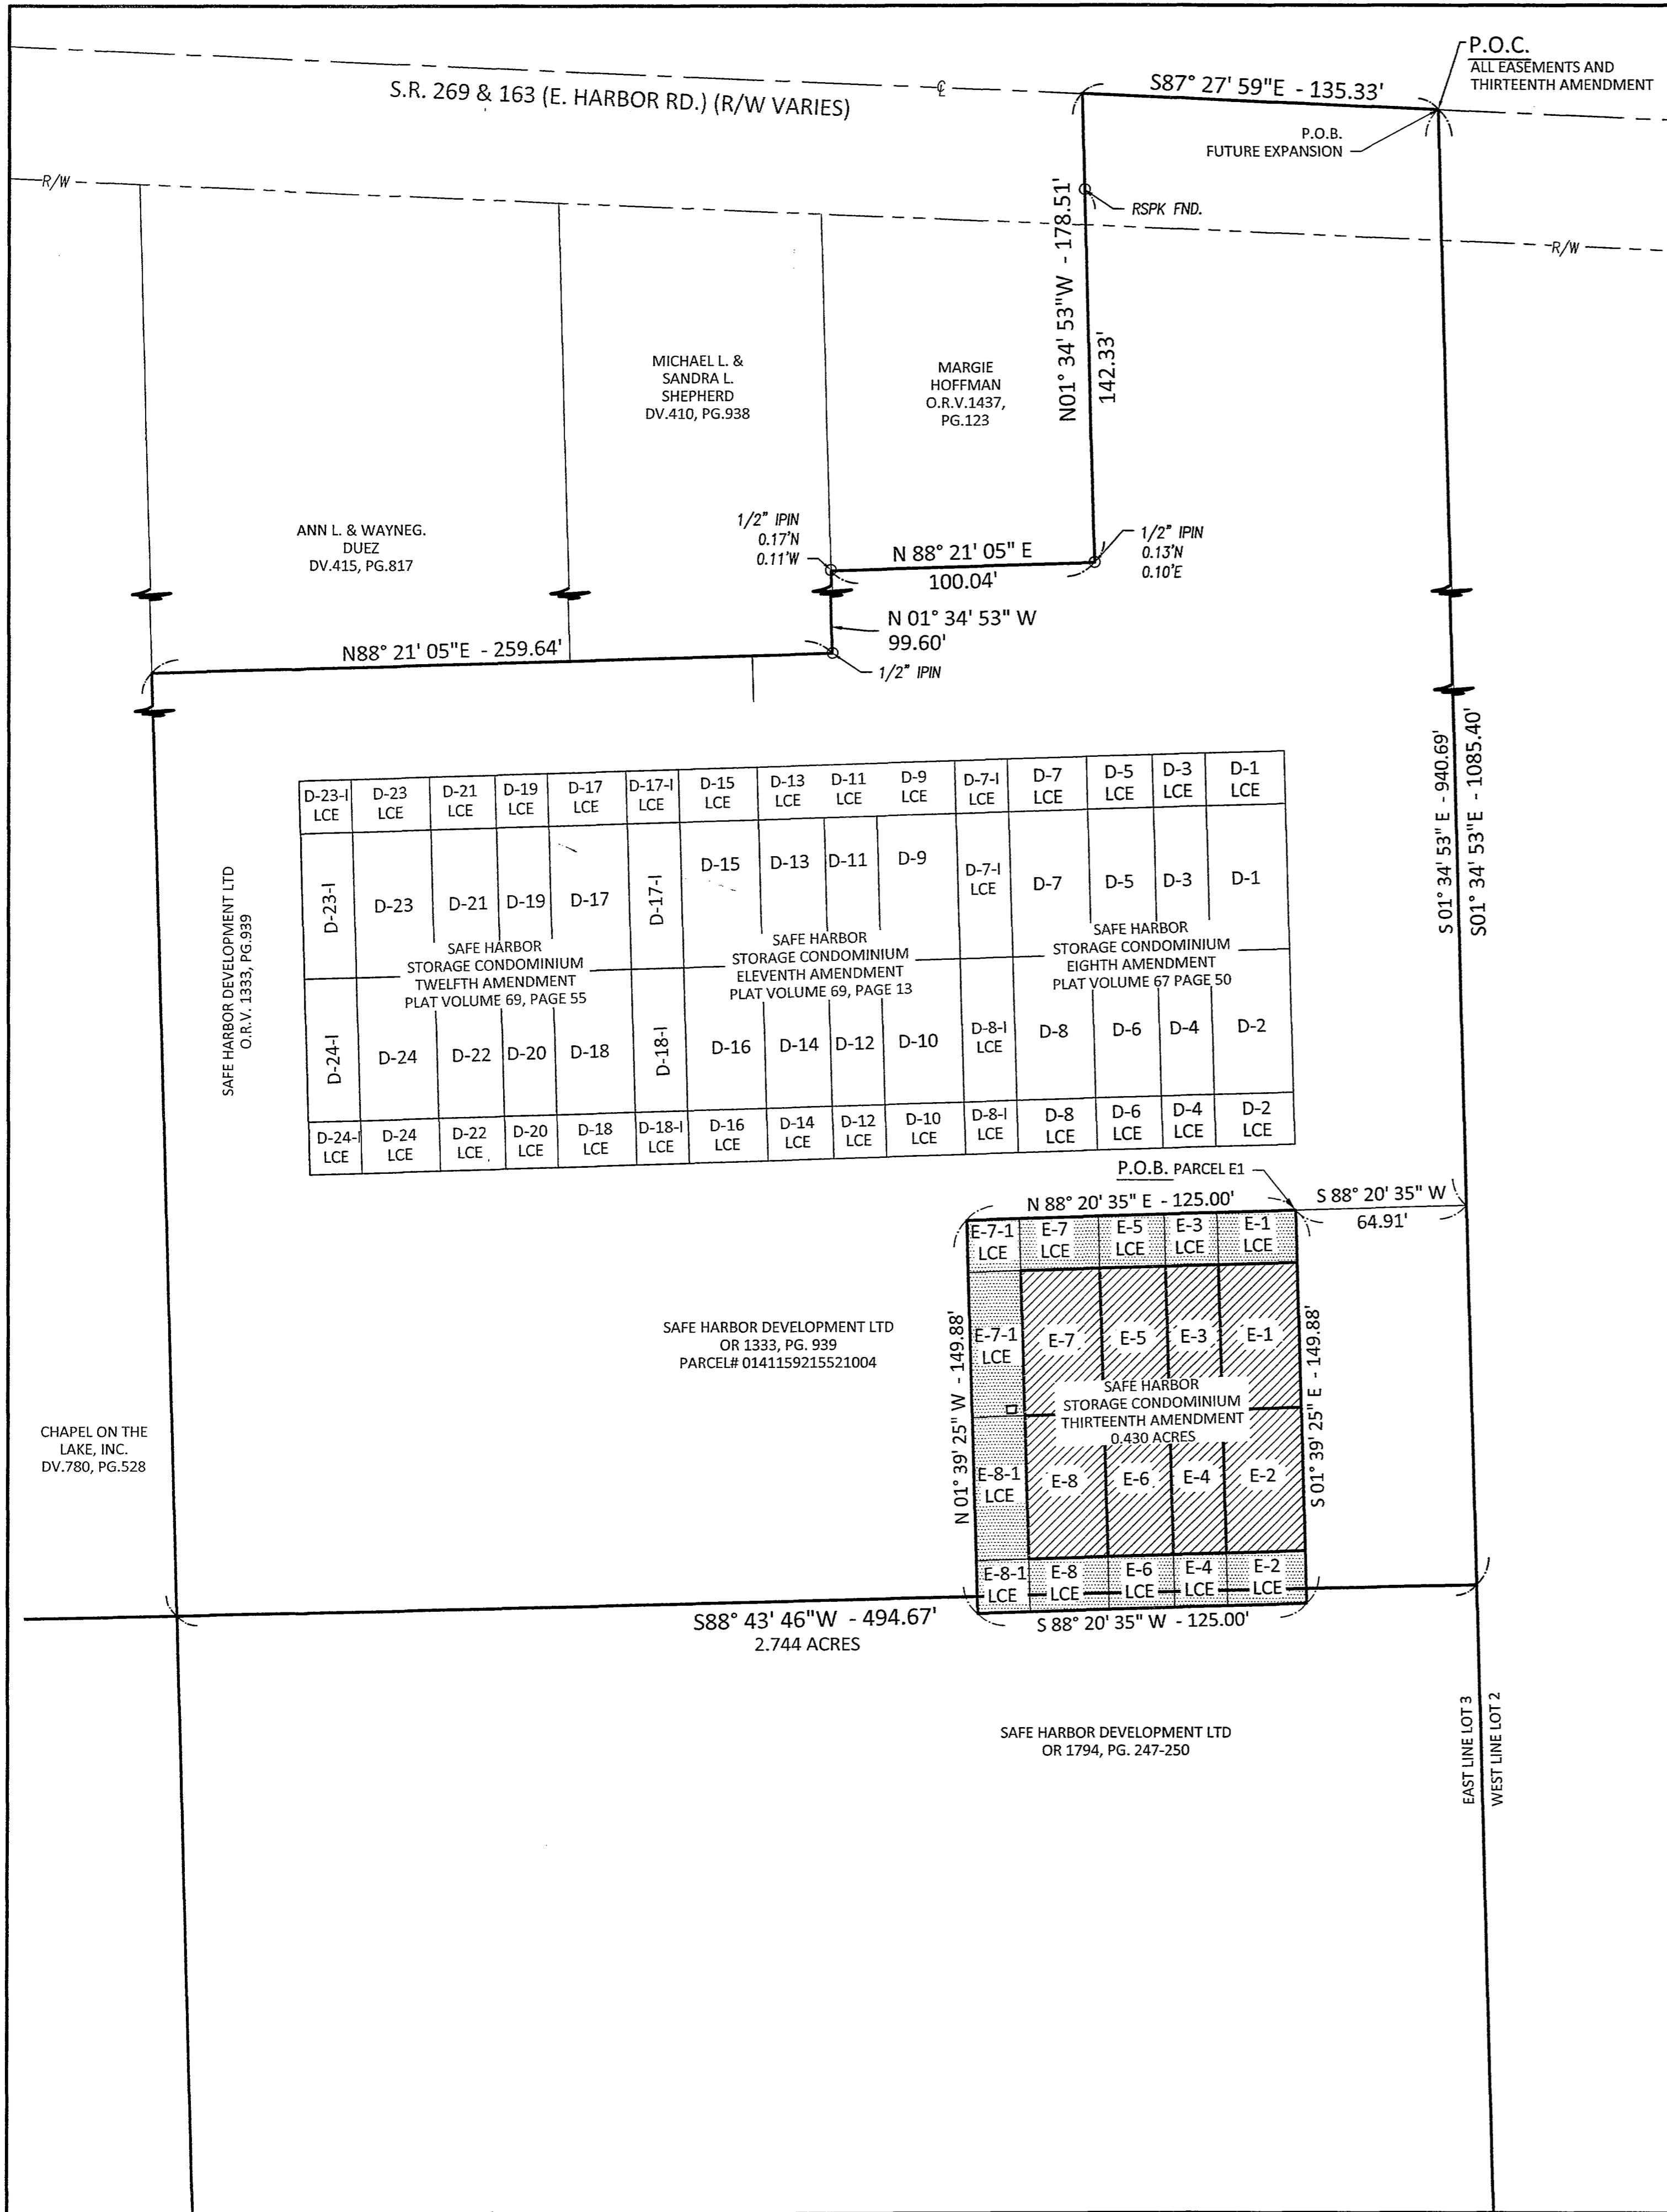


Document # 298887 Vol. 70 PG 47-50  
 Date 9-22-2020 Time 2:05 p.m.  
 Fee \$268.80  
*Virginia M. Park*  
 Virginia M. Park  
 Recorder, Ottawa County Ohio

# THIRTEENTH AMENDMENT

- LEGEND**
- MONUMENT FOUND
  - MONUMENT SET
  - (C) CALCULATED DISTANCE
  - (M) MEASURED DISTANCE
  - (REC) RECORD DISTANCE
  - R/W RIGHT-OF-WAY
  - P.O.B. POINT OF BEGINNING
  - P.O.C. POINT OF COMMENCEMENT
  - ▨ UNITS
  - ▩ LIMITED COMMON ELEMENT
  - FENCE

**REFERENCES**

- DEEDS AS SHOWN.
- SAFE HARBOR STORAGE CONDOMINIUM FIRST AMENDMENT, PLAT VOLUME 62, PAGE 24.
  - SAFE HARBOR STORAGE CONDOMINIUM, PLAT VOLUME 60, PAGE 17.
  - SAFE HARBOR STORAGE CONDOMINIUM THIRD AMENDMENT, PLAT VOLUME 63, PAGE 48.
  - SAFE HARBOR STORAGE CONDOMINIUM FOURTH AMENDMENT, PLAT VOLUME 64, PAGE 29.
  - SAFE HARBOR STORAGE CONDOMINIUM FIFTH AMENDMENT, PLAT VOLUME 65, PAGE 2.
  - SAFE HARBOR STORAGE CONDOMINIUM SIXTH AMENDMENT, PLAT VOLUME 66, PAGE 17.
  - SAFE HARBOR STORAGE CONDOMINIUM SEVENTH AMENDMENT, PLAT VOLUME 67, PAGE 36.
  - SAFE HARBOR STORAGE CONDOMINIUM EIGHTH AMENDMENT, PLAT VOLUME 67, PAGE 50.
  - SAFE HARBOR STORAGE CONDOMINIUM ELEVENTH AMENDMENT, PLAT VOLUME 69, PAGE 13.
  - SAFE HARBOR STORAGE CONDOMINIUM TWELFTH AMENDMENT, PLAT VOLUME 69, PAGE 55.

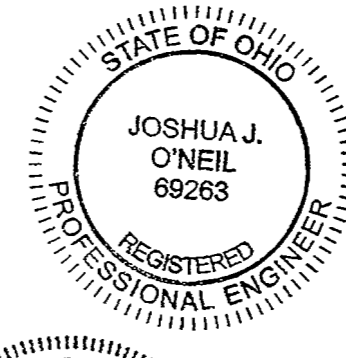

**ENGINEER'S CERTIFICATION:**  
 I HEREBY DECLARE THAT THE DRAWING ACCURATELY SHOWS EACH BUILDING AS BUILT TO THE BEST OF MY KNOWLEDGE AND BELIEF.

*Joshua J. O'Neil*  
 JOSHUA J. O'NEIL, P.E.  
 OHIO PROFESSIONAL ENGINEER NO. 69263

DATE: 9.21.2020



**SURVEYOR'S CERTIFICATION:**  
 I HEREBY DECLARE THAT THE DRAWING ACCURATELY REFLECTS THE LOCATION OF IMPROVEMENTS AND RECORDED EASEMENTS TO THE BEST OF MY KNOWLEDGE AND BELIEF.

*Peter J. Segard*  
 PETER J. SEGARD, P.S.  
 OHIO PROFESSIONAL SURVEYOR NO. 7883

DATE: 9.21.2020

NO.	REVISION	DATE
9		
8		
7		
6		
5		
4		
3		
2		
1		

DGL CONSULTING ENGINEERS, LLC  
 3455 BRIARFIELD BLVD., SUITE E  
 MAJUMBE, OH 43037  
 PHONE: 419-535-1015  
 www.dgl-ohio.com


**SAFE HARBOR STORAGE CONDOMINIUM THIRTEENTH AMENDMENT**

LOCATED IN PART OF LOT 03, SECTION 04, DANBURY TOWNSHIP, OTTAWA COUNTY, OHIO.


FILE:	THIRTEENTH
JOB NO.:	19082
DRAWN BY:	KEY
ISSUED:	08/20/2020

1/4

PLOTTED: Sep 21, 2020 - 9:16am  
 DRAWING: M:\19082 (Safe Harbor - 19 General Services Agreement)\Safe Harbor Condominium\Survey\22x34 Safe Harbor Condominium Thirteenth Amendment.dwg PAGEZ

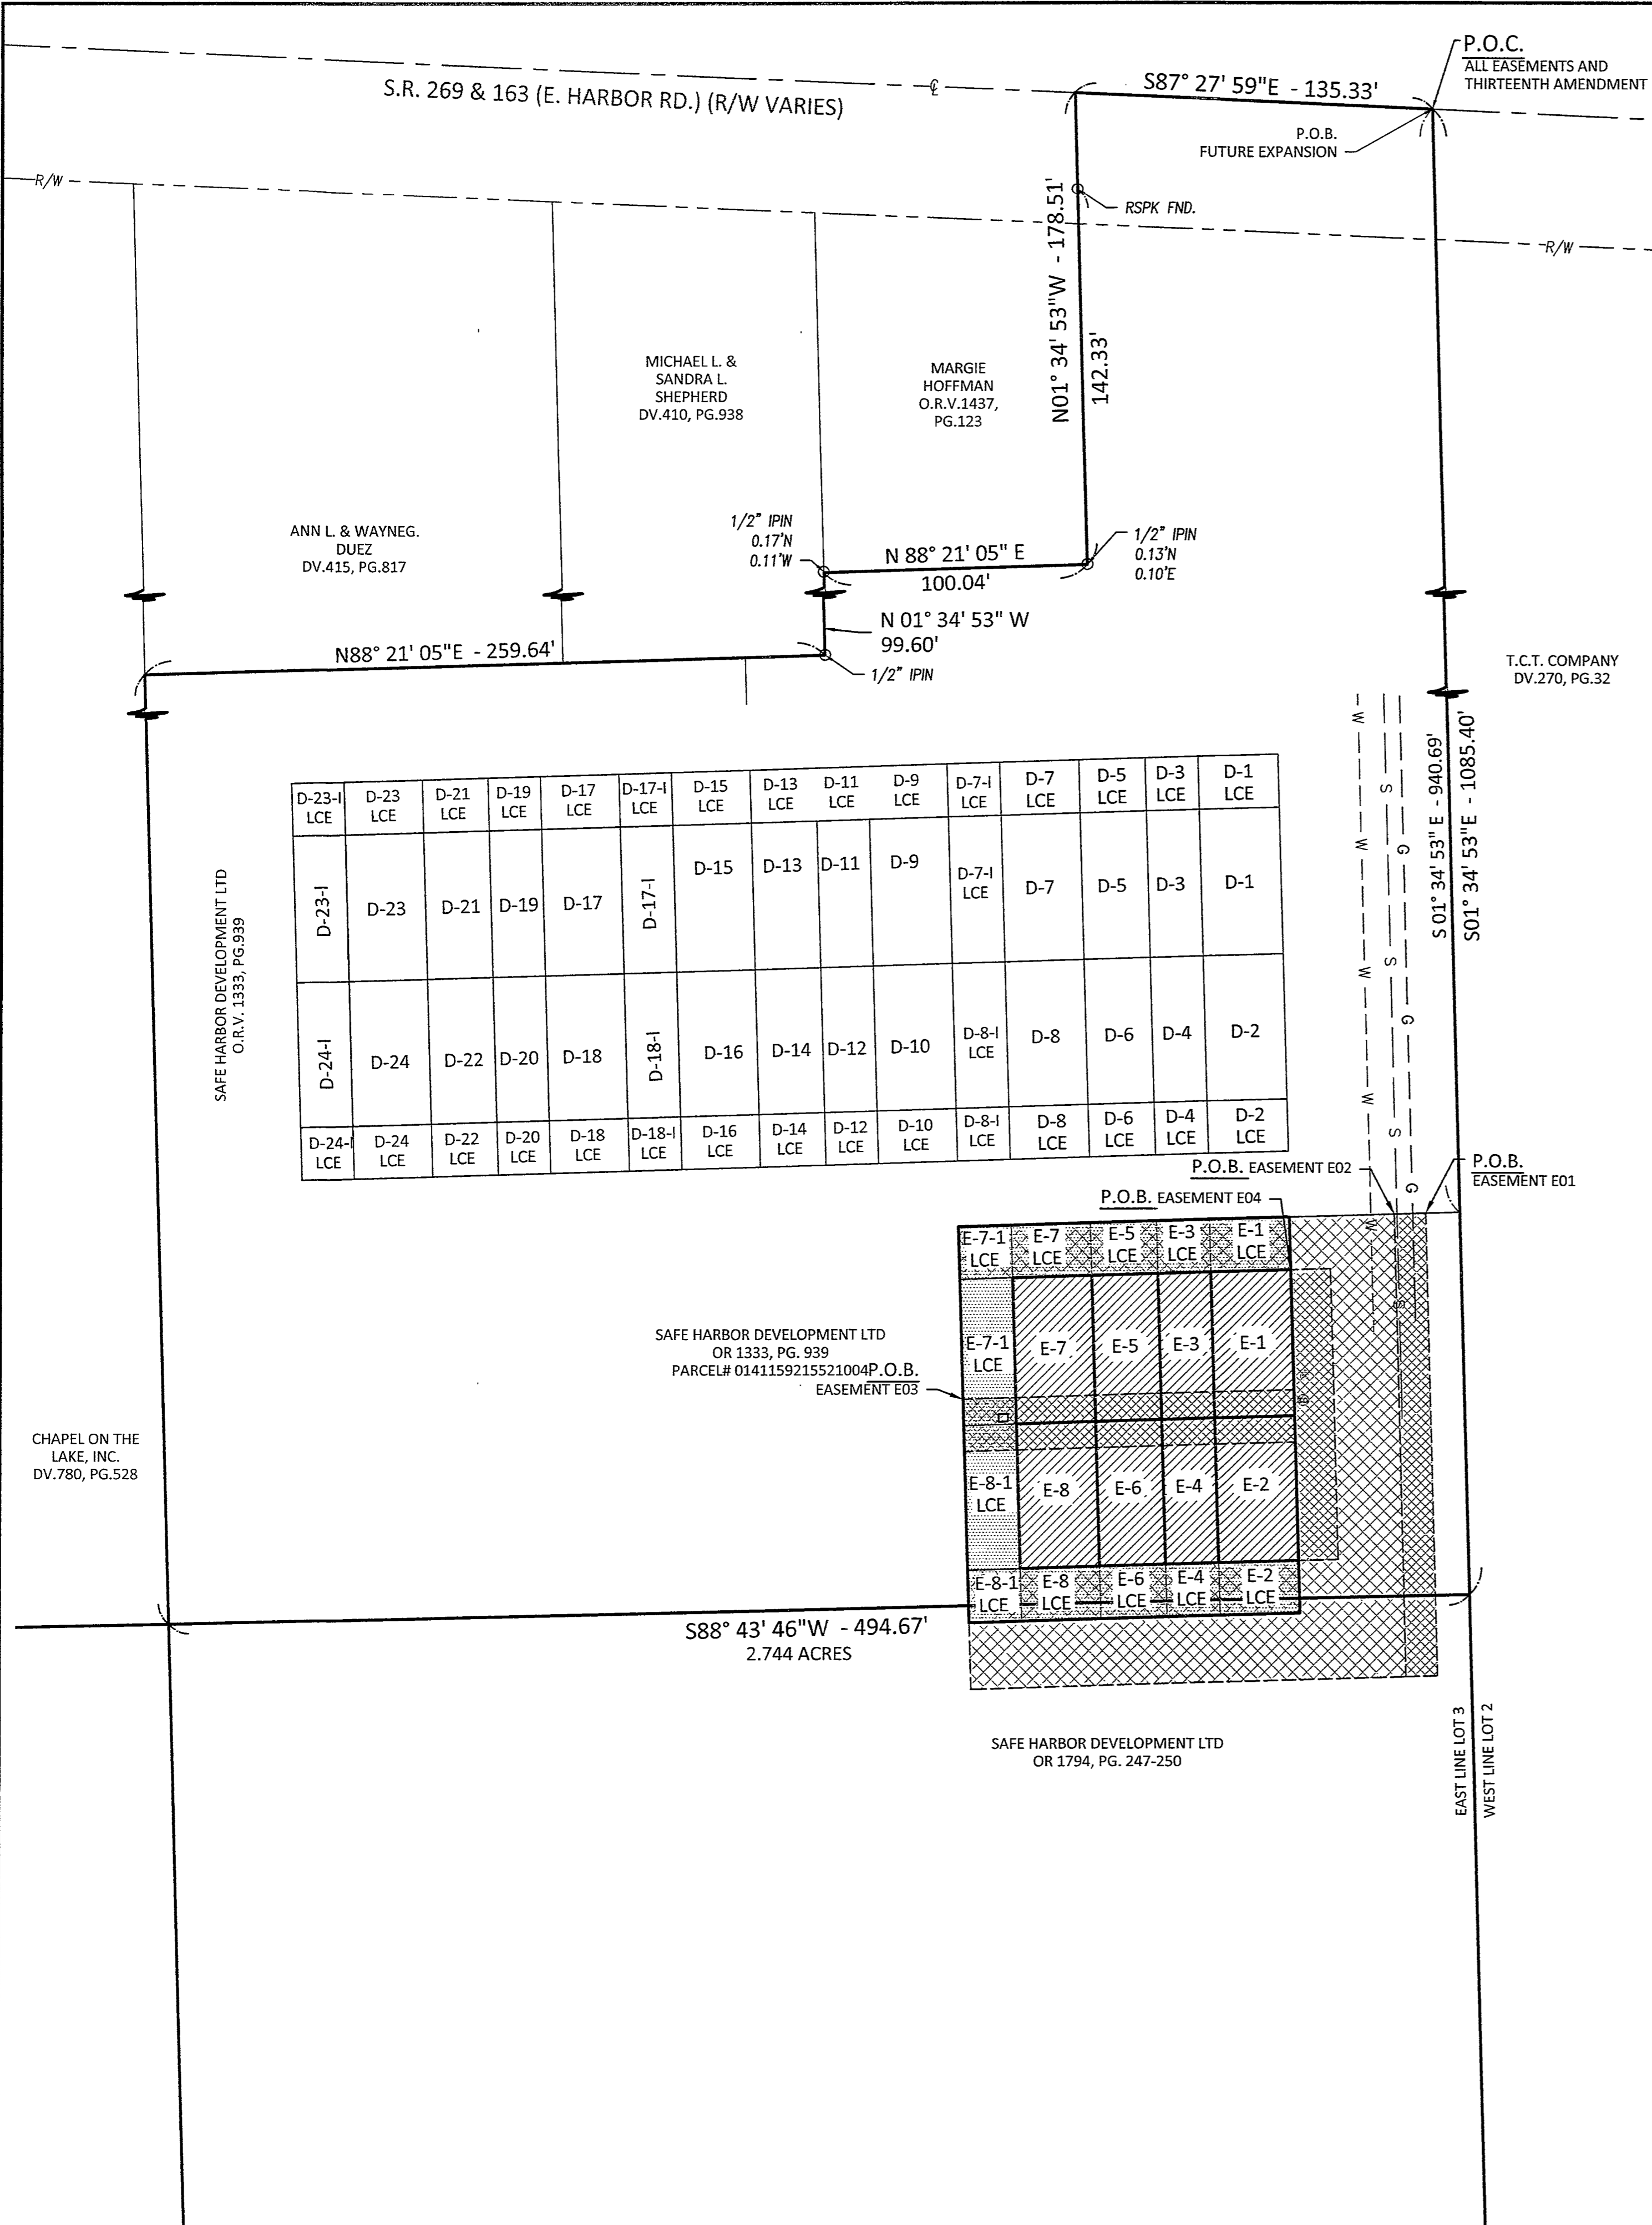

D-23-I LCE	D-23 LCE	D-21 LCE	D-19 LCE	D-17 LCE	D-17-I LCE	D-15 LCE	D-13 LCE	D-11 LCE	D-9 LCE	D-7-I LCE	D-7 LCE	D-5 LCE	D-3 LCE	D-1 LCE
D-24-I LCE	D-24 LCE	D-22 LCE	D-20 LCE	D-18 LCE	D-18-I LCE	D-16 LCE	D-14 LCE	D-12 LCE	D-10 LCE	D-8-I LCE	D-8 LCE	D-6 LCE	D-4 LCE	D-2 LCE
D-24-LCE	D-24 LCE	D-22 LCE	D-20 LCE	D-18 LCE	D-18-I LCE	D-16 LCE	D-14 LCE	D-12 LCE	D-10 LCE	D-8-I LCE	D-8 LCE	D-6 LCE	D-4 LCE	D-2 LCE

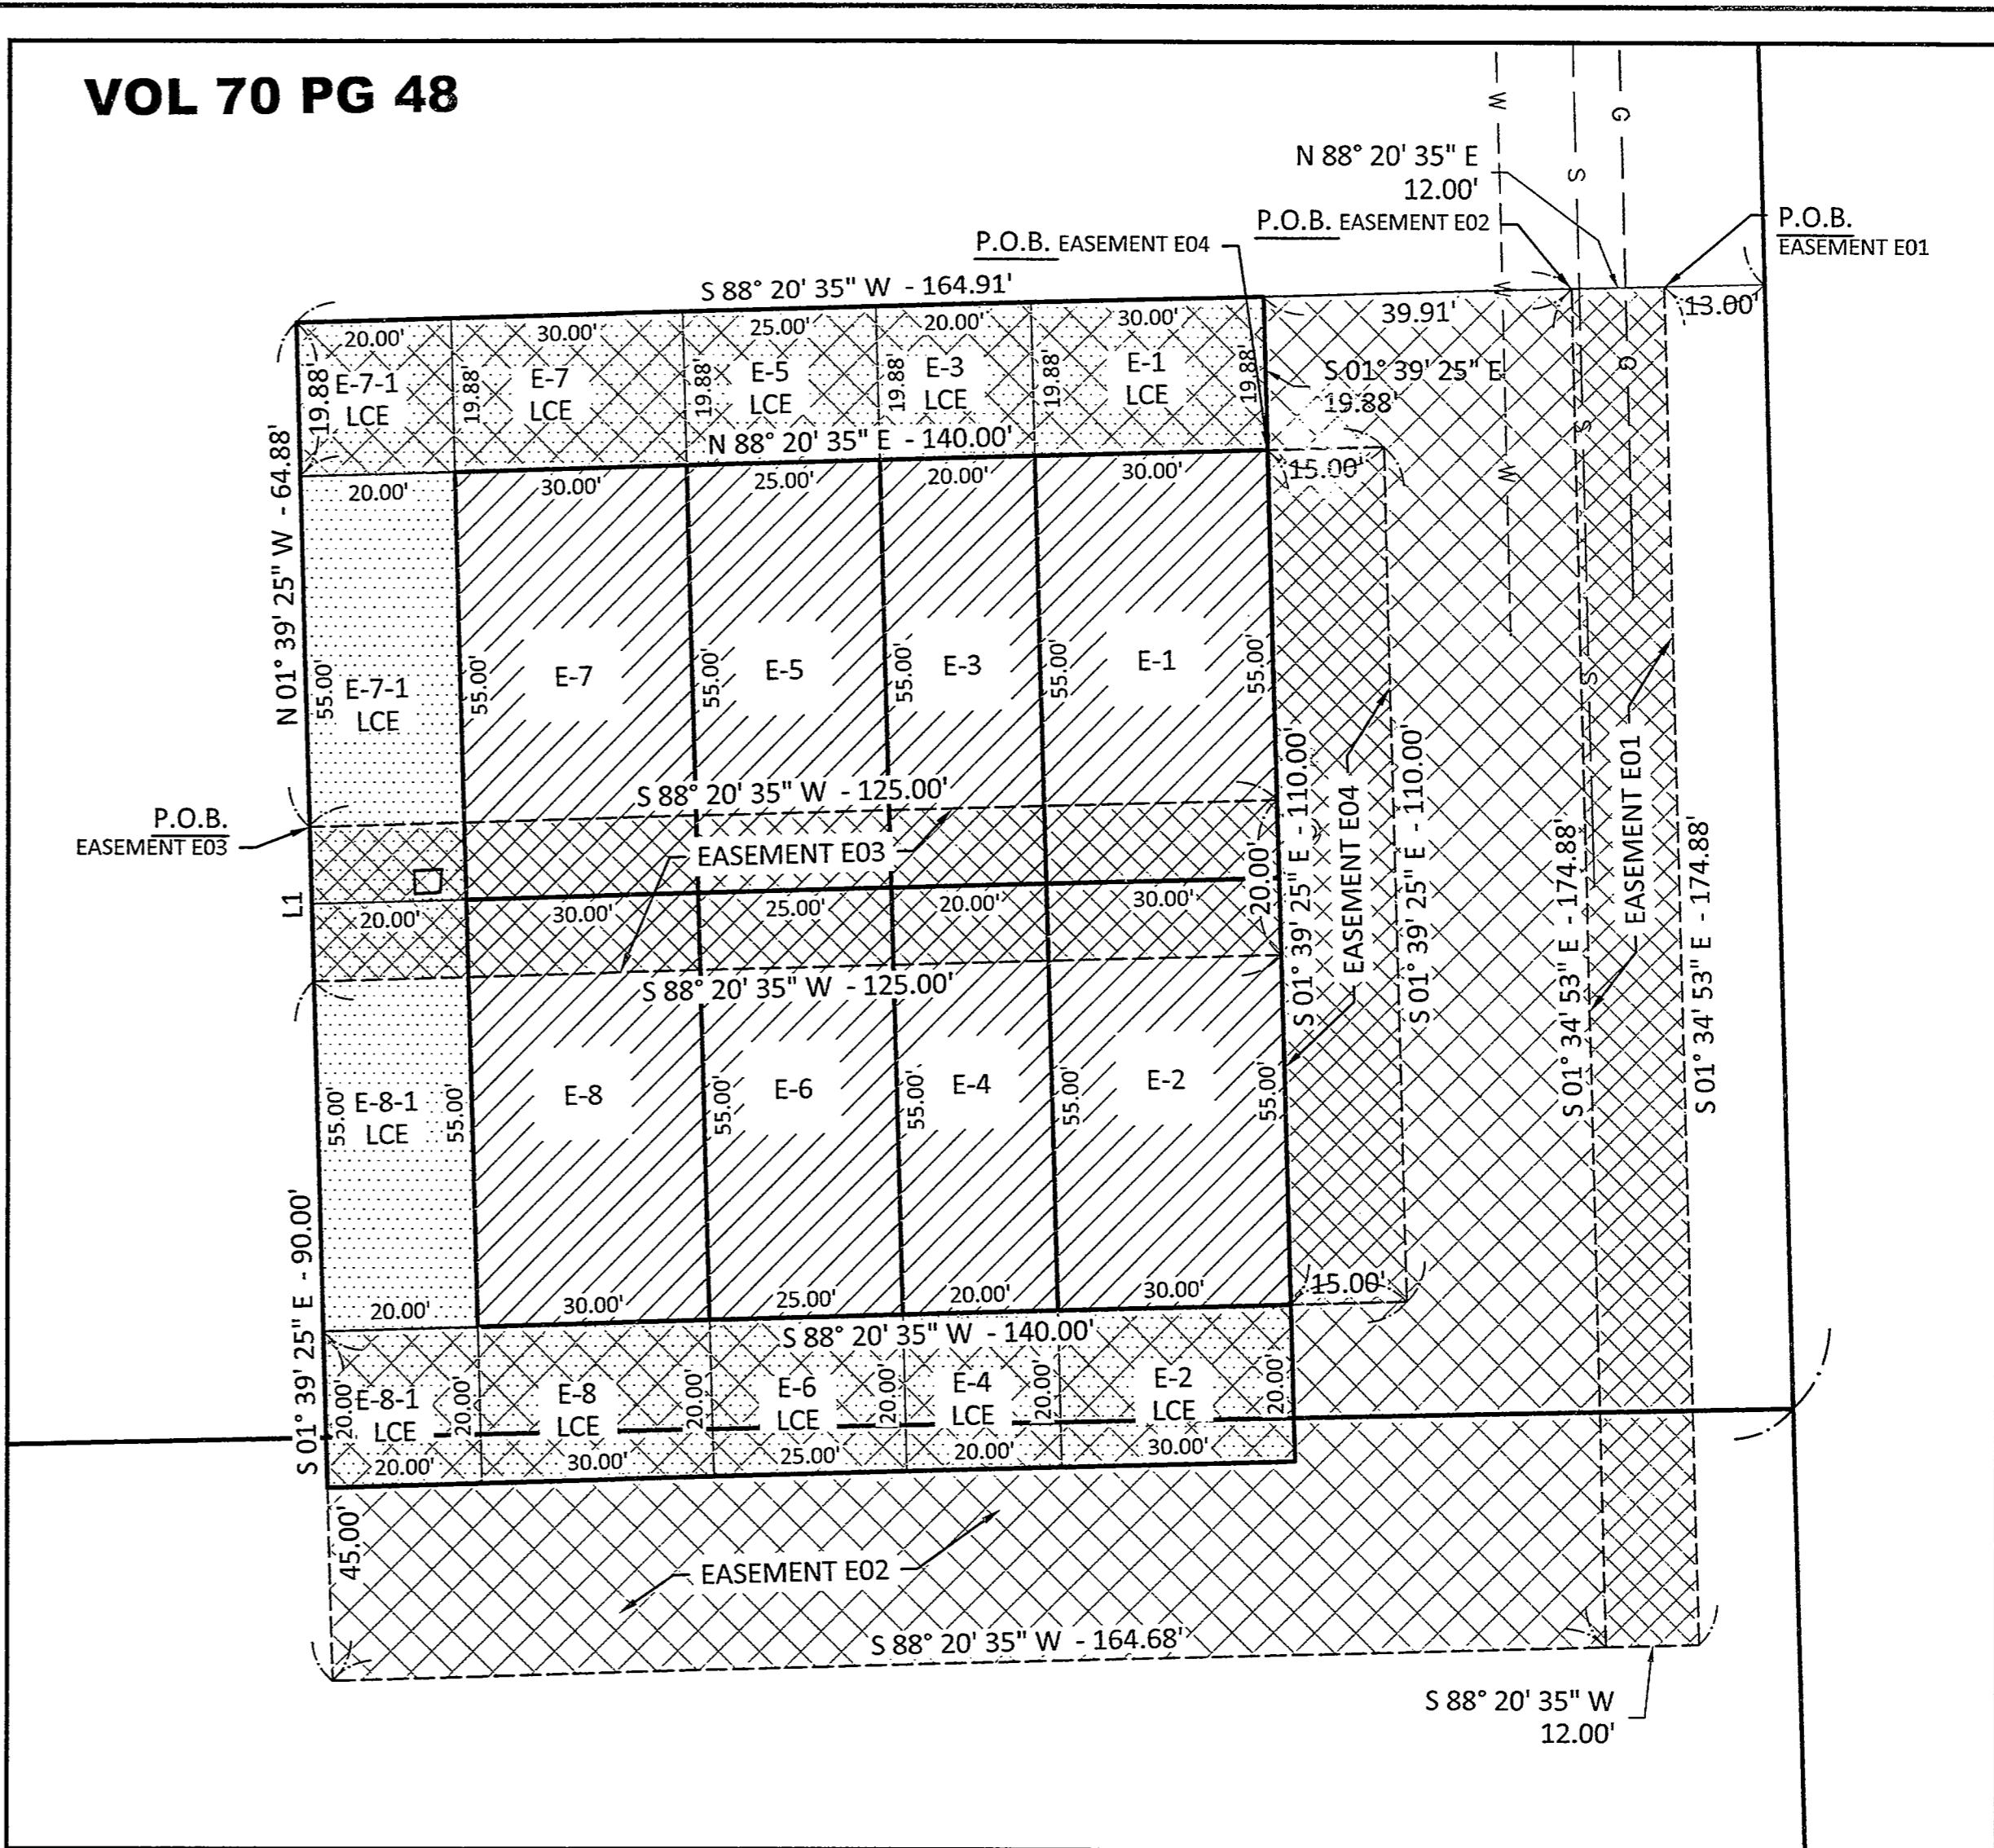
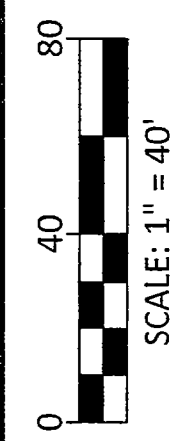


Line Table


Line #	Direction	Length
L1	N 01° 39' 25" W	20.00'

- LEGEND**
- MONUMENT FOUND
  - MONUMENT SET
  - (C) CALCULATED DISTANCE
  - (M) MEASURED DISTANCE
  - (REC) RECORD DISTANCE
  - R/W RIGHT-OF-WAY
  - P.O.B. POINT OF BEGINNING
  - P.O.C. POINT OF COMMENCEMENT
  - ▨ UNITS
  - ▩ LIMITED COMMON ELEMENT
  - ▧ EASEMENT

- REFERENCES**
- DEEDS AS SHOWN.
  - SAFE HARBOR STORAGE CONDOMINIUM FIRST AMENDMENT, PLAT VOLUME 62, PAGE 24.
  - SAFE HARBOR STORAGE CONDOMINIUM, PLAT VOLUME 60, PAGE 17.
  - SAFE HARBOR STORAGE CONDOMINIUM THIRD AMENDMENT, PLAT VOLUME 63, PAGE 48.
  - SAFE HARBOR STORAGE CONDOMINIUM FOURTH AMENDMENT, PLAT VOLUME 64, PAGE 29.
  - SAFE HARBOR STORAGE CONDOMINIUM FIFTH AMENDMENT, PLAT VOLUME 65, PAGE 2.
  - SAFE HARBOR STORAGE CONDOMINIUM SIXTH AMENDMENT, PLAT VOLUME 66, PAGE 17.
  - SAFE HARBOR STORAGE CONDOMINIUM SEVENTH AMENDMENT, PLAT VOLUME 67, PAGE 36.
  - SAFE HARBOR STORAGE CONDOMINIUM EIGHTH AMENDMENT, PLAT VOLUME 67, PAGE 50.
  - SAFE HARBOR STORAGE CONDOMINIUM ELEVENTH AMENDMENT, PLAT VOLUME 69, PAGE 13.

NO	REVISION	DATE
9		
8		
7		
6		
5		
4		
3		
2		
1	CORRECTED E-8-1 LCE AND SOUTHERLY ADJOINER	9/21/20






DGL CONSULTING ENGINEERS, LLC  
 3455 BRIARFIELD BLVD, SUITE E  
 MAUMEE, OH 43537  
 PHONE: 419.535.1015  
 www.dgl-ctd.com

**SAFE HARBOR STORAGE CONDOMINIUM THIRTEENTH AMENDMENT**

LOCATED IN PART OF LOT 03, SECTION 04, DANBURY TOWNSHIP, OTTAWA COUNTY, OHIO.

FILE:	THIRTEENTH
JOB NO.:	19082
DRAWN BY:	KEY
ISSUED:	08/20/2020

2/4

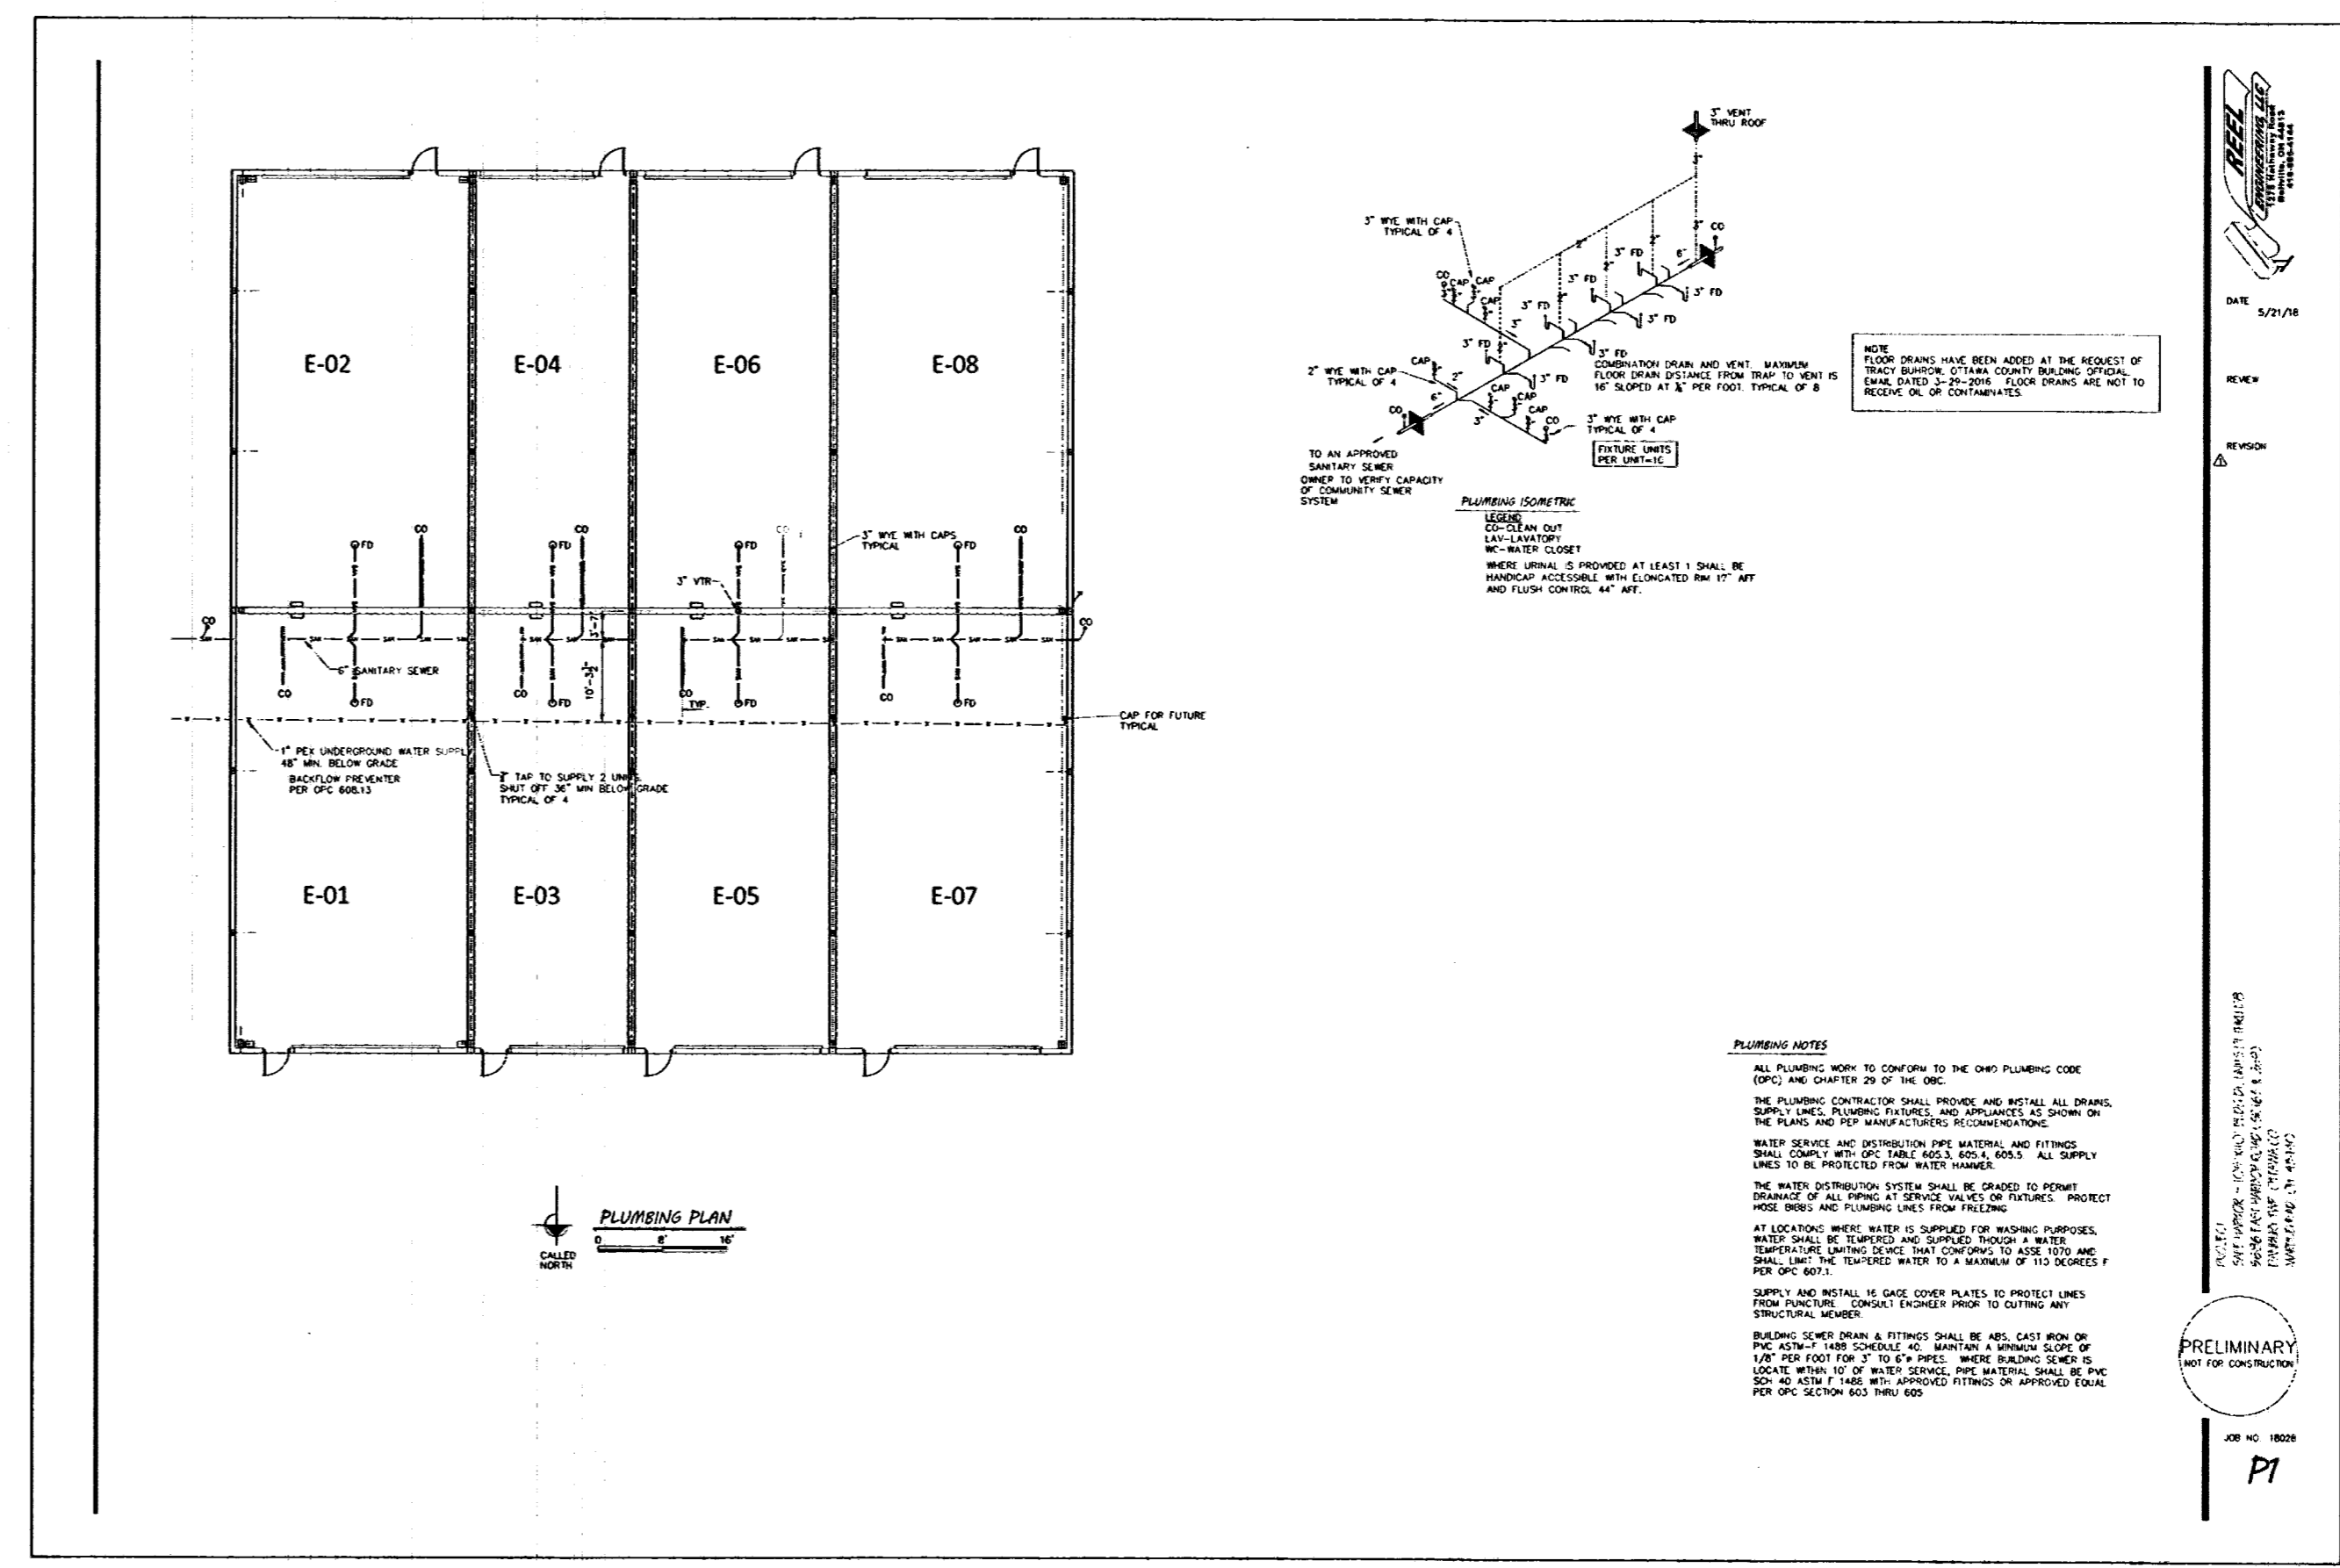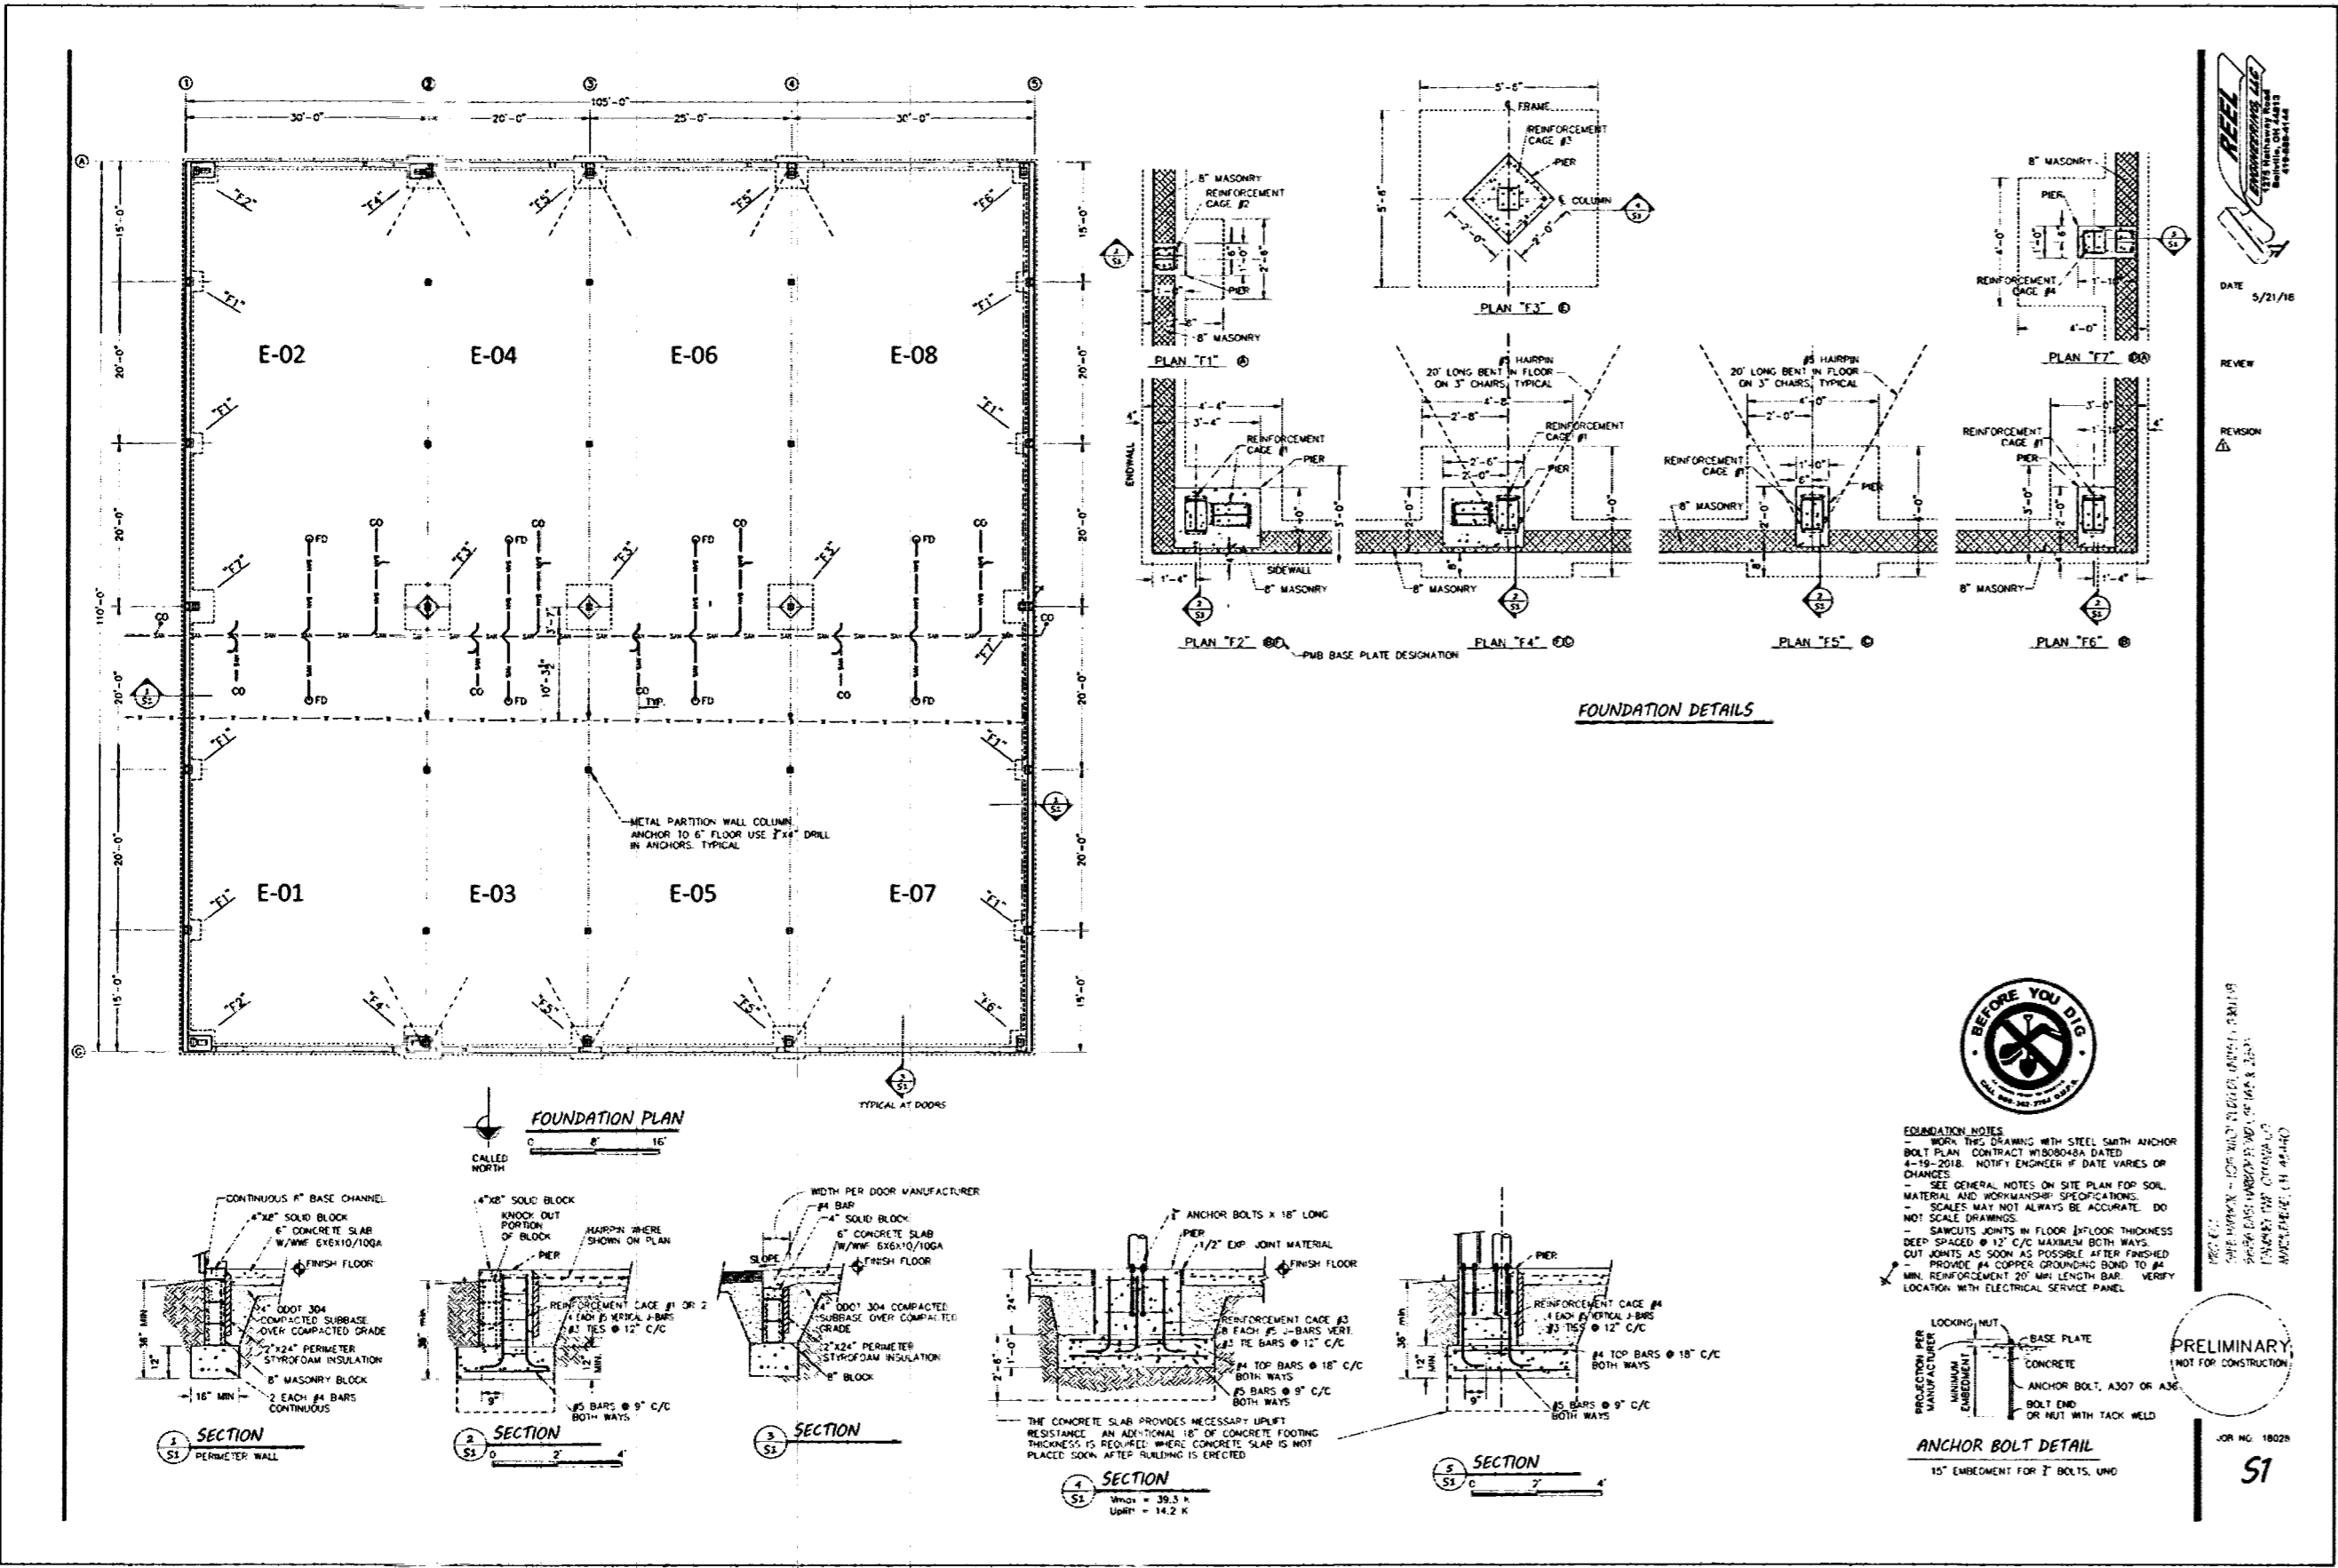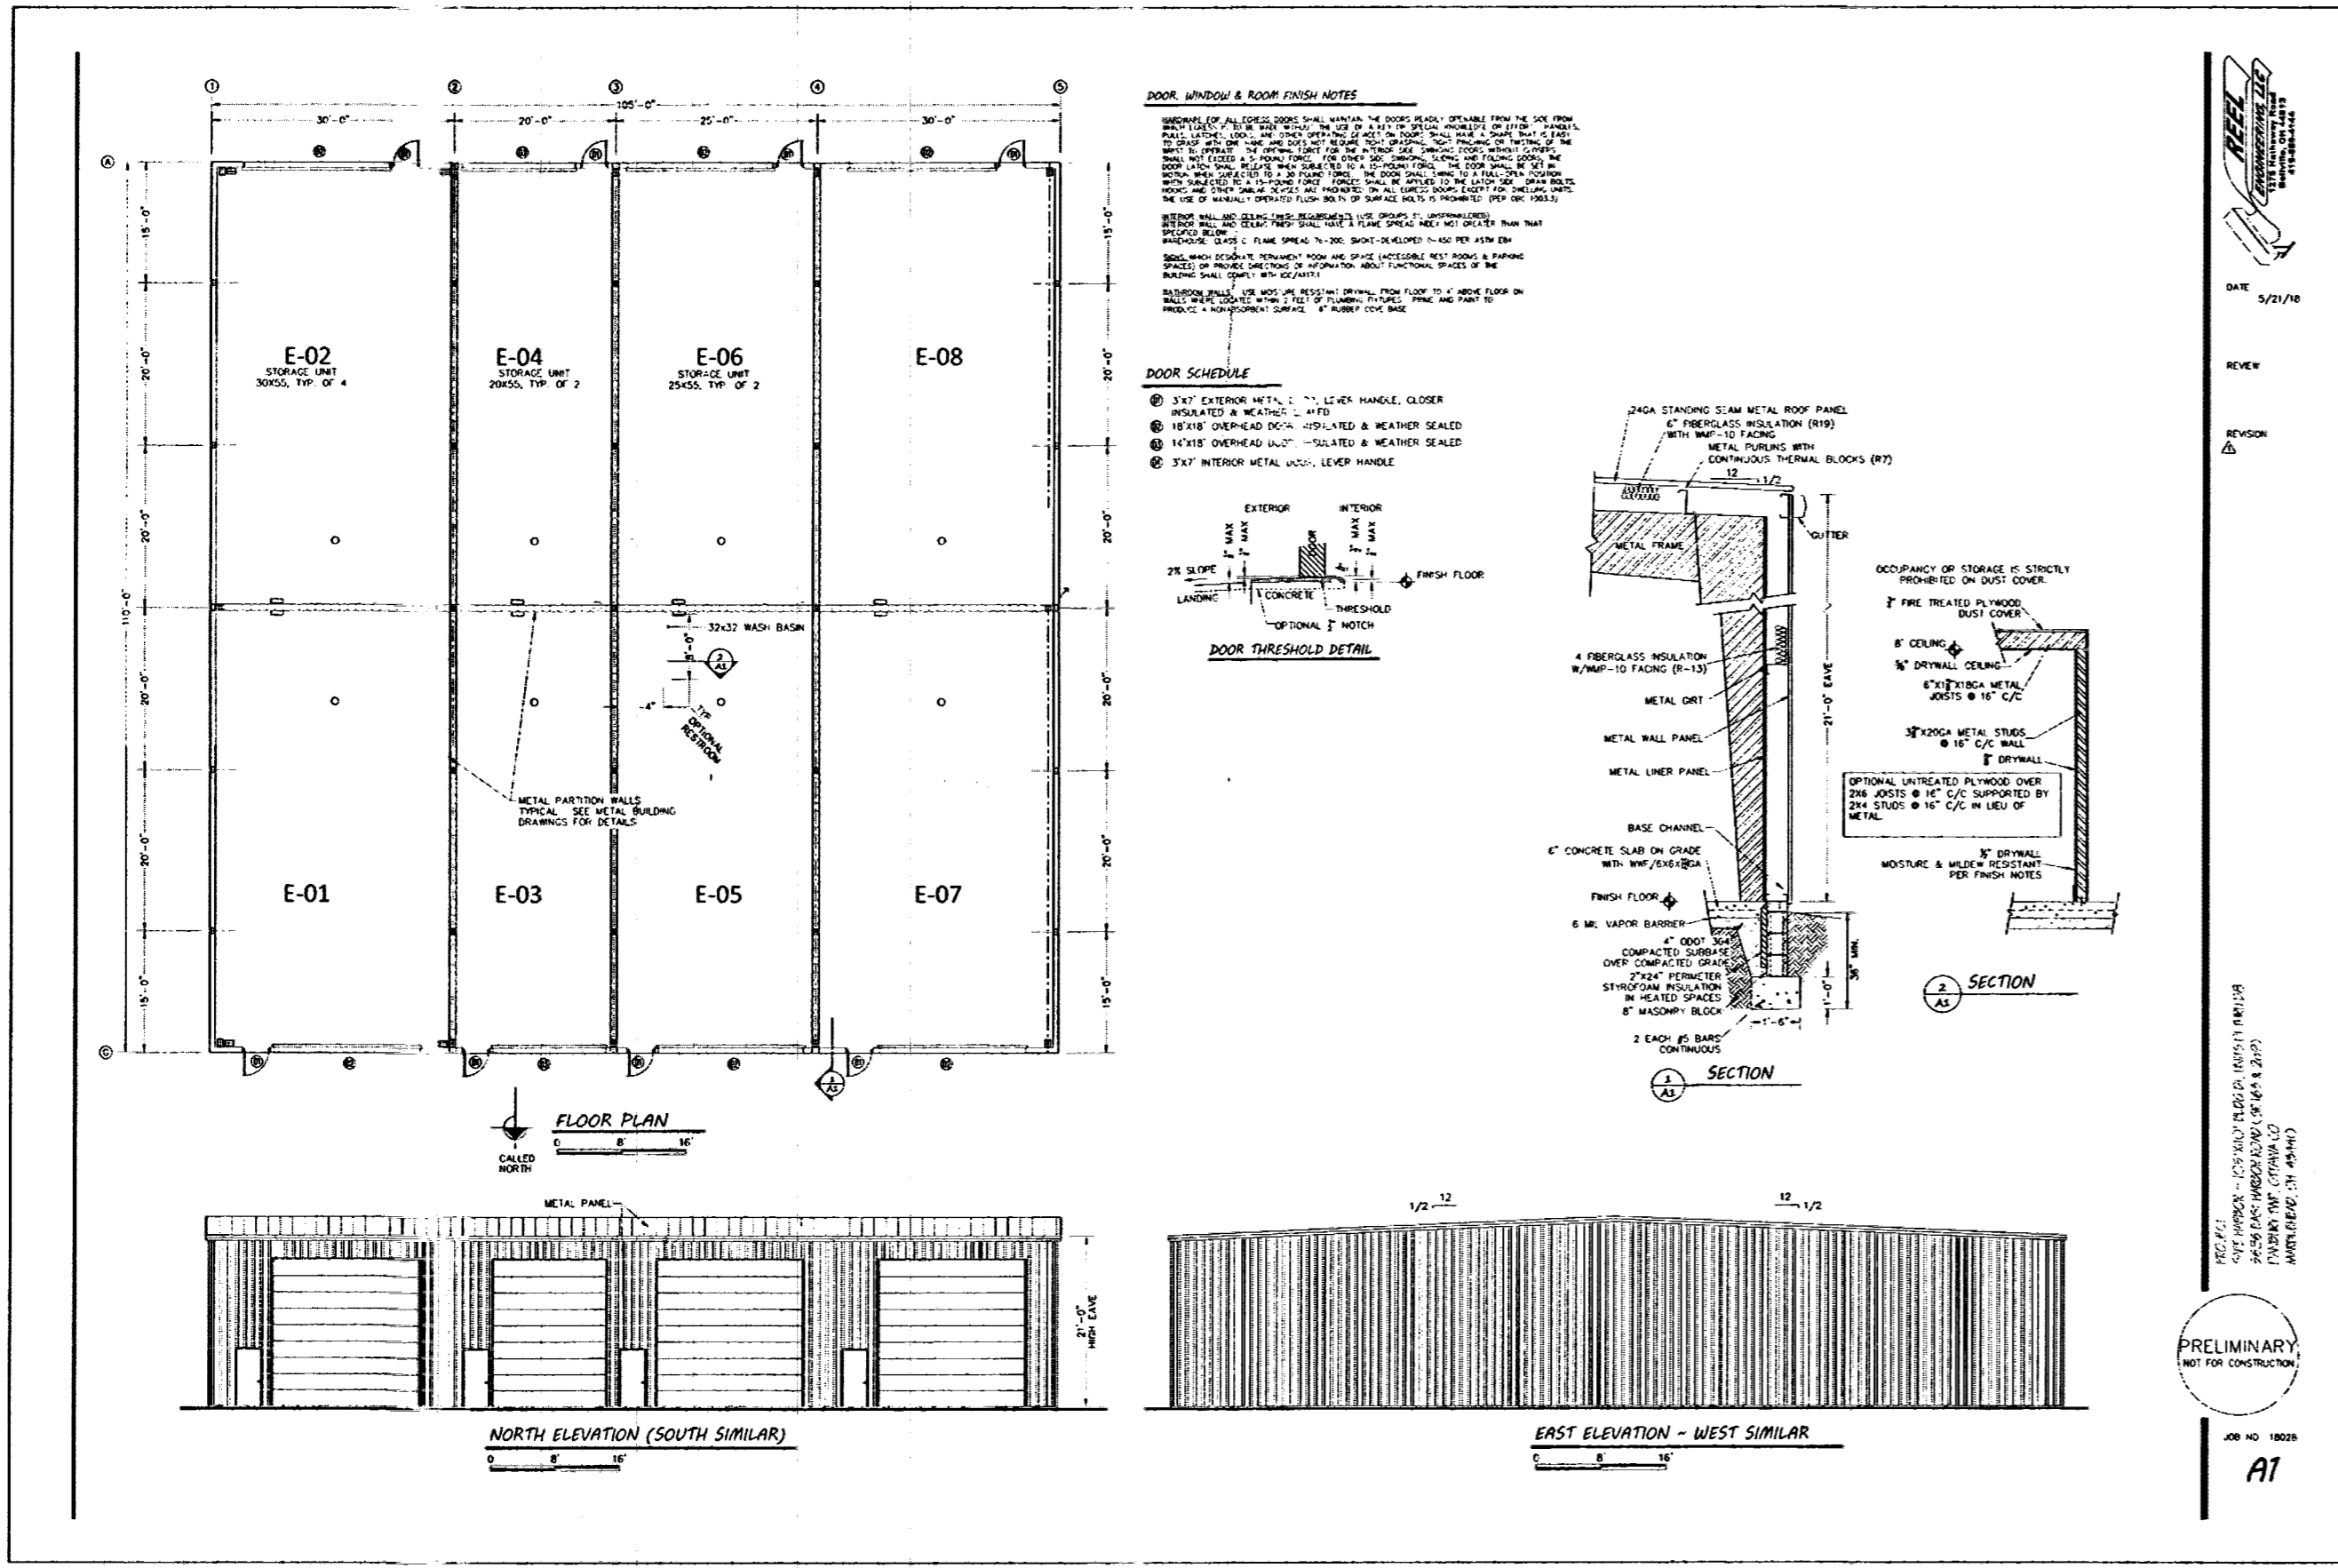

PLOTTED: Aug 26, 2020 - 12:38pm  
DRAWING: M:\19082 (Safe Harbor - 19 General Services Agreement)\Safe Harbor Condominium\Survey\Dig\22x34 Safe Harbor Condominium Thirteenth Amendment.dwg: PAGE3

**SAFE HARBOR STORAGE  
CONDOMINIUM  
THIRTEENTH AMENDMENT**  
LOCATED IN PART OF LOT 03, SECTION 04, DANBURY  
TOWNSHIP, OTTAWA COUNTY, OHIO.

