
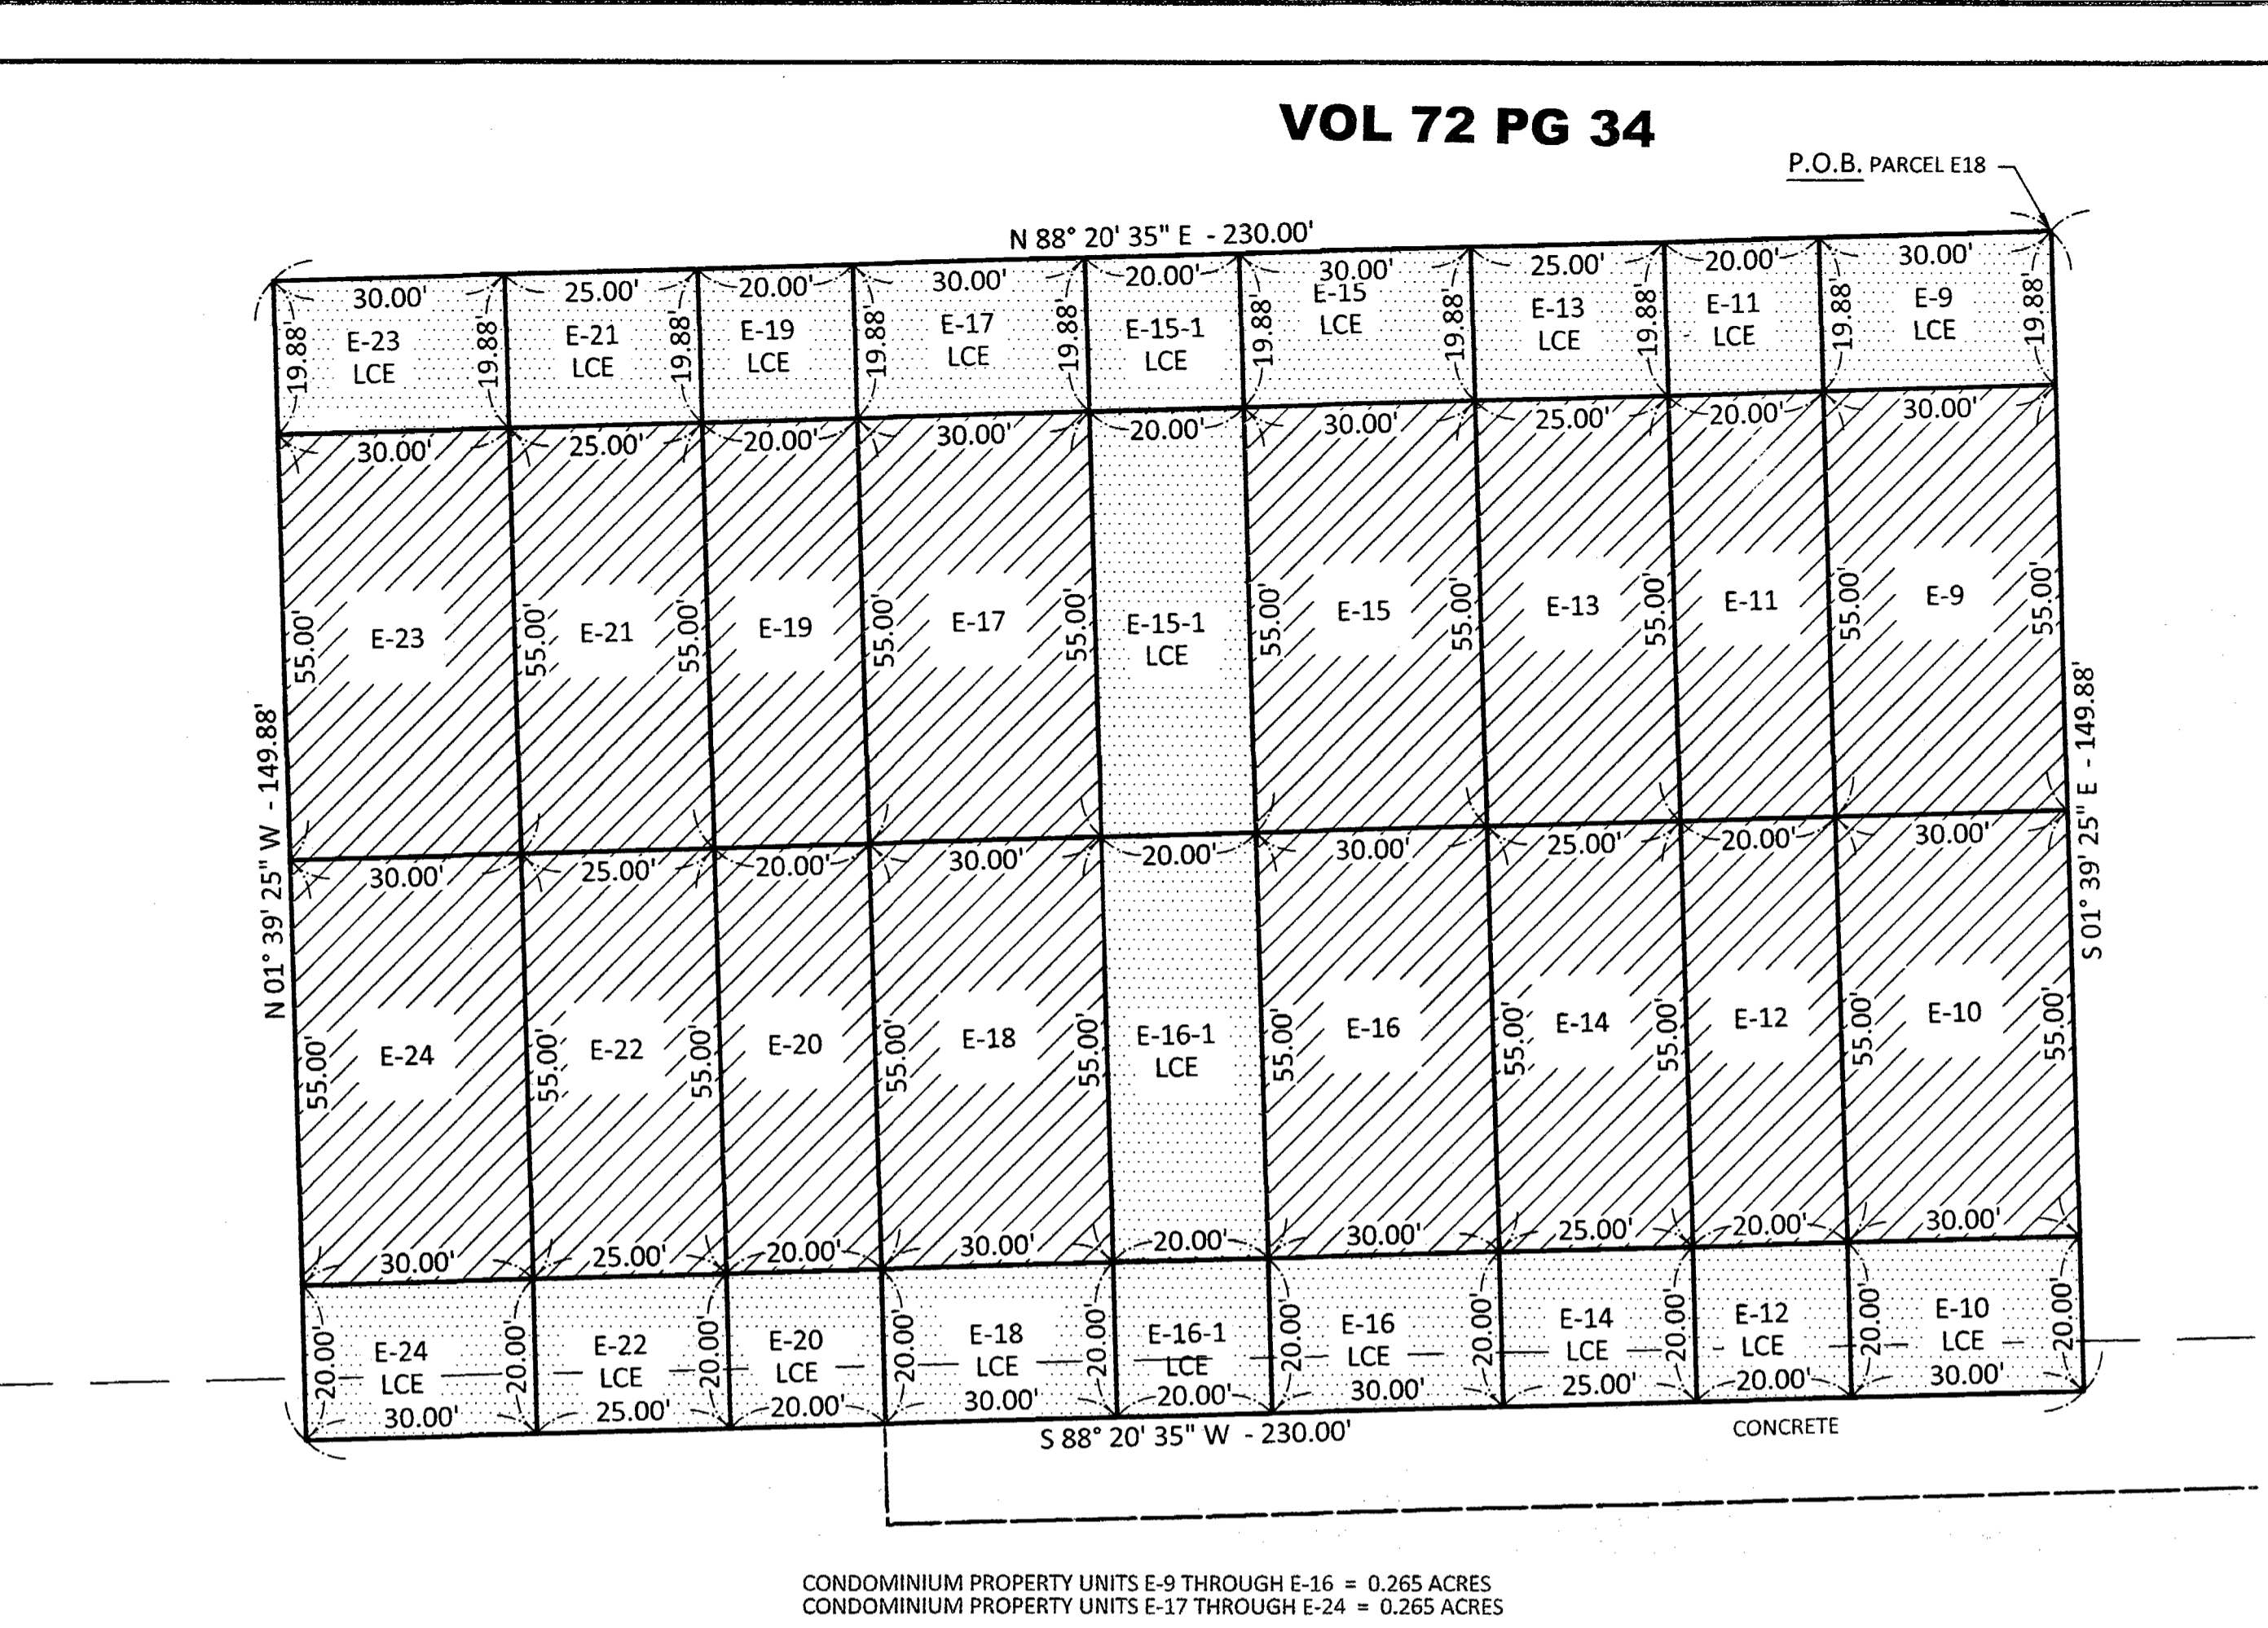


PLOTTED: Aug 06, 2021 - 1:06pm
DRAWING: M:\19082 (Safe Harbor - 19 General Services Agreement)\Safe Harbor Condominium (SURVEY) Dwg 22a34 Safe Harbor Condominiums Sixteenth Amendment.dwg: PAGE1

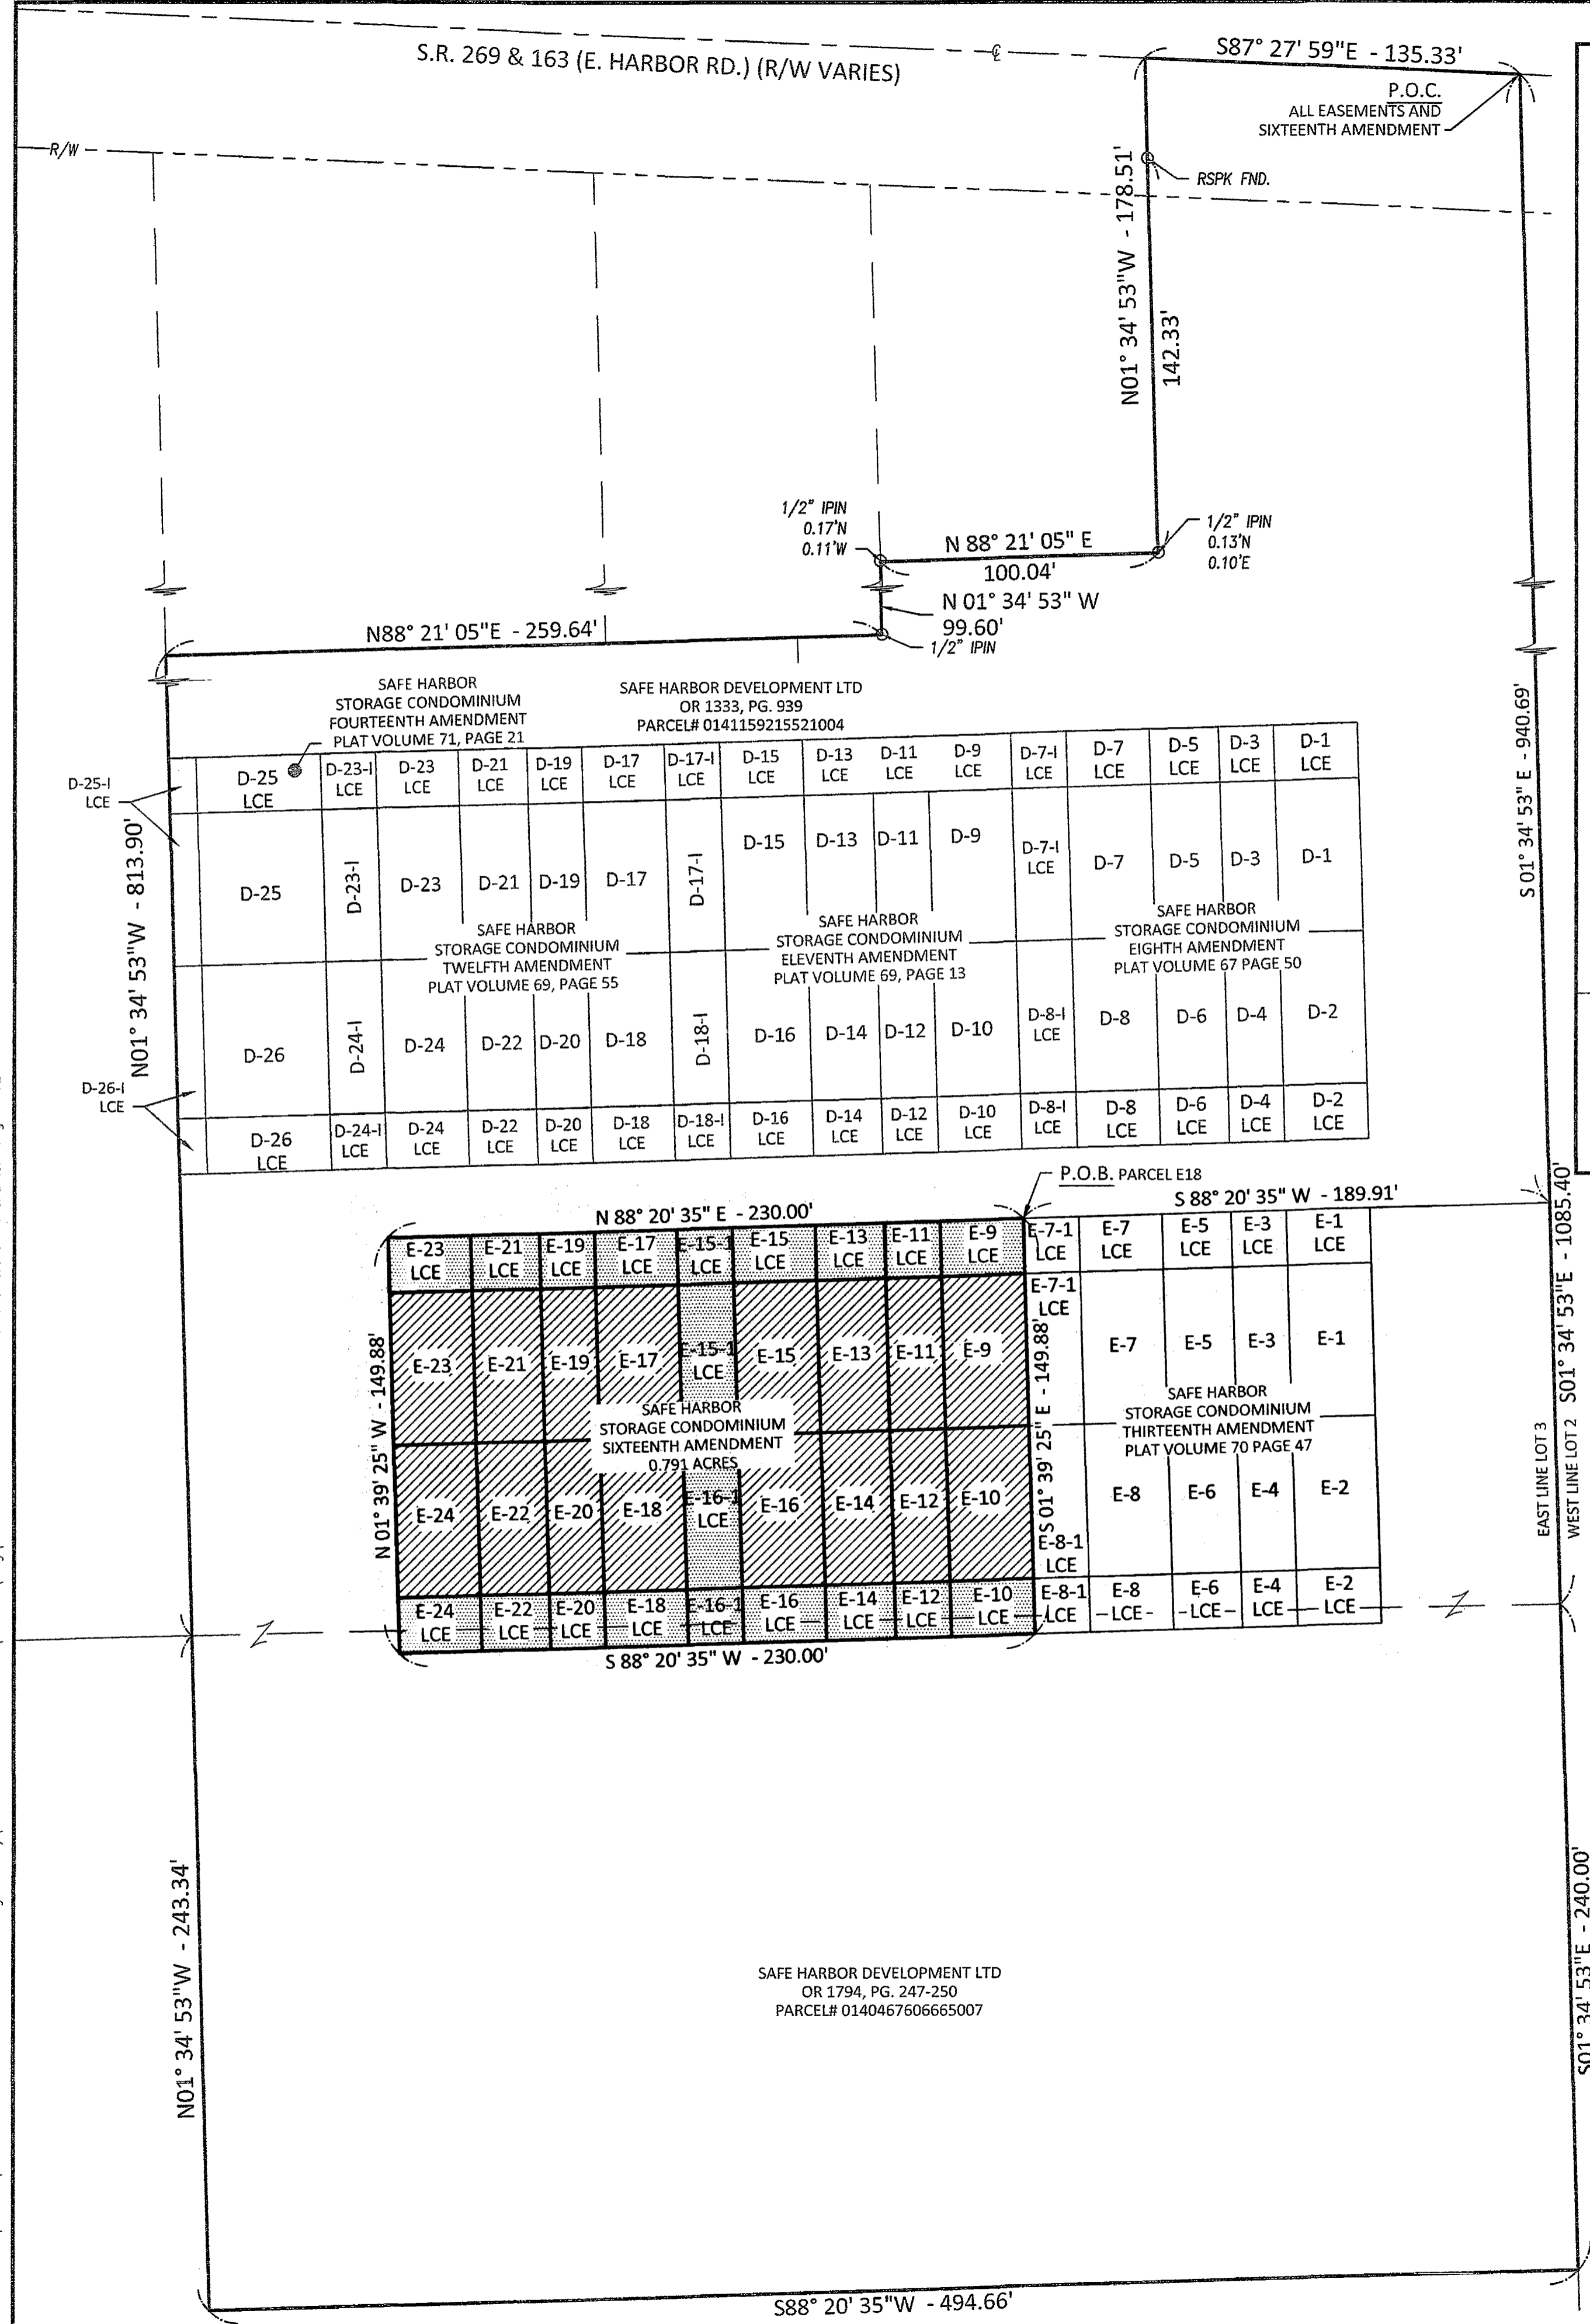

SIXTEENTH AMENDMENT

SCALE: 1"=20'

LEGEND

- MONUMENT FOUND
- MONUMENT SET
- (C) CALCULATED DISTANCE
- (M) MEASURED DISTANCE
- (REC) RECORD DISTANCE
- R/W RIGHT-OF-WAY
- P.O.B. POINT OF BEGINNING
- P.O.C. POINT OF COMMENCEMENT
- ▨ UNITS
- ▨ LIMITED COMMON ELEMENT
- FENCE

REFERENCES

DEEDS AS SHOWN.

SAFE HARBOR STORAGE CONDOMINIUM FIRST AMENDMENT, PLAT VOLUME 62, PAGE 24.

SAFE HARBOR STORAGE CONDOMINIUM, PLAT VOLUME 60, PAGE 17.

SAFE HARBOR STORAGE CONDOMINIUM THIRD AMENDMENT, PLAT VOLUME 63, PAGE 48.

SAFE HARBOR STORAGE CONDOMINIUM FOURTH AMENDMENT, PLAT VOLUME 64, PAGE 29.

SAFE HARBOR STORAGE CONDOMINIUM FIFTH AMENDMENT, PLAT VOLUME 65, PAGE 2.

SAFE HARBOR STORAGE CONDOMINIUM SIXTH AMENDMENT, PLAT VOLUME 66, PAGE 17.

SAFE HARBOR STORAGE CONDOMINIUM SEVENTH AMENDMENT, PLAT VOLUME 67, PAGE 36.

SAFE HARBOR STORAGE CONDOMINIUM EIGHTH AMENDMENT, PLAT VOLUME 67, PAGE 50.

SAFE HARBOR STORAGE CONDOMINIUM ELEVENTH AMENDMENT, PLAT VOLUME 69, PAGE 13.

SAFE HARBOR STORAGE CONDOMINIUM TWELFTH AMENDMENT, PLAT VOLUME 69, PAGE 55.

SAFE HARBOR STORAGE CONDOMINIUM THIRTEENTH AMENDMENT, PLAT VOLUME 70, PAGE 47.

SAFE HARBOR STORAGE CONDOMINIUM FOURTEENTH AMENDMENT, PLAT VOLUME 71, PAGE 21.

SAFE HARBOR STORAGE CONDOMINIUM FIFTEENTH AMENDMENT, DEED BOOK 1833, PAGE 132.

Document # **309459** Vol. **72** PG **34-39**
Date **8-10-2021** Time **12:28 pm**
Fee \$403.20

Nathan J. Daniels
Nathan J. Daniels
Recorder, Ottawa County Ohio

STATE OF OHIO
PETER J. SEGARD
S-7883
REGISTERED PROFESSIONAL SURVEYOR

SURVEYOR'S CERTIFICATION:
I HEREBY DECLARE THAT THE DRAWING ACCURATELY REFLECTS THE LOCATION OF IMPROVEMENTS AND RECORDED EASEMENTS TO THE BEST OF MY KNOWLEDGE AND BELIEF.

Peter J. Segard
PETER J. SEGARD, P.S.
OHIO PROFESSIONAL SURVEYOR NO. 7883

STATE OF OHIO
JOSHUA J. O'NEIL
69263
REGISTERED PROFESSIONAL ENGINEER

ENGINEER'S CERTIFICATION:
I HEREBY DECLARE THAT THE DRAWING ACCURATELY SHOWS EACH BUILDING AS BUILT TO THE BEST OF MY KNOWLEDGE AND BELIEF.

Joshua J. O'Neil
JOSHUA J. O'NEIL, P.E.
OHIO PROFESSIONAL ENGINEER NO. 69263

VOL 72 PG 34

P.O.B. PARCEL E18

SCALE: 1" = 40'

NO	REVISION	DATE
9		
8		
7		
6		
5		
4		
3		
2		
1		
NO		

DGL CONSULTING ENGINEERS, LLC
3455 BRIARFIELD BLVD., SUITE E
MAUMEE, OH 43537
PHONE: 419.535.1015
www.dgl-llc.com

SAFE HARBOR STORAGE CONDOMINIUM SIXTEENTH AMENDMENT

LOCATED IN PART OF LOT 03, SECTION 04, DANBURY TOWNSHIP, OTTAWA COUNTY, OHIO.

FILE:	FOURTEENTH
JOB NO.:	19082-8
DRAWN BY:	GSW
ISSUED:	07/08/2021

1/6