
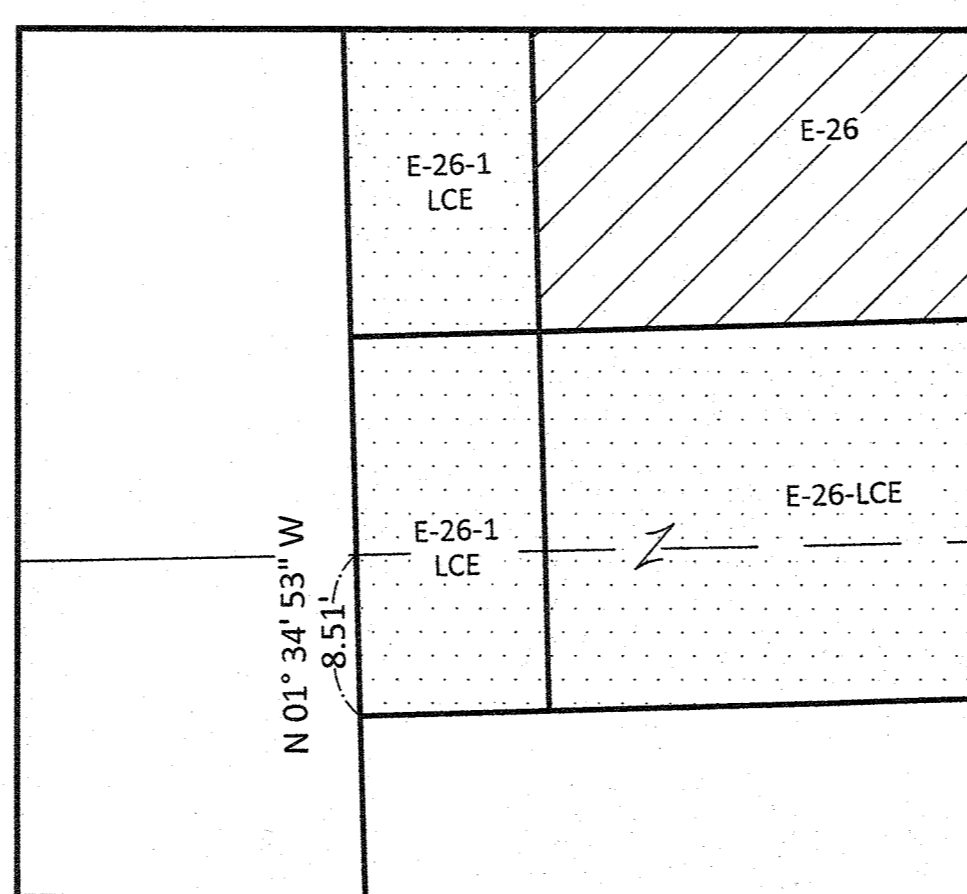
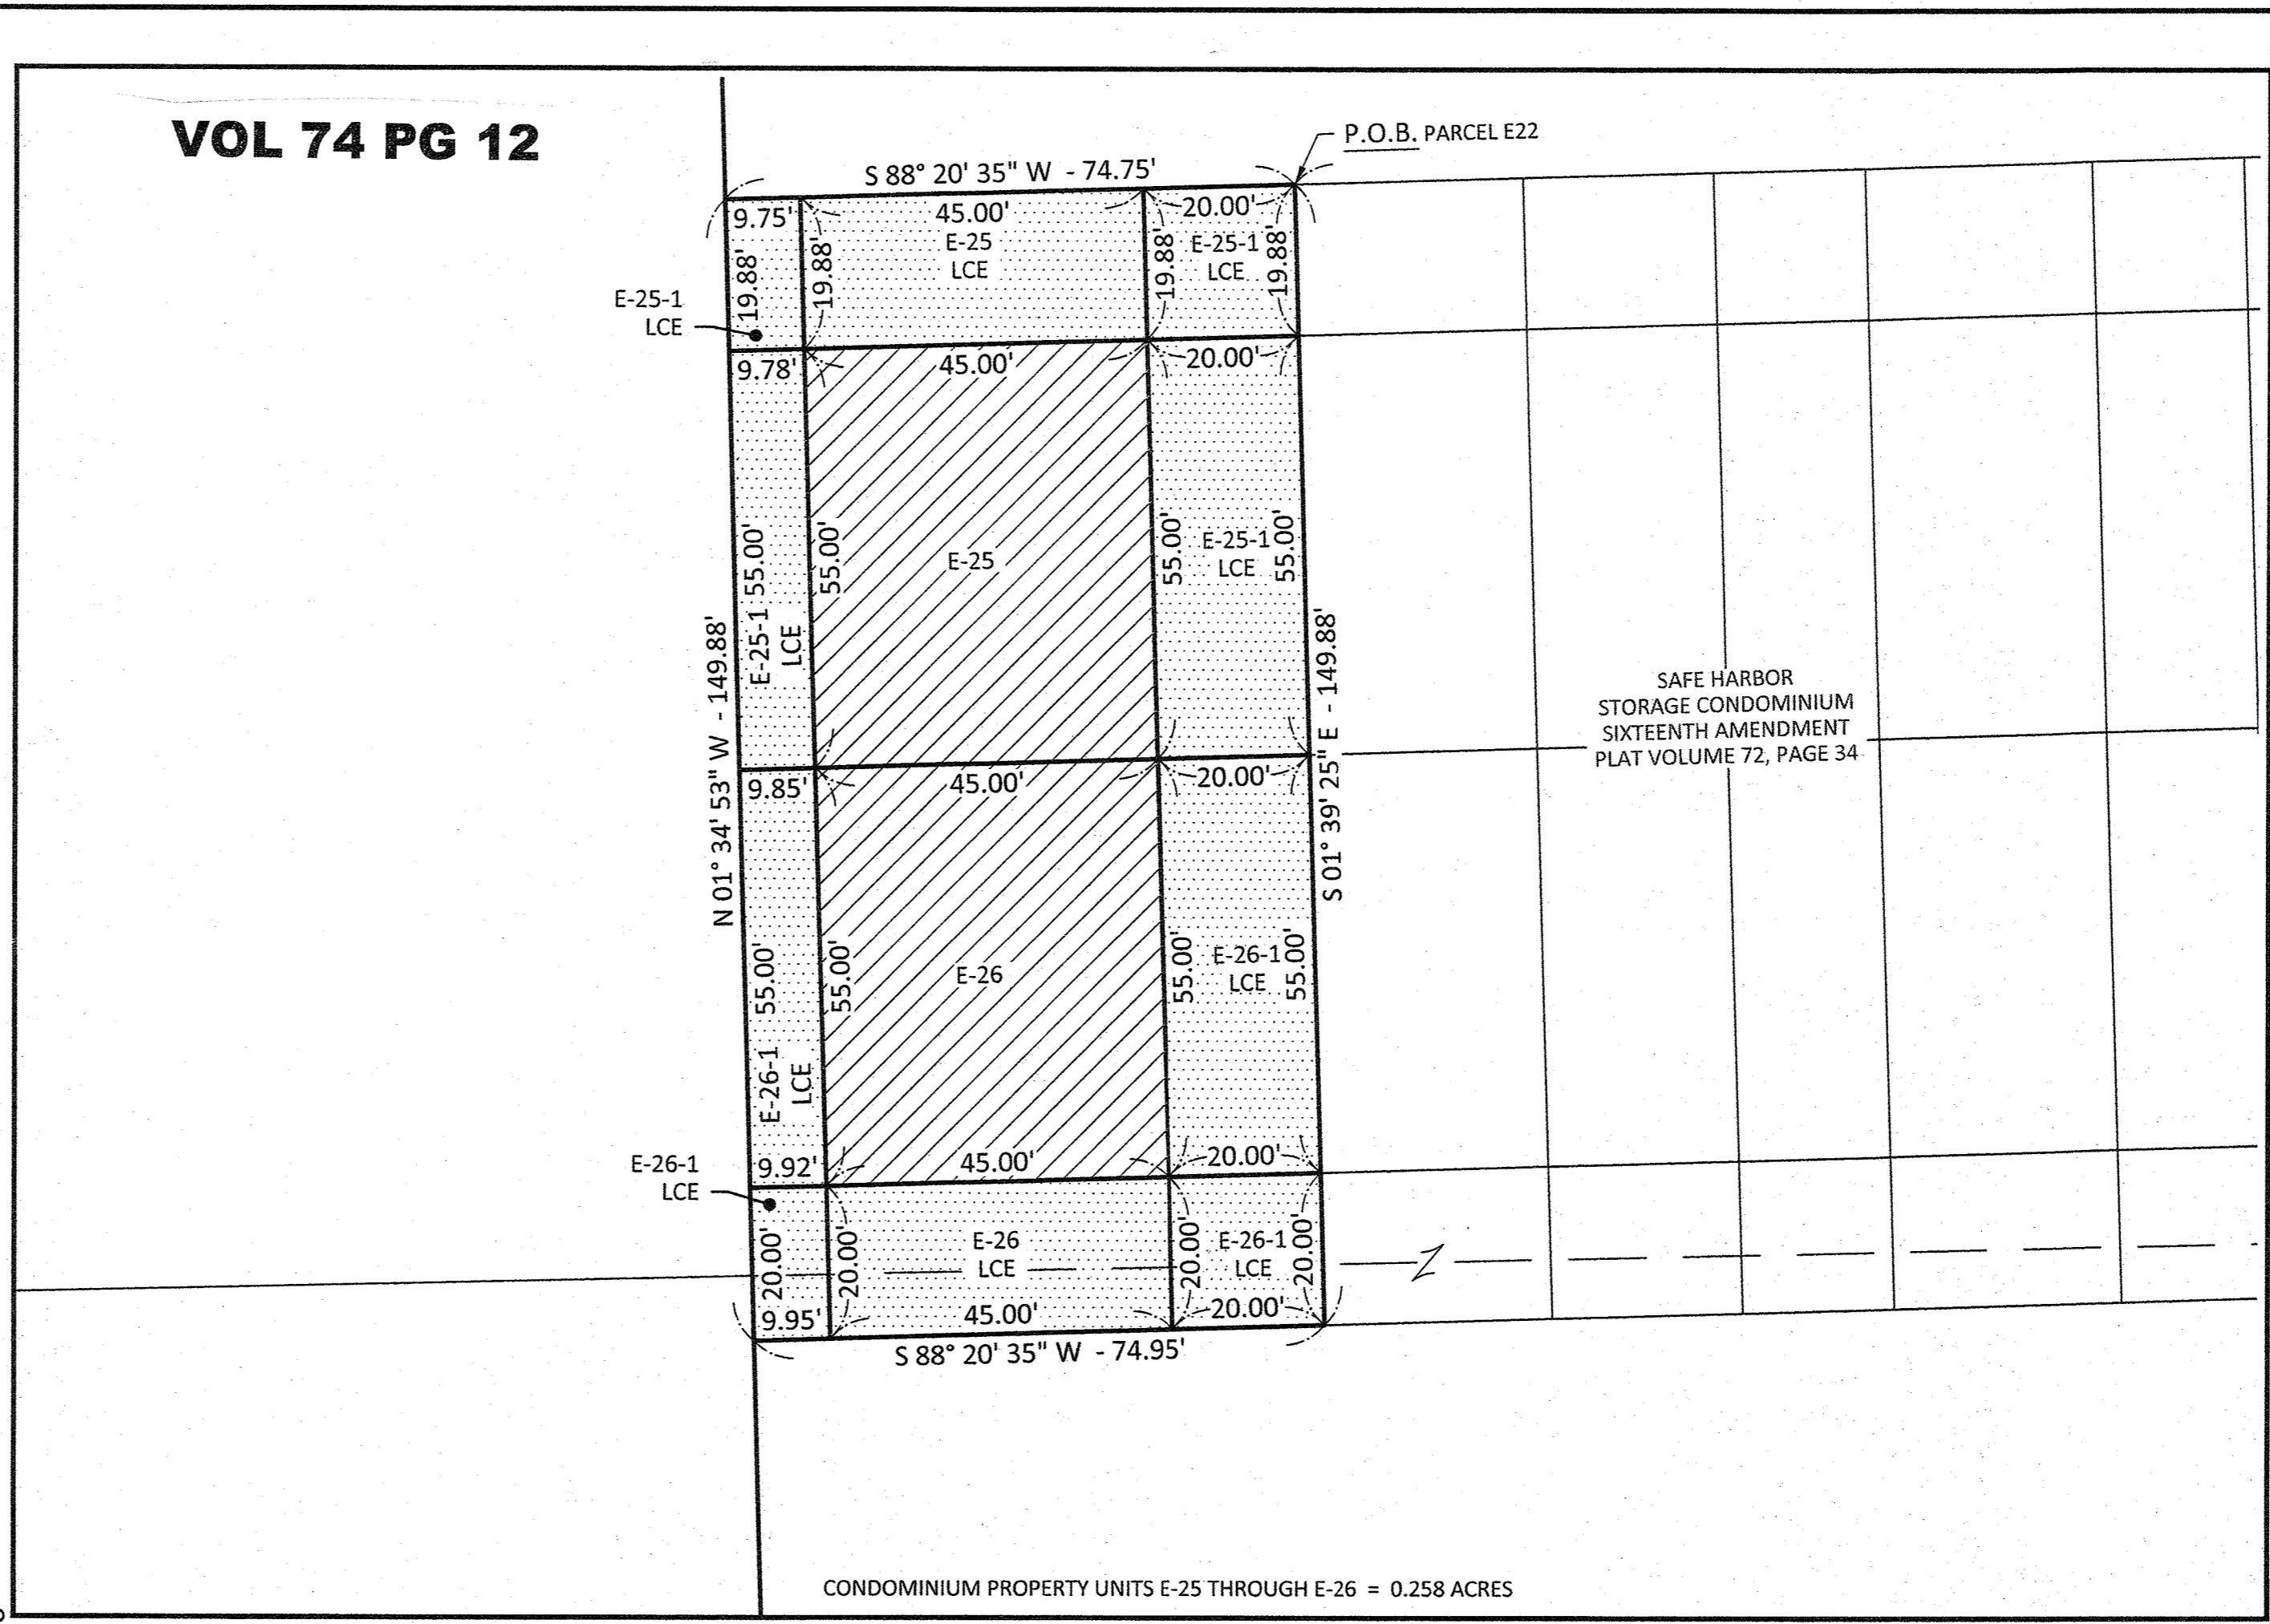



PLOTTED: Dec 16, 2021 - 3:43pm  
 DRAWING: M:\19092 (Safe Harbor - 19 General Services Agreement)\Safe Harbor Condominium\Seventeenth Amendment.dwg, PAGE1

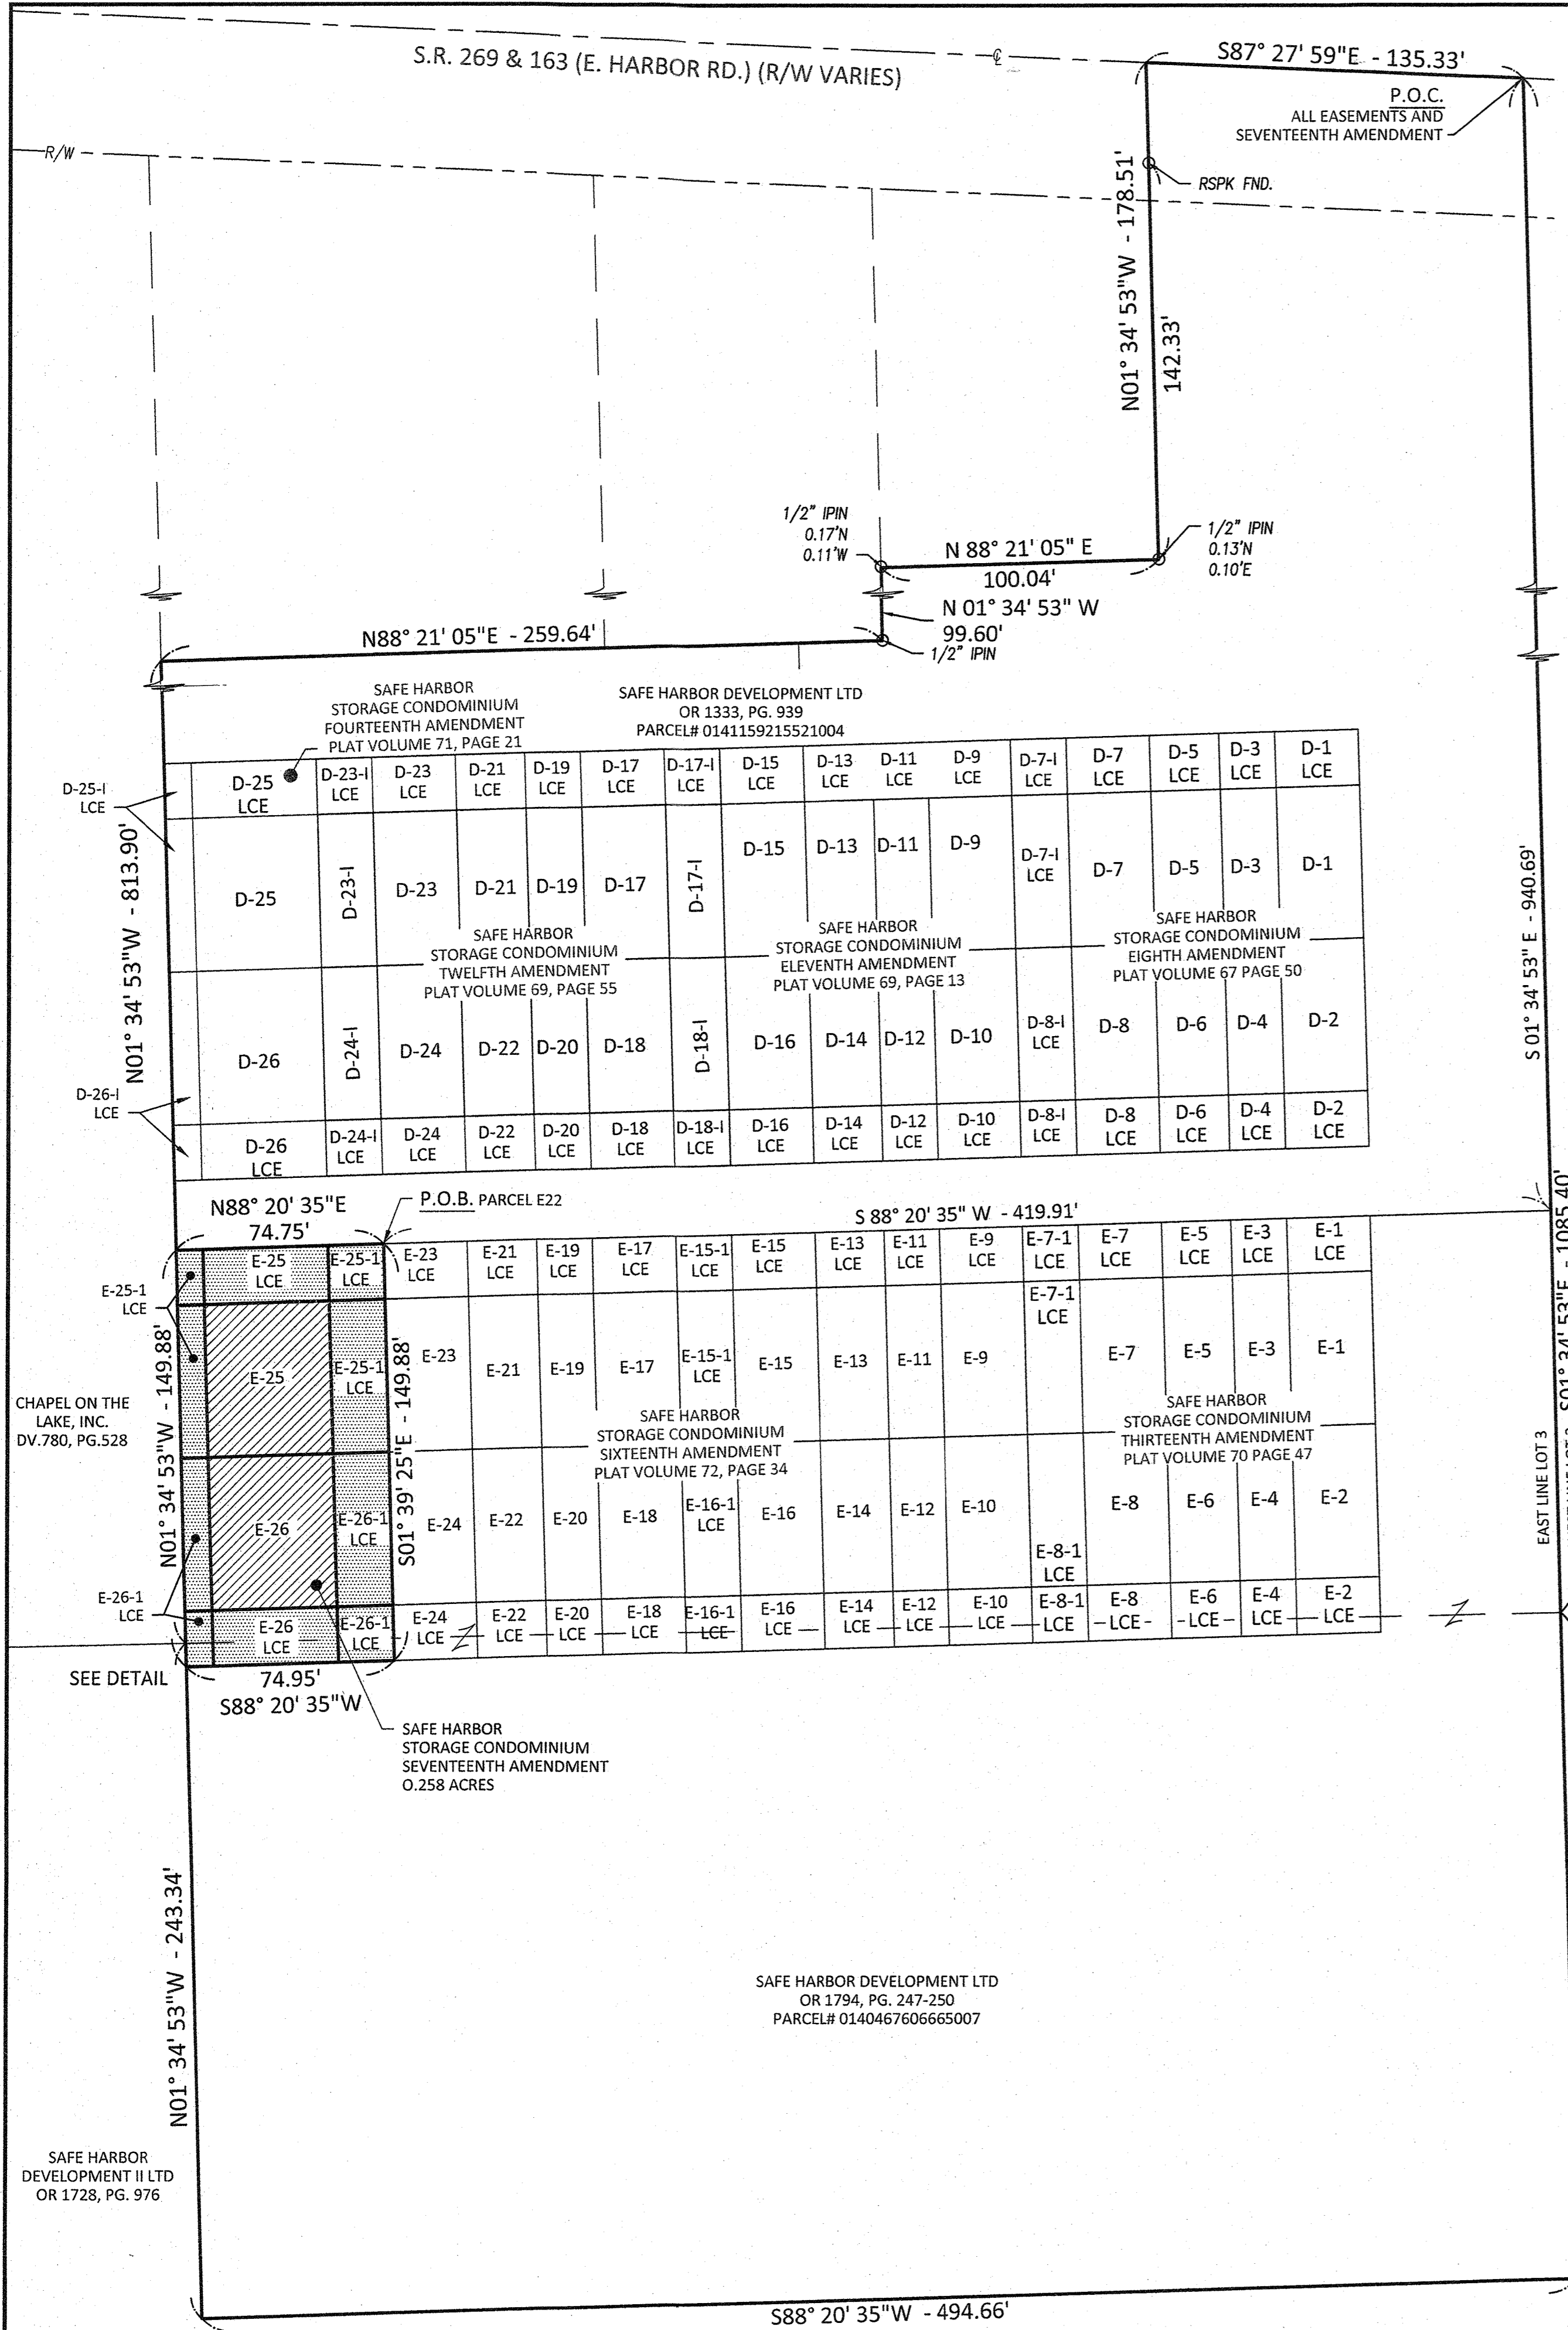

- LEGEND**
- MONUMENT FOUND
  - MONUMENT SET
  - (C) CALCULATED DISTANCE
  - (M) MEASURED DISTANCE
  - (REC) RECORD DISTANCE
  - R/W RIGHT-OF-WAY
  - P.O.B. POINT OF BEGINNING
  - P.O.C. POINT OF COMMENCEMENT
  - UNIT
  - LIMITED COMMON ELEMENT
  - FENCE


- REFERENCES**
- DEEDS AS SHOWN.
  - SAFE HARBOR STORAGE CONDOMINIUM FIRST AMENDMENT, PLAT VOLUME 62, PAGE 24.
  - SAFE HARBOR STORAGE CONDOMINIUM, PLAT VOLUME 60, PAGE 17.
  - SAFE HARBOR STORAGE CONDOMINIUM THIRD AMENDMENT, PLAT VOLUME 63, PAGE 48.
  - SAFE HARBOR STORAGE CONDOMINIUM FOURTH AMENDMENT, PLAT VOLUME 64, PAGE 29.
  - SAFE HARBOR STORAGE CONDOMINIUM FIFTH AMENDMENT, PLAT VOLUME 65, PAGE 2.
  - SAFE HARBOR STORAGE CONDOMINIUM SIXTH AMENDMENT, PLAT VOLUME 66, PAGE 17.
  - SAFE HARBOR STORAGE CONDOMINIUM SEVENTH AMENDMENT, PLAT VOLUME 67, PAGE 36.
  - SAFE HARBOR STORAGE CONDOMINIUM EIGHTH AMENDMENT, PLAT VOLUME 67, PAGE 50.
  - SAFE HARBOR STORAGE CONDOMINIUM ELEVENTH AMENDMENT, PLAT VOLUME 69, PAGE 13.
  - SAFE HARBOR STORAGE CONDOMINIUM TWELFTH AMENDMENT, PLAT VOLUME 69, PAGE 55.
  - SAFE HARBOR STORAGE CONDOMINIUM THIRTEENTH AMENDMENT, PLAT VOLUME 70, PAGE 47.
  - SAFE HARBOR STORAGE CONDOMINIUM FOURTEENTH AMENDMENT, PLAT VOLUME 71, PAGE 21.
  - SAFE HARBOR STORAGE CONDOMINIUM FIFTEENTH AMENDMENT, DEED BOOK 1833, PAGE 132.
  - SAFE HARBOR STORAGE CONDOMINIUM SIXTEENTH AMENDMENT, PLAT VOLUME 72, PAGE 34.

Document # 314661 Vol. 74 PG 12-15  
 Date 1-25-2022 Time 3:56 pm  
 Fee \$268.80  
 Nathan J Daniels  
 Recorder, Ottawa County Ohio

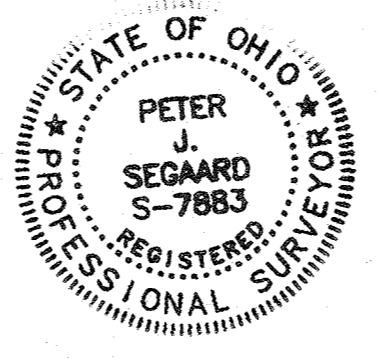

**SURVEYOR'S CERTIFICATION:**  
 I HEREBY DECLARE THAT THE DRAWING ACCURATELY REFLECTS THE LOCATION OF IMPROVEMENTS AND RECORDED EASEMENTS TO THE BEST OF MY KNOWLEDGE AND BELIEF.

Peter J. Segard  
 OHIO PROFESSIONAL SURVEYOR NO. 7883

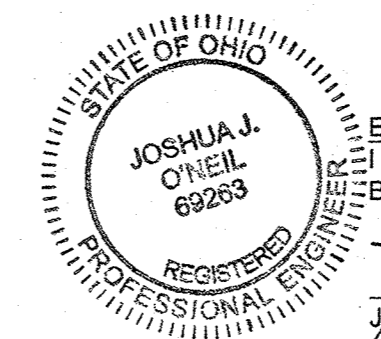

**ENGINEER'S CERTIFICATION:**  
 I HEREBY DECLARE THAT THE DRAWING ACCURATELY SHOWS EACH BUILDING AS BUILT TO THE BEST OF MY KNOWLEDGE AND BELIEF.

Joshua J. O'Neil  
 OHIO PROFESSIONAL ENGINEER NO. 69263

**LEGEND**  
 ○ MONUMENT FOUND  
 ● MONUMENT SET  
 (C) CALCULATED DISTANCE  
 (M) MEASURED DISTANCE  
 (REC) RECORD DISTANCE  
 R/W RIGHT-OF-WAY  
 P.O.B. POINT OF BEGINNING  
 P.O.C. POINT OF COMMENCEMENT  
 UNIT  
 LIMITED COMMON ELEMENT  
 FENCE

NO	REVISION	DATE
9		
8		
7		
6		
5		
4		
3		
2		
1		
NO		

DGL CONSULTING ENGINEERS, LLC  
 3455 BRIARFIELD BLVD., SUITE E  
 MAUMEE, OH 43537  
 PHONE: 419.535.1015  
 www.dgl-td.com


**SAFE HARBOR STORAGE CONDOMINIUM SEVENTEENTH AMENDMENT**  
 LOCATED IN PART OF LOT 03, SECTION 04, DANBURY TOWNSHIP, OTTAWA COUNTY, OHIO.

FILE:	SEVENTEENTH
JOB NO.:	19082-???
DRAWN BY:	GSW
ISSUED:	12/15/2021


1/4

PLOTTED: Dec 16, 2021 - 3:43pm  
 DRAWING: M:\19092 (Safe Harbor - 19 General Services Agreement)\Safe Harbor Condominium\Seventeenth Amendment.dwg, PAGE1

PLOTTED: Jan 13, 2022 - 12:50pm  
 DRAWING: M:\19082 (Safe Harbor - 19 General Services Agreement)\Safe Harbor Condominium\Survey\2023\34 Safe Harbor Condominium Seventeenth Amendment.dwg PAGE2

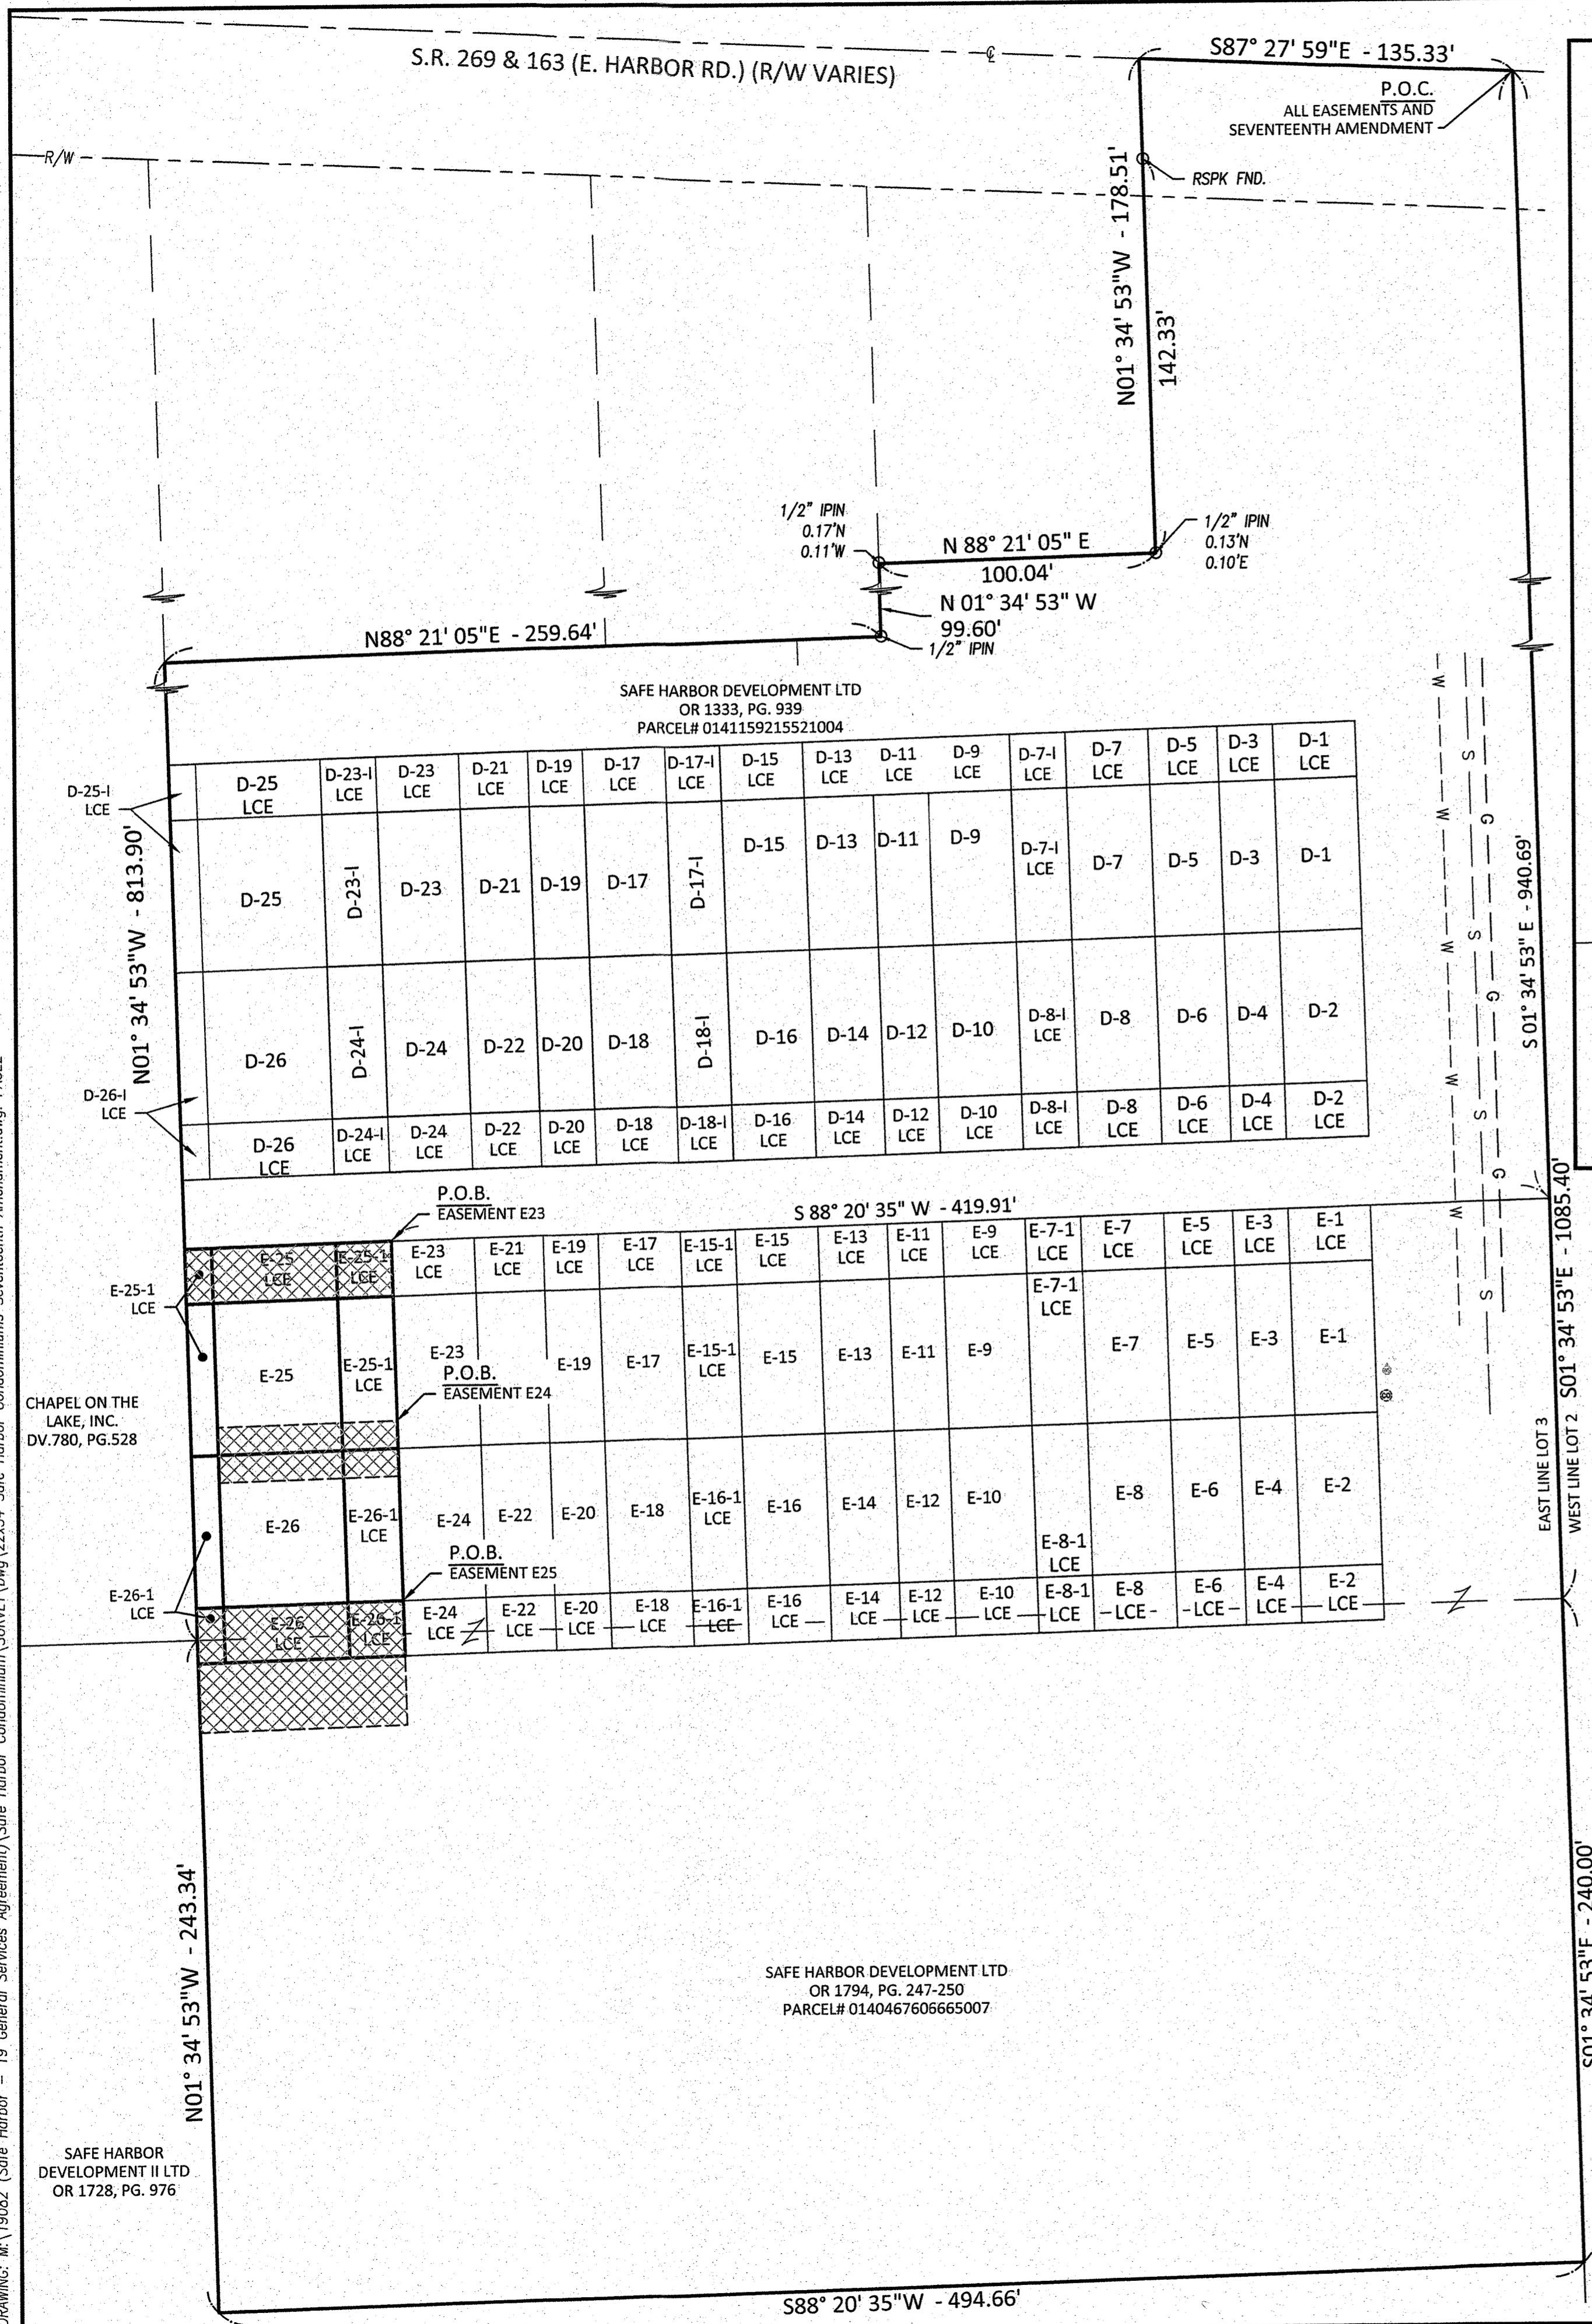


**VOL 74 PG 13**

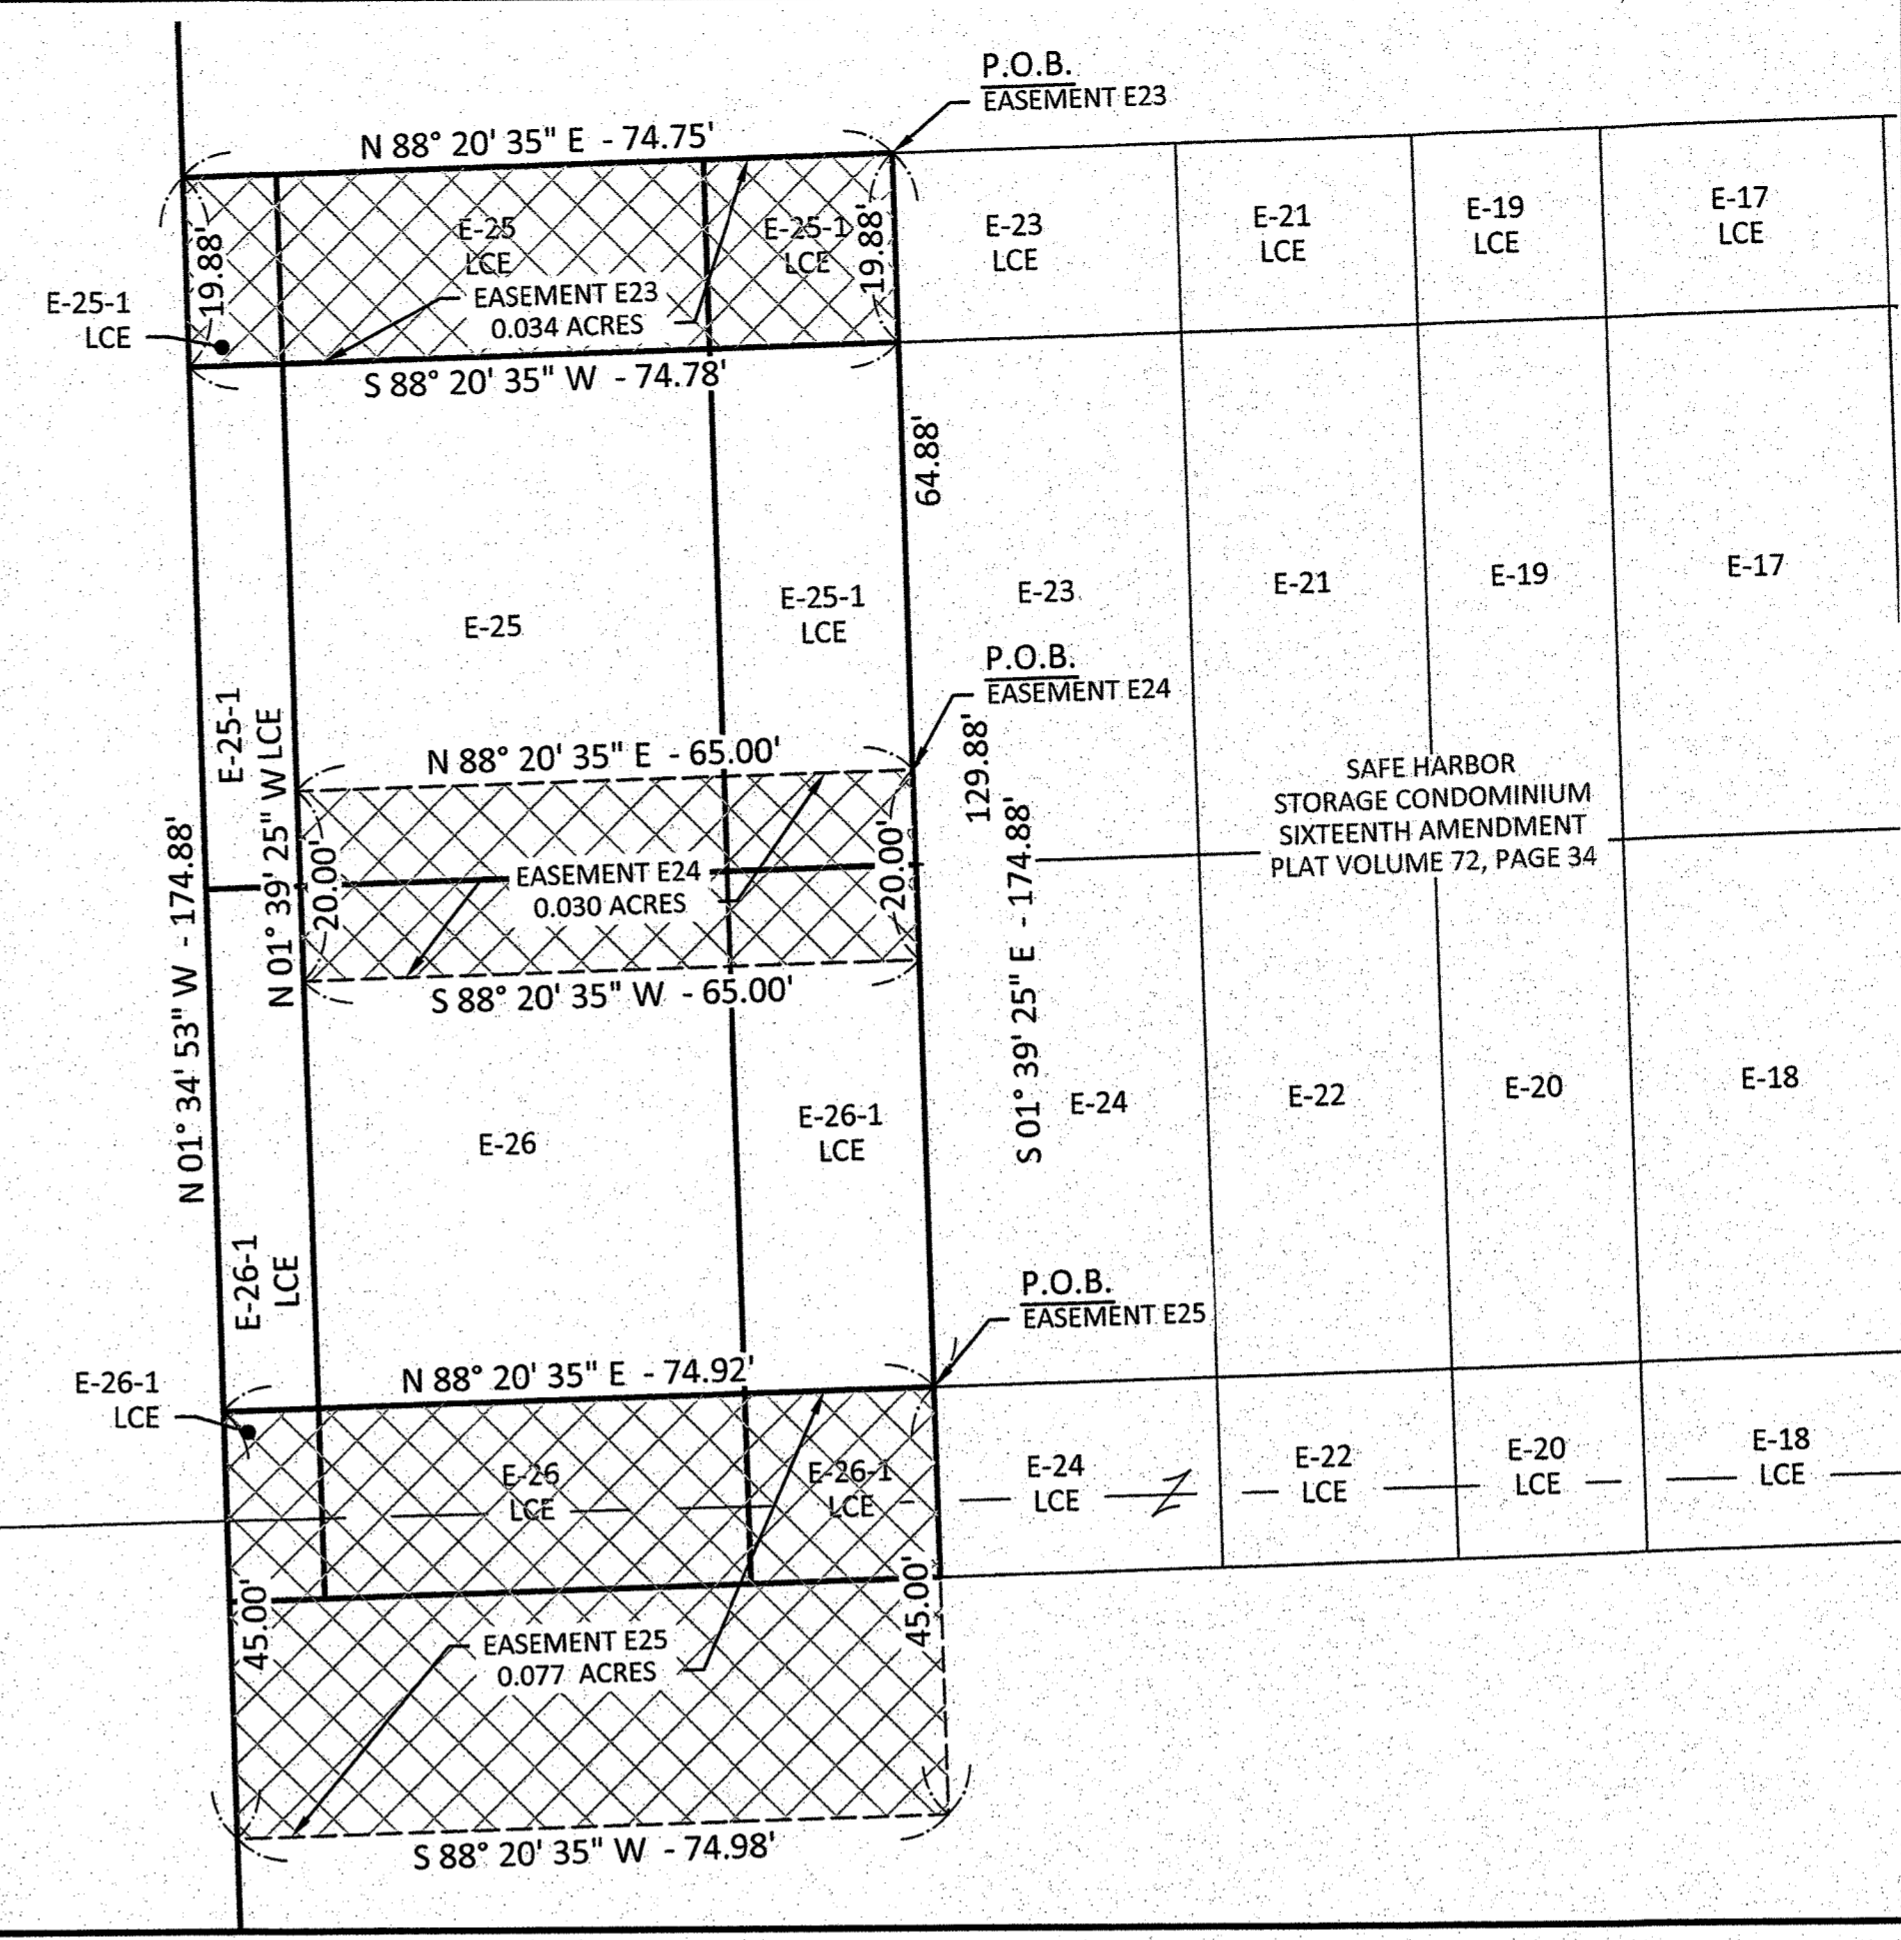

- LEGEND**
- MONUMENT FOUND
  - MONUMENT SET
  - (C) CALCULATED DISTANCE
  - (M) MEASURED DISTANCE
  - (REC) RECORD DISTANCE
  - R/W RIGHT-OF-WAY
  - P.O.B. POINT OF BEGINNING
  - P.O.C. POINT OF COMMENCEMENT
  - ▨ UNITS
  - ▨ LIMITED COMMON ELEMENT
  - ▨ EASEMENT

- REFERENCES**
- DEEDS AS SHOWN.
  - SAFE HARBOR STORAGE CONDOMINIUM FIRST AMENDMENT, PLAT VOLUME 62, PAGE 24.
  - SAFE HARBOR STORAGE CONDOMINIUM, PLAT VOLUME 60, PAGE 17.
  - SAFE HARBOR STORAGE CONDOMINIUM THIRD AMENDMENT, PLAT VOLUME 63, PAGE 48.
  - SAFE HARBOR STORAGE CONDOMINIUM FOURTH AMENDMENT, PLAT VOLUME 64, PAGE 29.
  - SAFE HARBOR STORAGE CONDOMINIUM FIFTH AMENDMENT, PLAT VOLUME 65, PAGE 2.
  - SAFE HARBOR STORAGE CONDOMINIUM SIXTH AMENDMENT, PLAT VOLUME 66, PAGE 17.
  - SAFE HARBOR STORAGE CONDOMINIUM SEVENTH AMENDMENT, PLAT VOLUME 67, PAGE 36.
  - SAFE HARBOR STORAGE CONDOMINIUM EIGHTH AMENDMENT, PLAT VOLUME 67, PAGE 50.
  - SAFE HARBOR STORAGE CONDOMINIUM ELEVENTH AMENDMENT, PLAT VOLUME 69, PAGE 13.
  - SAFE HARBOR STORAGE CONDOMINIUM TWELFTH AMENDMENT, PLAT VOLUME 69, PAGE 55.
  - SAFE HARBOR STORAGE CONDOMINIUM THIRTEENTH AMENDMENT, PLAT VOLUME 70, PAGE 47.
  - SAFE HARBOR STORAGE CONDOMINIUM FOURTEENTH AMENDMENT, PLAT VOLUME 71, PAGE 21.
  - SAFE HARBOR STORAGE CONDOMINIUM FIFTEENTH AMENDMENT, DEED BOOK 1833, PAGE 132.
  - SAFE HARBOR STORAGE CONDOMINIUM SIXTEENTH AMENDMENT, PLAT VOLUME 72, PAGE 34.

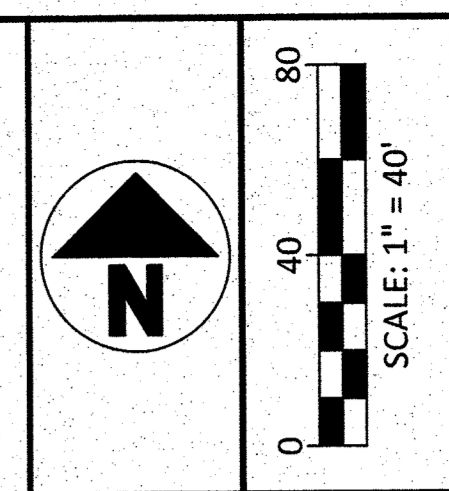

NO	REVISION	DATE
9		
8		
7		
6		
5		
4		
3		
2		
1		
NO		

**DGL**  
 CONSULTING ENGINEERS, LLC  
 3455 MAUMEE OH 44137  
 PHONE 419.535.1015  
 www.dgl-tld.com

**SAFE HARBOR STORAGE CONDOMINIUM SEVENTEENTH AMENDMENT**  
 LOCATED IN PART OF LOT 03, SECTION 04, DANBURY TOWNSHIP, OTTAWA COUNTY, OHIO.

FILE:	SEVENTEENTH
JOB NO.:	19082
DRAWN BY:	GSW
ISSUED:	12/16/2021