



PLOTTED: Sep 28, 2022 - 1:36pm
 DRAWING: W:\22060 (Safe Harbor Development - Storage Condo Ph 2)\SURVEY\DWG\22060 Safe Harbor Condominiums Eighteenth Amendment.dwg - PAGE1

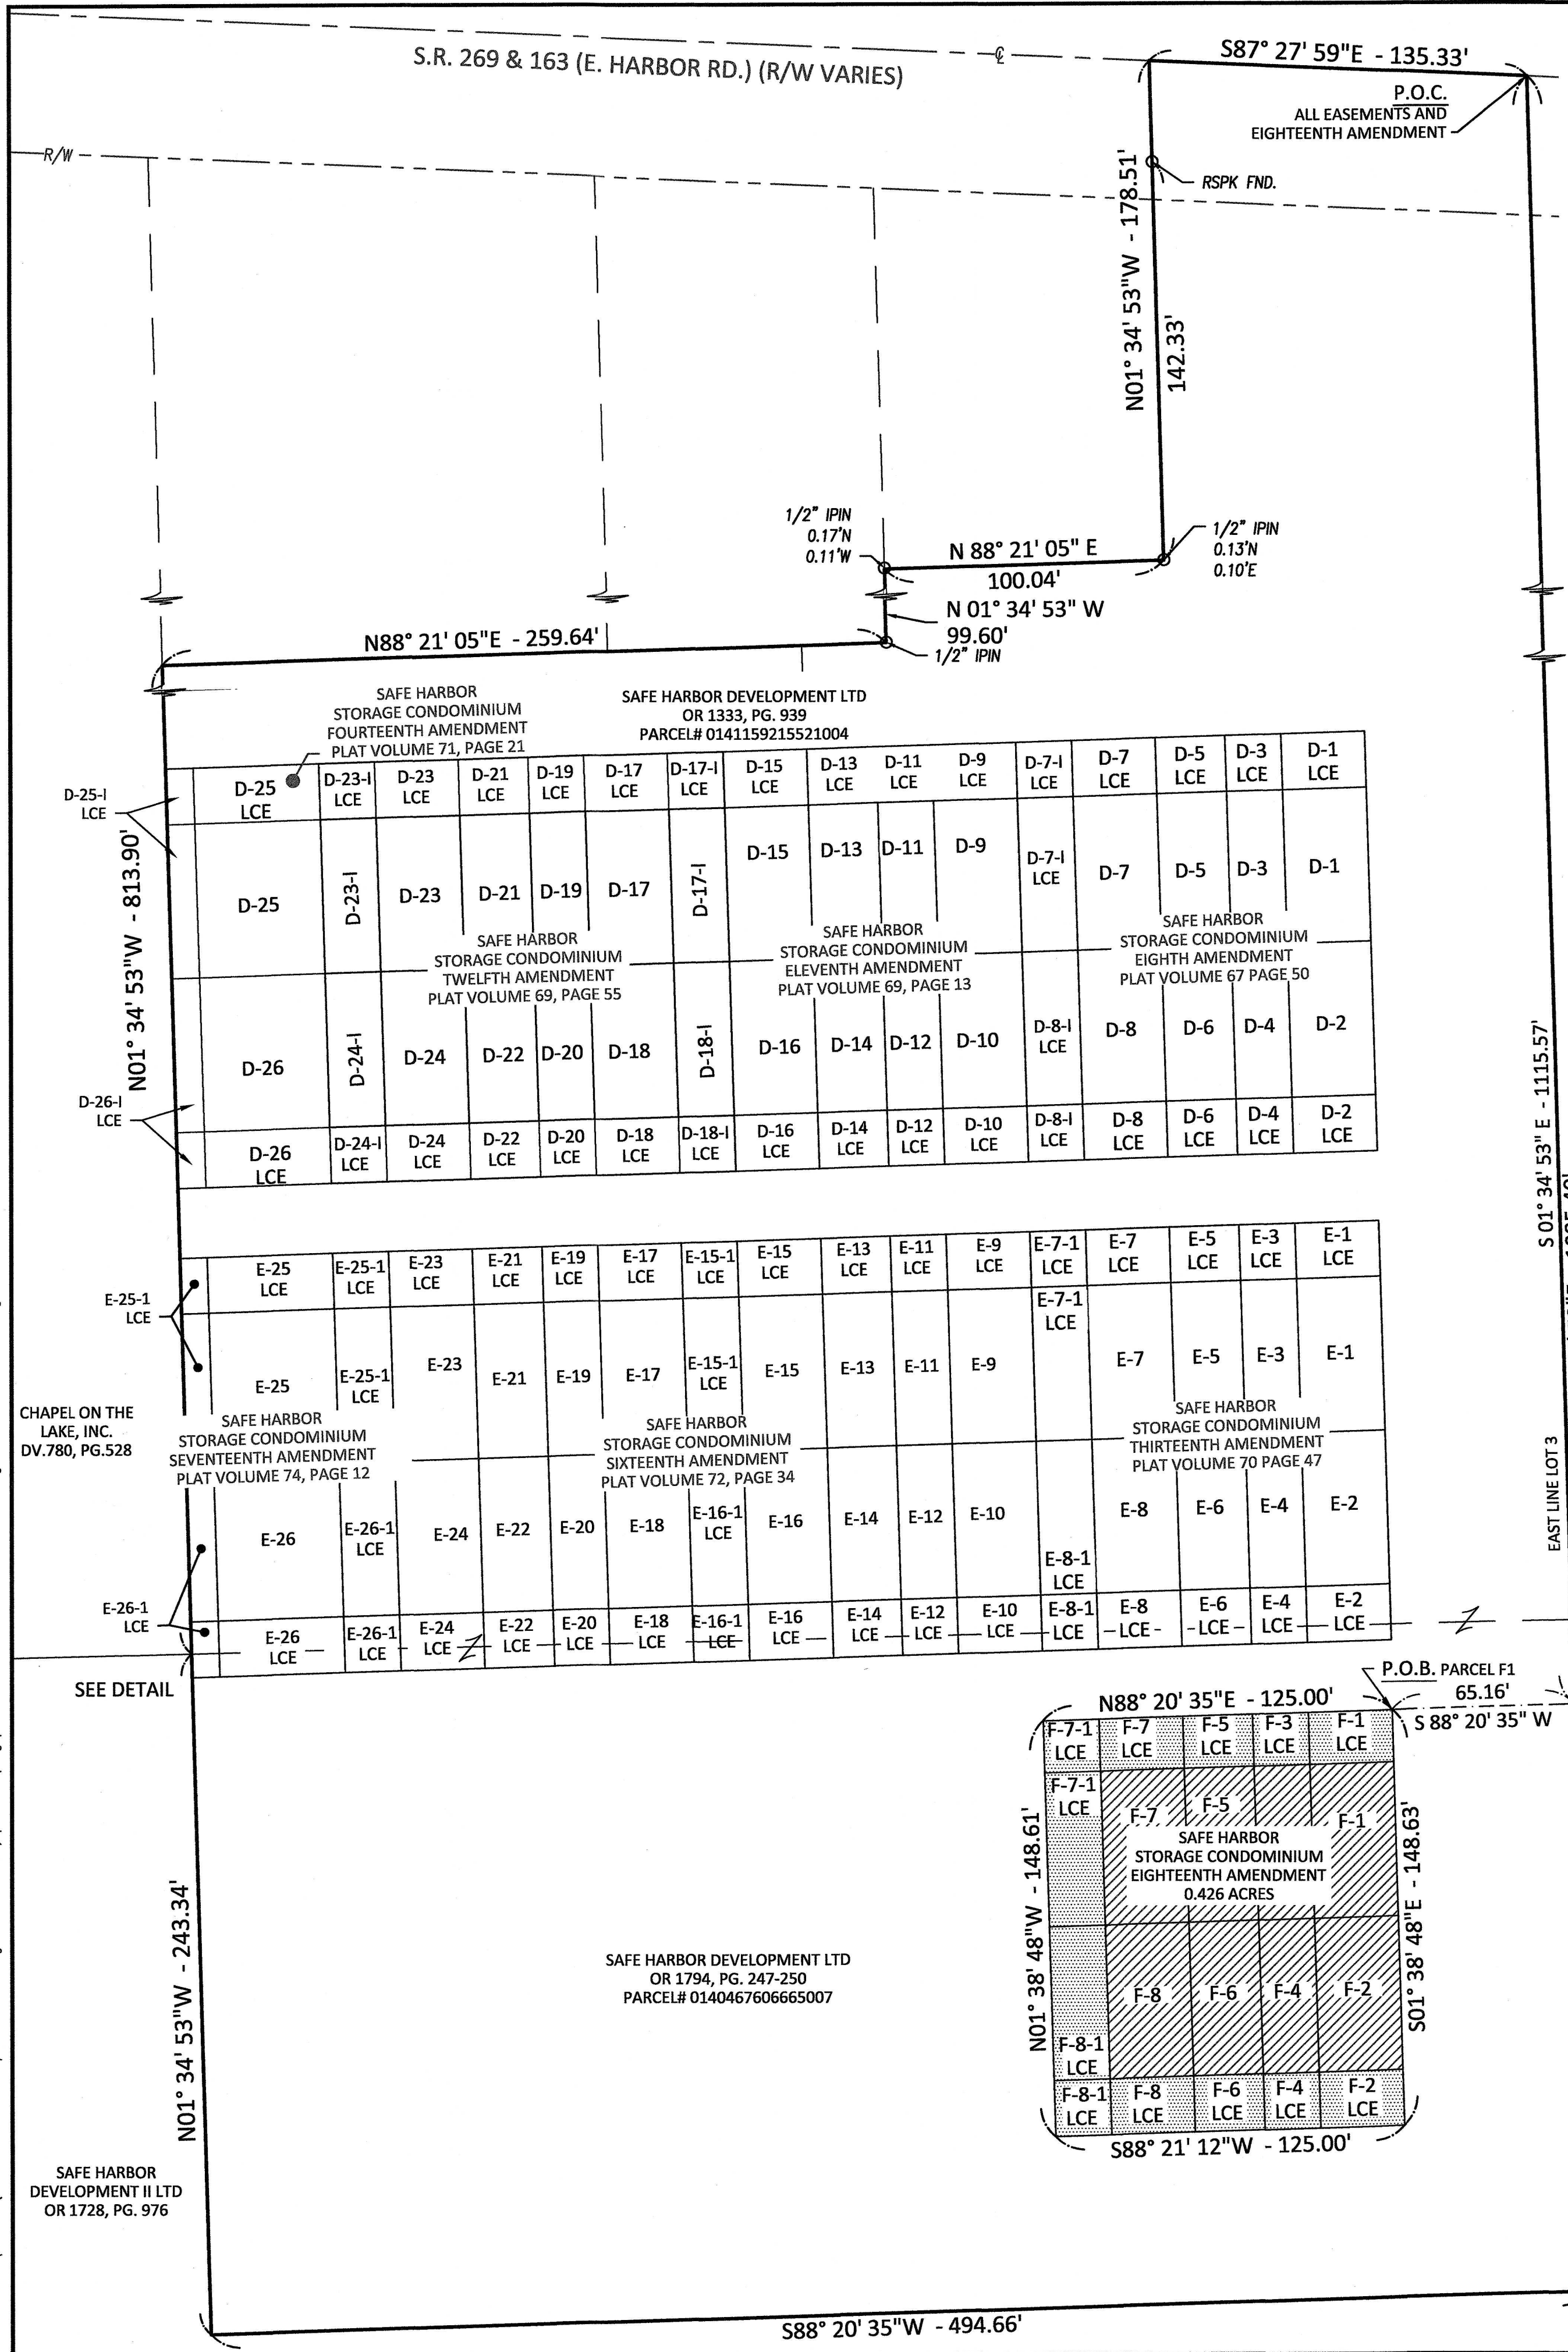

EAST LINE LOT 3
 WEST LINE LOT 2
 S 01° 34' 53" E - 1115.57'
 S 01° 34' 53" E - 1085.40'

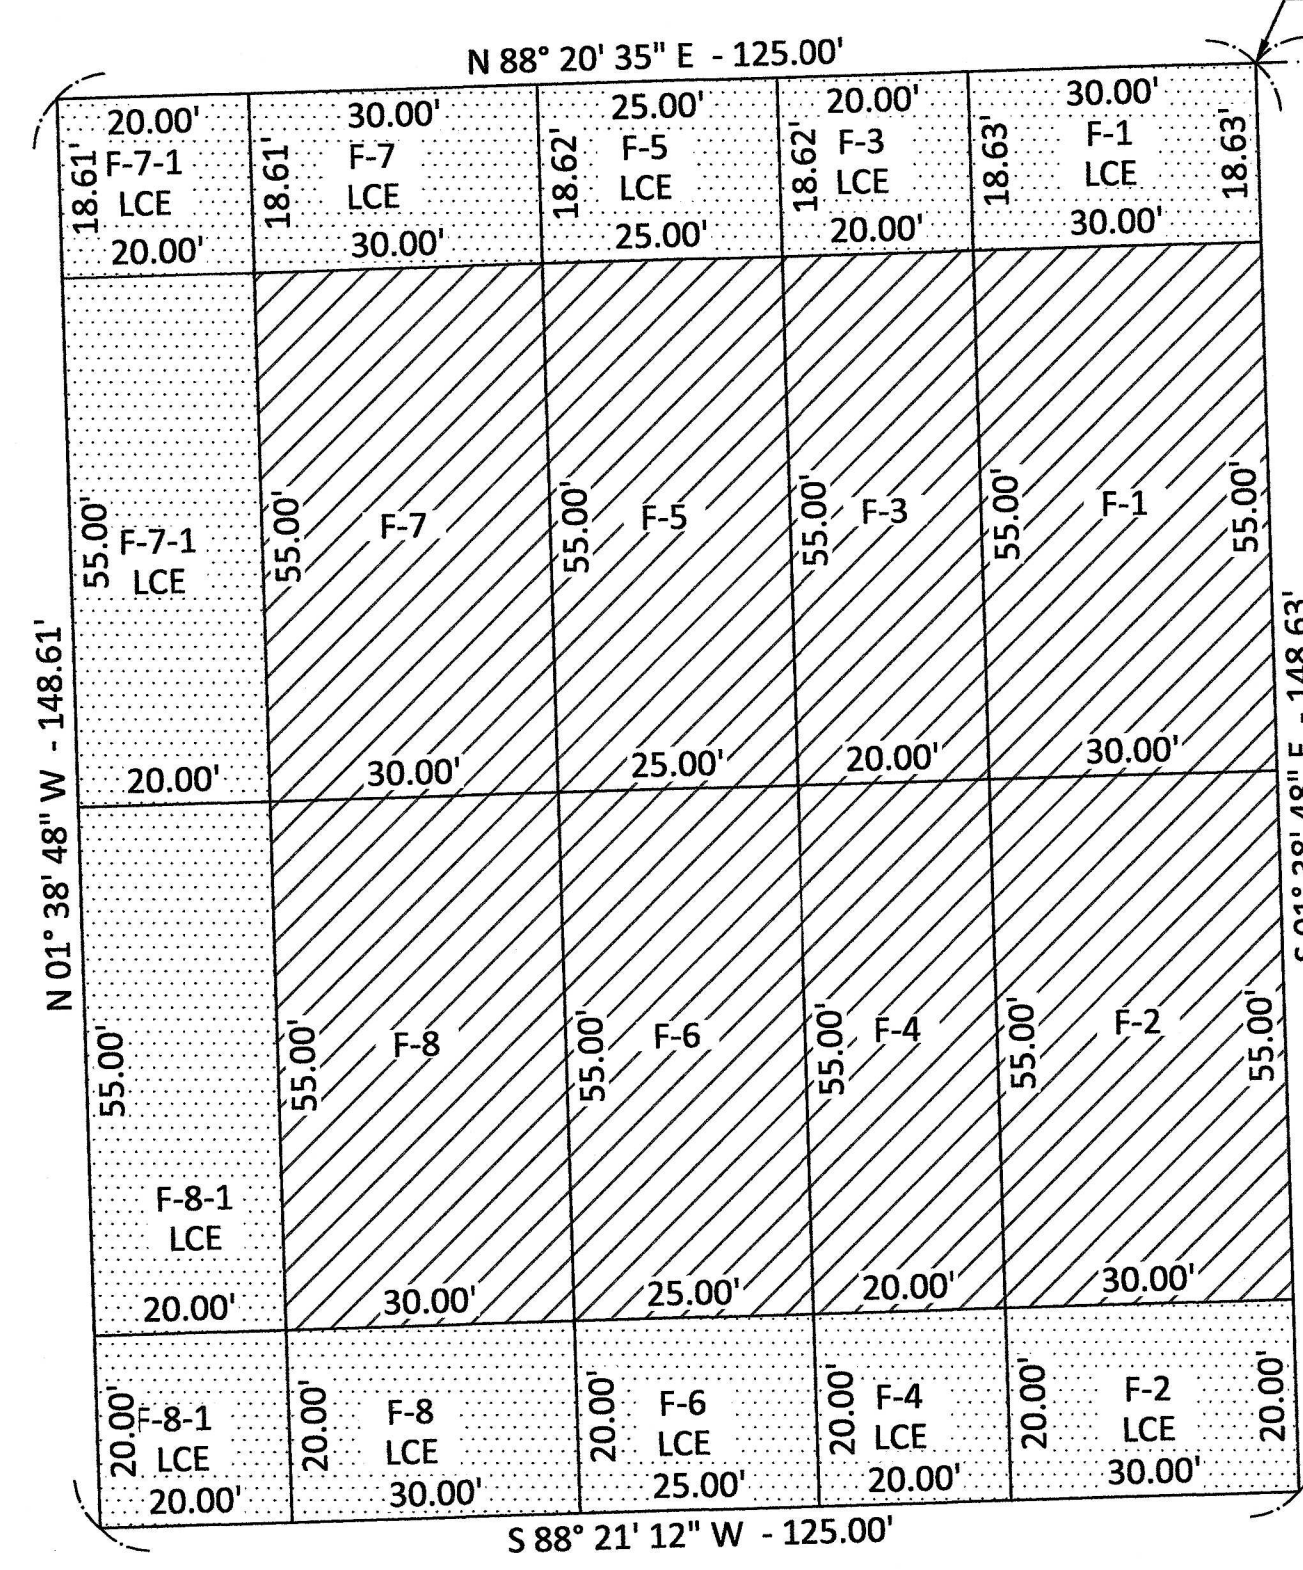

EIGHTEENTH AMENDMENT

- REFERENCES**
- DEEDS AS SHOWN.
 - SAFE HARBOR STORAGE CONDOMINIUM FIRST AMENDMENT, PLAT VOLUME 62, PAGE 24.
 - SAFE HARBOR STORAGE CONDOMINIUM, PLAT VOLUME 60, PAGE 17.
 - SAFE HARBOR STORAGE CONDOMINIUM THIRD AMENDMENT, PLAT VOLUME 63, PAGE 48.
 - SAFE HARBOR STORAGE CONDOMINIUM FOURTH AMENDMENT, PLAT VOLUME 64, PAGE 29.
 - SAFE HARBOR STORAGE CONDOMINIUM FIFTH AMENDMENT, PLAT VOLUME 65, PAGE 2.
 - SAFE HARBOR STORAGE CONDOMINIUM SIXTH AMENDMENT, PLAT VOLUME 66, PAGE 17.
 - SAFE HARBOR STORAGE CONDOMINIUM SEVENTH AMENDMENT, PLAT VOLUME 67, PAGE 36.
 - SAFE HARBOR STORAGE CONDOMINIUM EIGHTH AMENDMENT, PLAT VOLUME 67, PAGE 50.
 - SAFE HARBOR STORAGE CONDOMINIUM ELEVENTH AMENDMENT, PLAT VOLUME 69, PAGE 13.
 - SAFE HARBOR STORAGE CONDOMINIUM TWELFTH AMENDMENT, PLAT VOLUME 69, PAGE 55.
 - SAFE HARBOR STORAGE CONDOMINIUM THIRTEENTH AMENDMENT, PLAT VOLUME 70, PAGE 47.
 - SAFE HARBOR STORAGE CONDOMINIUM FOURTEENTH AMENDMENT, PLAT VOLUME 71, PAGE 21.
 - SAFE HARBOR STORAGE CONDOMINIUM FIFTEENTH AMENDMENT, DEED BOOK 1833, PAGE 132.
 - SAFE HARBOR STORAGE CONDOMINIUM SIXTEENTH AMENDMENT, PLAT VOLUME 72, PAGE 34.
 - SAFE HARBOR STORAGE CONDOMINIUM SEVENTEENTH AMENDMENT, PLAT VOLUME 74, PAGE 12.

202200321559 10/13/2022 12:00 PM
 Filed for Record in OTTAWA County, Ohio
 Nathan J. Daniels Rec Fees: \$260.40
 OR Vol 74 Pgs 52 - 55



SURVEYOR'S CERTIFICATION:
 I HEREBY DECLARE THAT THE DRAWING ACCURATELY REFLECTS THE LOCATION OF IMPROVEMENTS AND RECORDED EASEMENTS TO THE BEST OF MY KNOWLEDGE AND BELIEF.

Peter J. Segard
 PETER J. SEGARD, P.S.
 OHIO PROFESSIONAL SURVEYOR NO. 7883

9-28-2022
 DATE



ENGINEER'S CERTIFICATION:
 I HEREBY DECLARE THAT THE DRAWING ACCURATELY SHOWS EACH BUILDING AS BUILT TO THE BEST OF MY KNOWLEDGE AND BELIEF.

Robert W. Bailey
 ROBERT W. BAILEY, P.E.
 OHIO PROFESSIONAL ENGINEER NO. 62836

9-28-22
 DATE

LEGEND	DATE	REVISION
○ MONUMENT FOUND		
● CALCULATED DISTANCE		
(M) MEASURED DISTANCE		
(R) RECORD DISTANCE		
R/W RIGHT-OF-WAY		
P.O.B. POINT OF BEGINNING		
P.O.C. POINT OF COMMENCEMENT		
ZZZ UNITS LIMITED COMMON ELEMENT		
--- FENCE		



SAFE HARBOR STORAGE CONDOMINIUM EIGHTEENTH AMENDMENT

LOCATED IN PART OF LOT 03, SECTION 04, DANBURY TOWNSHIP, OTTAWA COUNTY, OHIO.

FILE:	EIGHTEENTH
JOB NO.:	22060-1
DRAWN BY:	PJS/GSW
ISSUED:	9/15/2022

1/4


PLOTTED: Sep 28, 2022 - 1:34pm
 DRAWING: M:\22060 (Safe Harbor Development - Storage Condo Ph 2)\SURVE\DWG\22x34 Safe Harbor Condominiums Eighteenth Amendment.dwg, PAGEZ

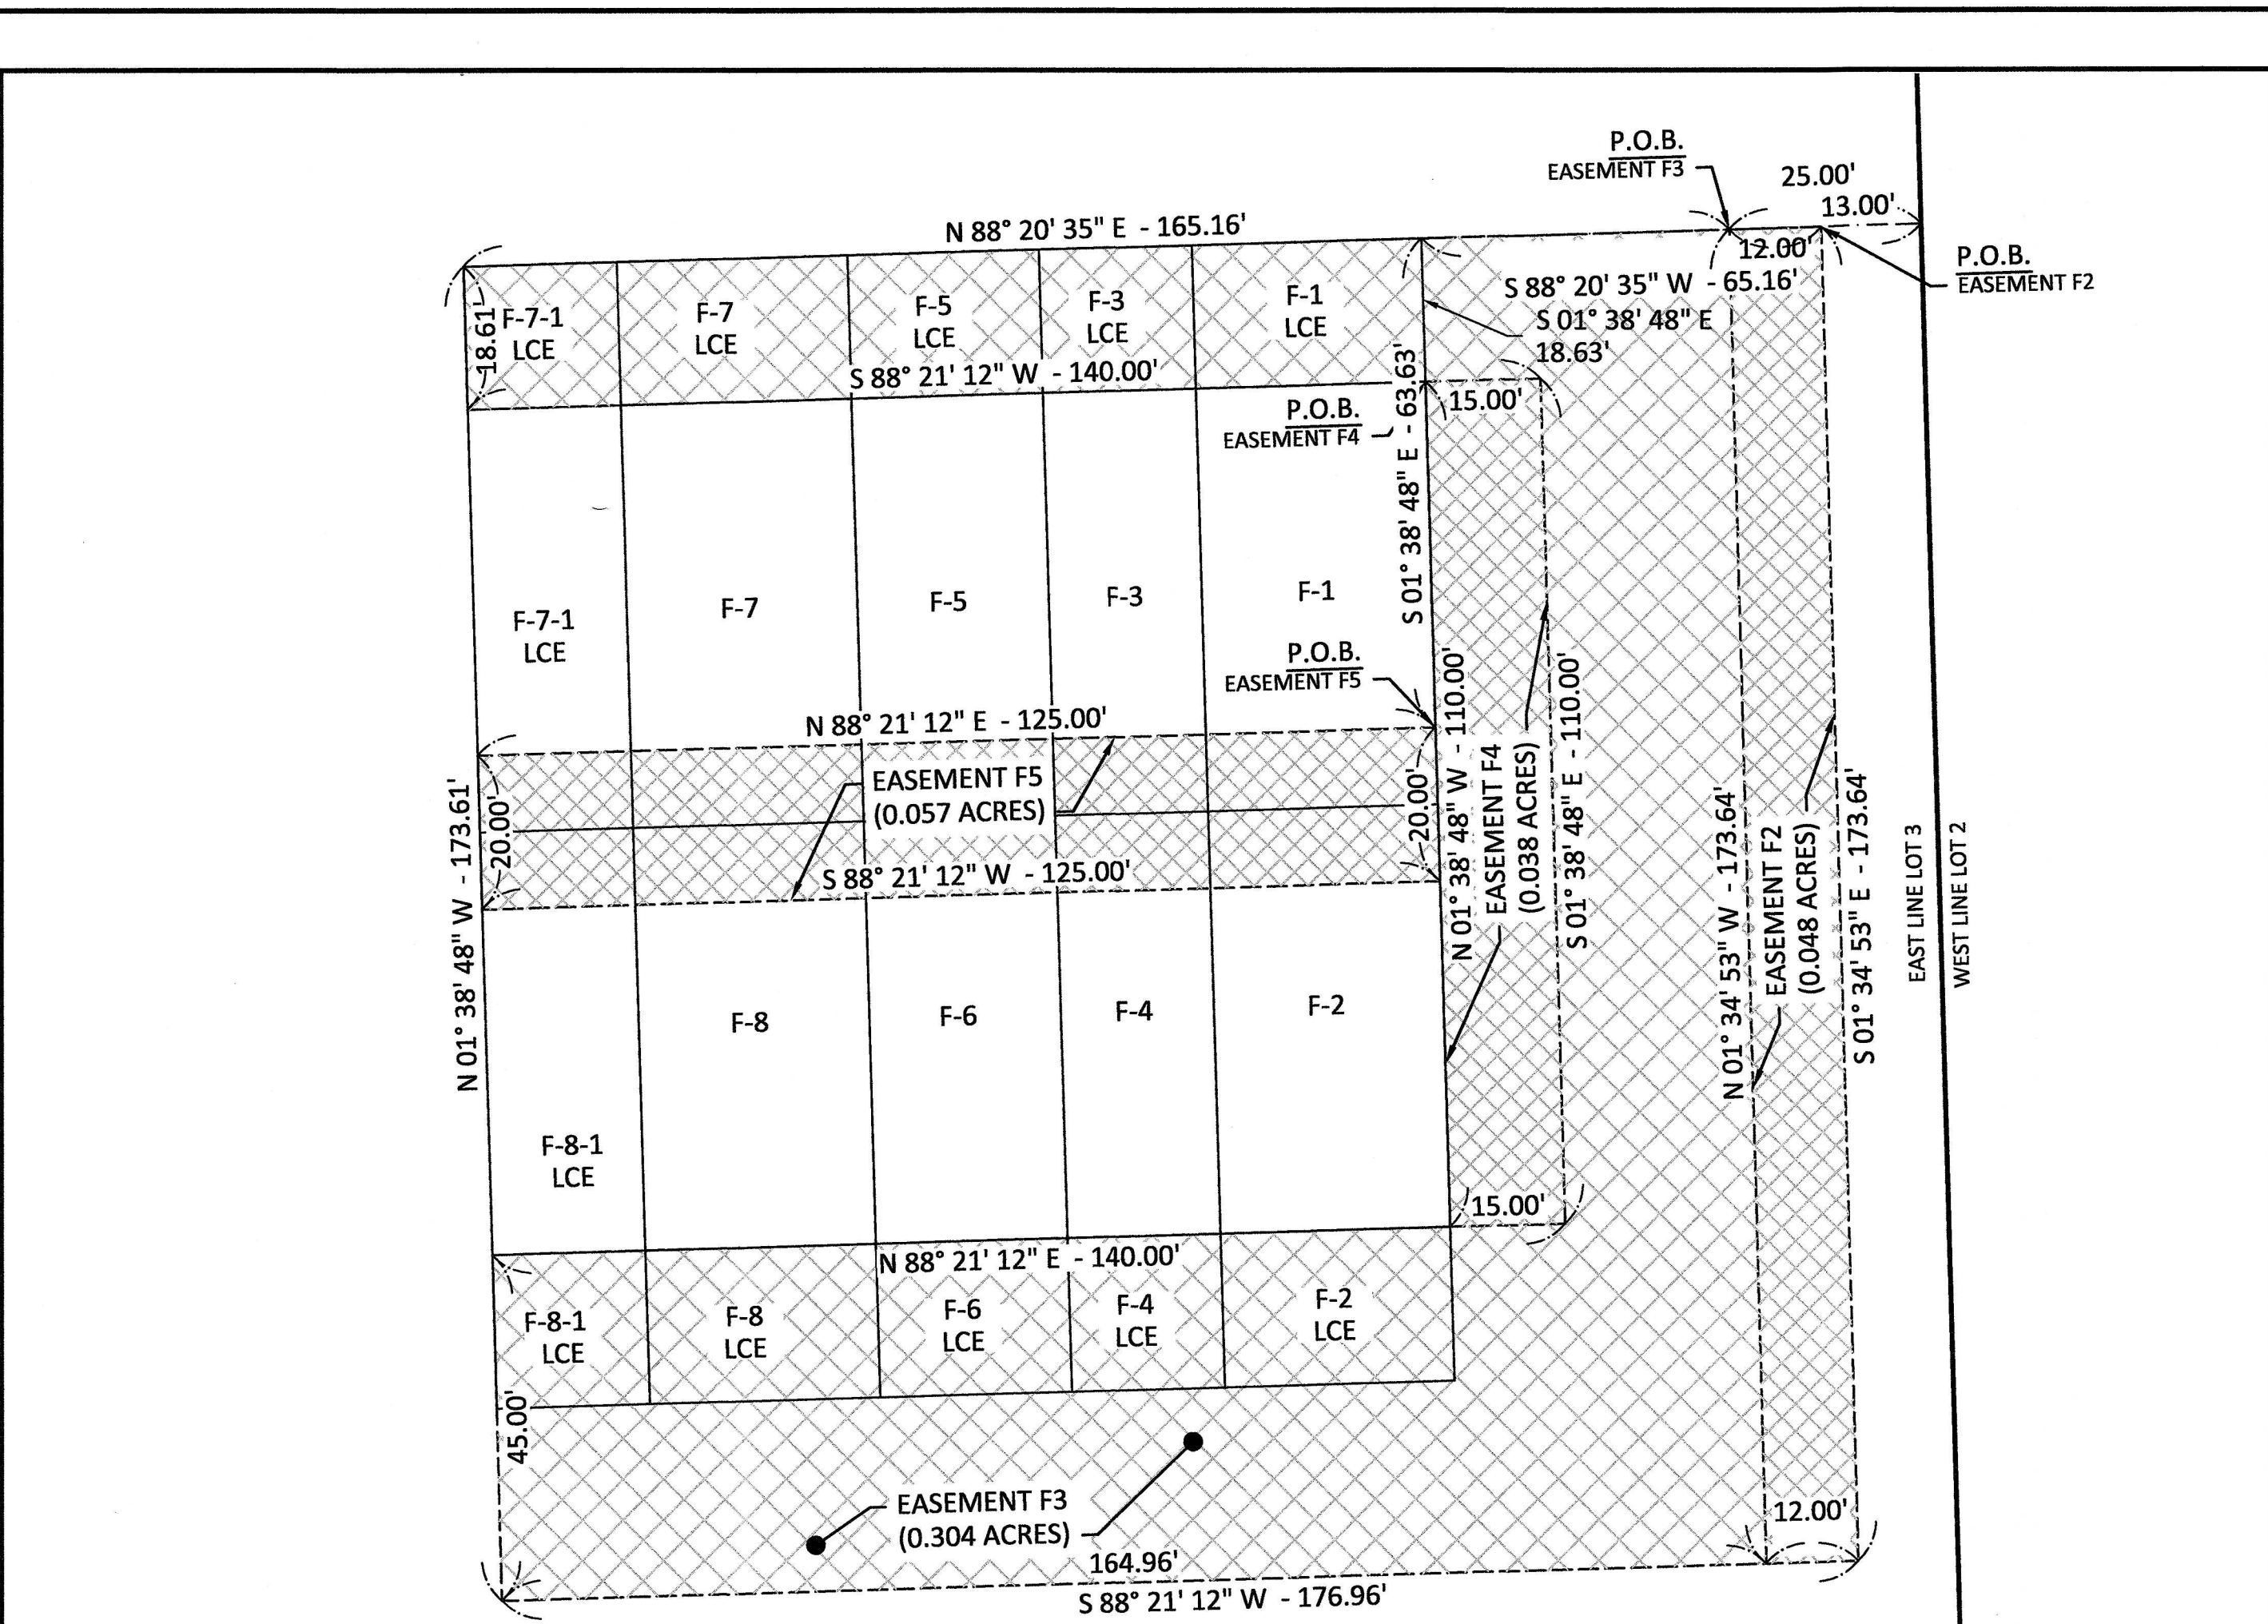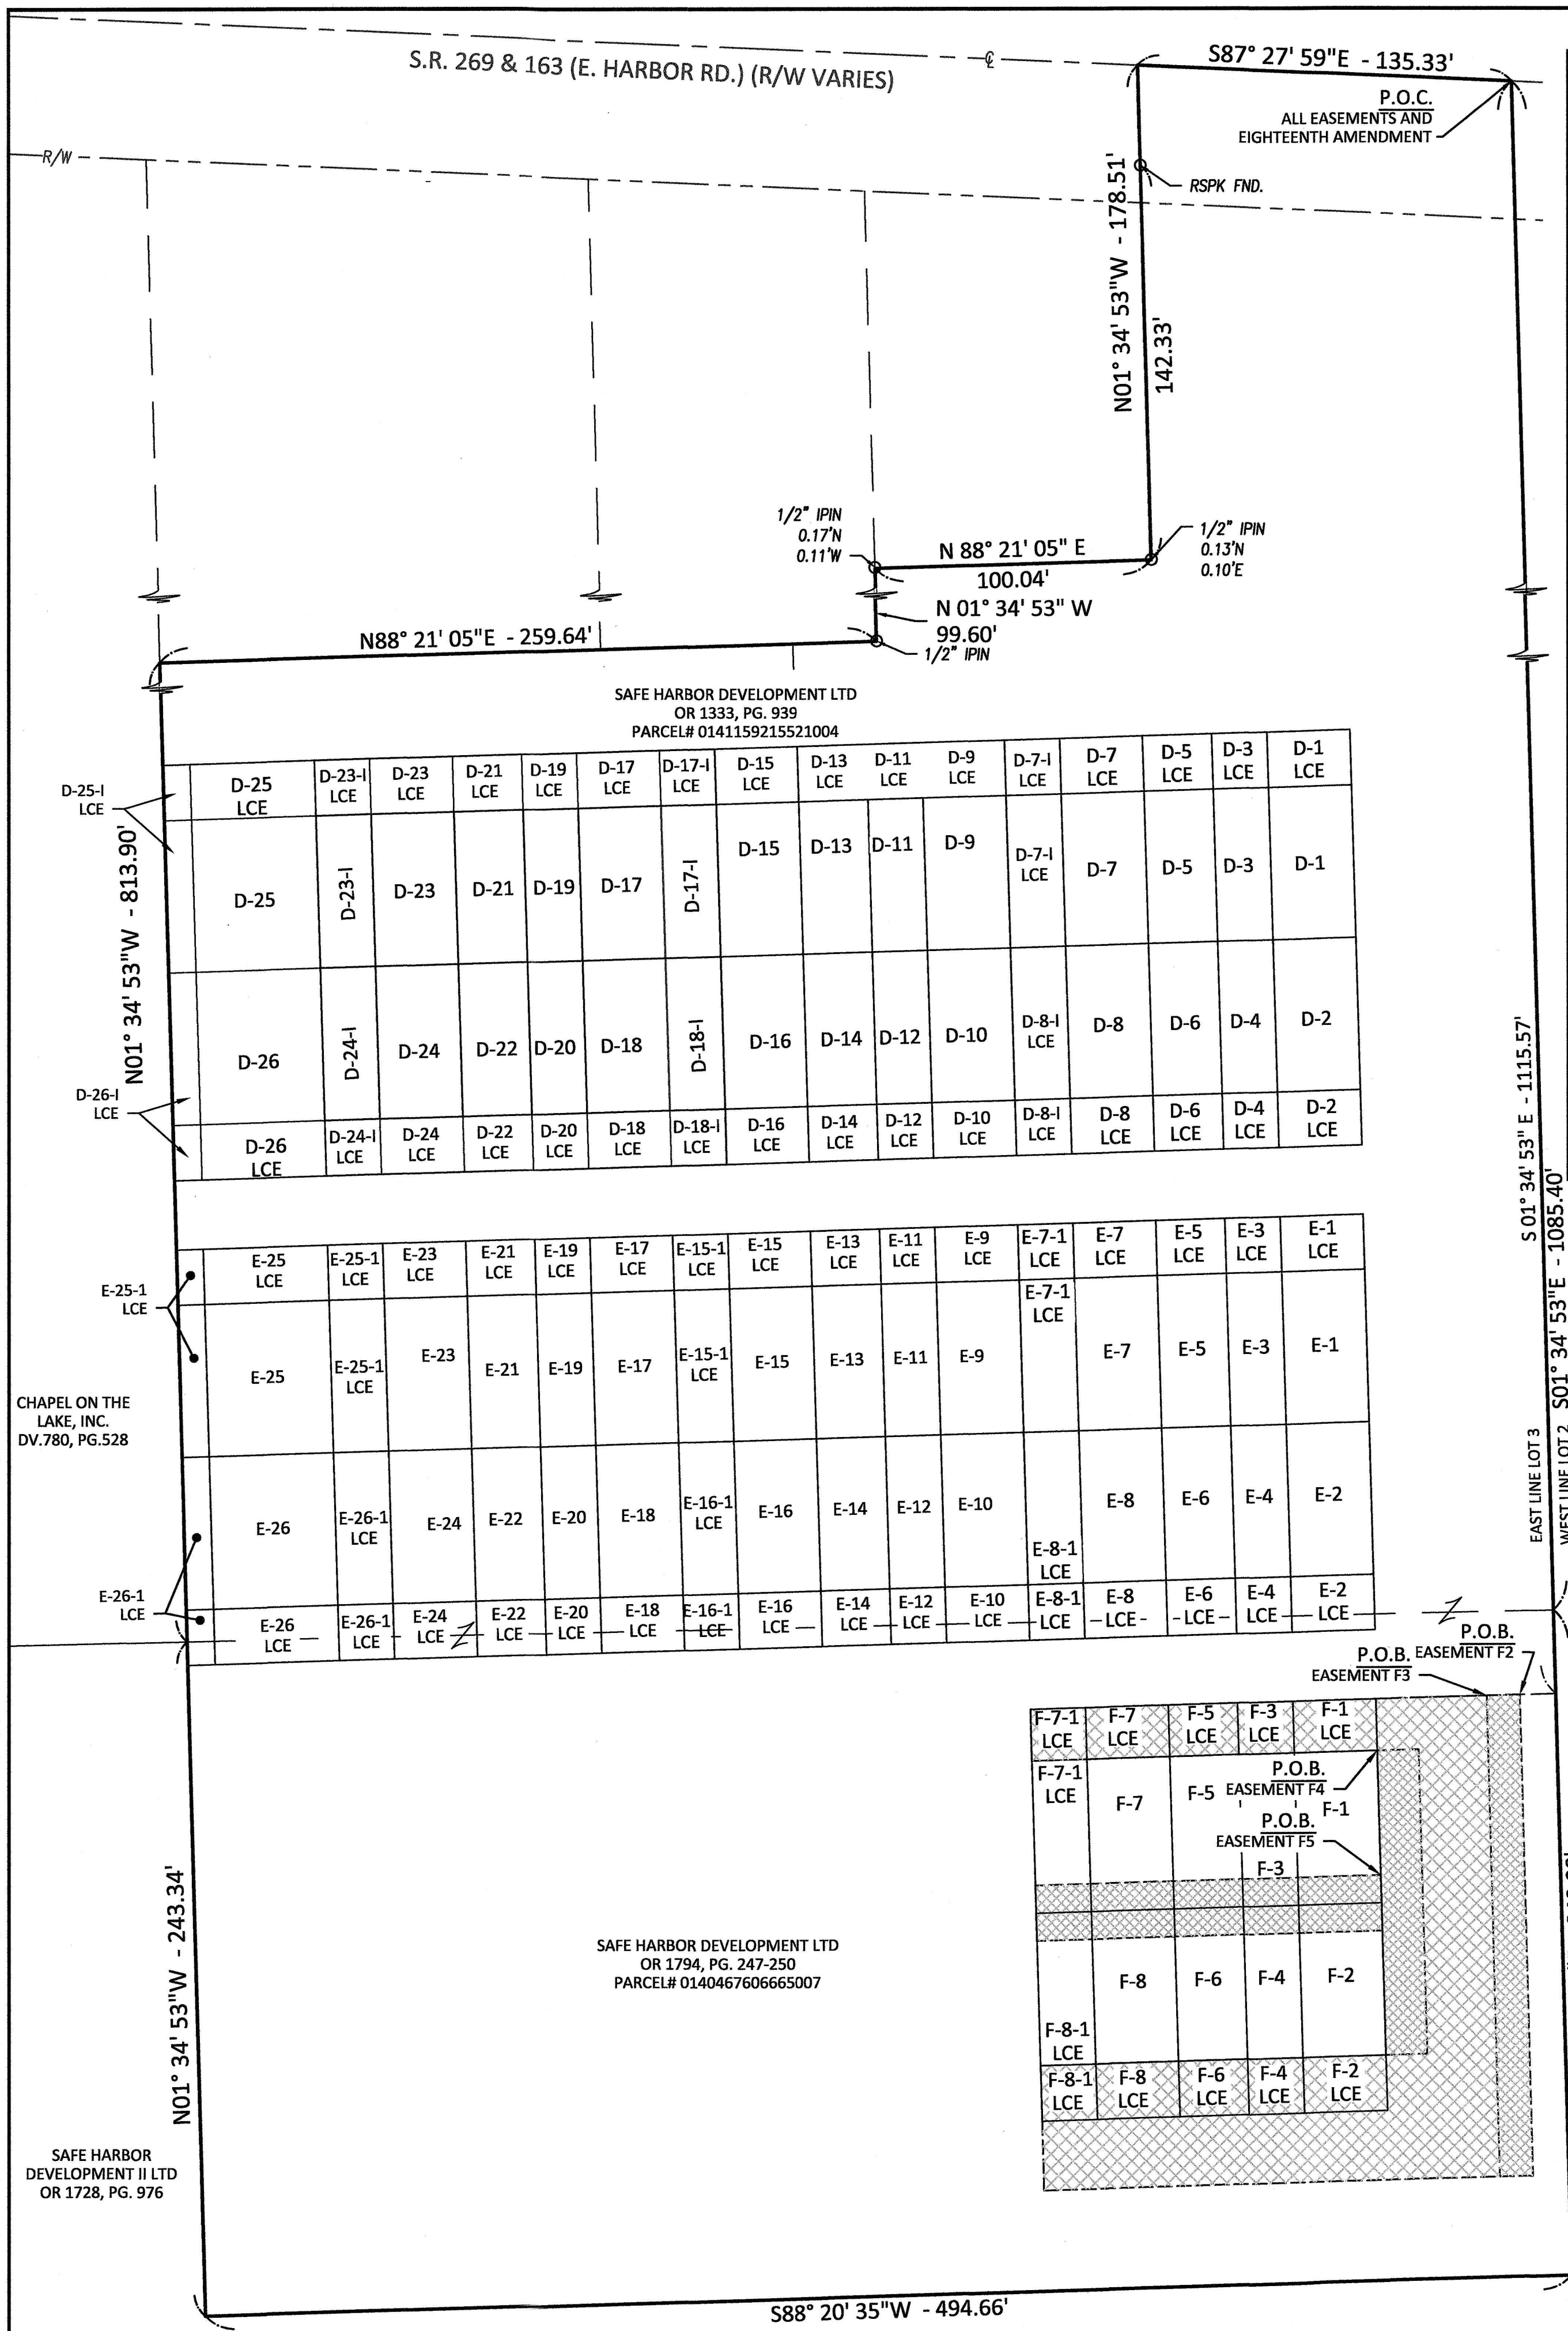

SCALE: 1"=20'

REFERENCES

- DEEDS AS SHOWN.
- SAFE HARBOR STORAGE CONDOMINIUM FIRST AMENDMENT, PLAT VOLUME 62, PAGE 24.
- SAFE HARBOR STORAGE CONDOMINIUM, PLAT VOLUME 60, PAGE 17.
- SAFE HARBOR STORAGE CONDOMINIUM THIRD AMENDMENT, PLAT VOLUME 63, PAGE 48.
- SAFE HARBOR STORAGE CONDOMINIUM FOURTH AMENDMENT, PLAT VOLUME 64, PAGE 29.
- SAFE HARBOR STORAGE CONDOMINIUM FIFTH AMENDMENT, PLAT VOLUME 65, PAGE 2.
- SAFE HARBOR STORAGE CONDOMINIUM SIXTH AMENDMENT, PLAT VOLUME 66, PAGE 17.
- SAFE HARBOR STORAGE CONDOMINIUM SEVENTH AMENDMENT, PLAT VOLUME 67, PAGE 36.
- SAFE HARBOR STORAGE CONDOMINIUM EIGHTH AMENDMENT, PLAT VOLUME 67, PAGE 50.
- SAFE HARBOR STORAGE CONDOMINIUM ELEVENTH AMENDMENT, PLAT VOLUME 69, PAGE 13.
- SAFE HARBOR STORAGE CONDOMINIUM TWELFTH AMENDMENT, PLAT VOLUME 69, PAGE 55.
- SAFE HARBOR STORAGE CONDOMINIUM THIRTEENTH AMENDMENT, PLAT VOLUME 70, PAGE 47.
- SAFE HARBOR STORAGE CONDOMINIUM FOURTEENTH AMENDMENT, PLAT VOLUME 71, PAGE 21.
- SAFE HARBOR STORAGE CONDOMINIUM FIFTEENTH AMENDMENT, DEED BOOK 1833, PAGE 132.
- SAFE HARBOR STORAGE CONDOMINIUM SIXTEENTH AMENDMENT, PLAT VOLUME 72, PAGE 34.
- SAFE HARBOR STORAGE CONDOMINIUM SEVENTEENTH AMENDMENT, PLAT VOLUME 74, PAGE 12.

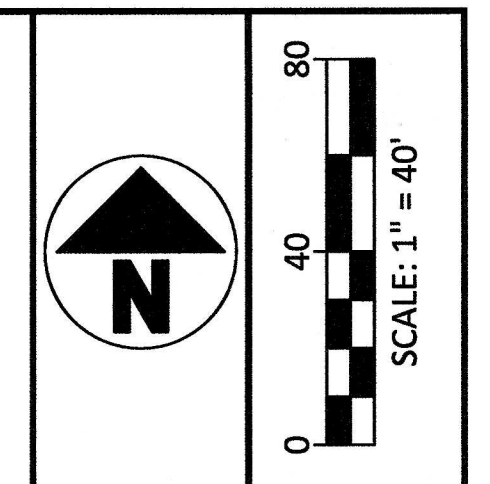

NO	REVISION	DATE
9		
8		
7		
6		
5		
4		
3		
2		
1		

DGL CONSULTING ENGINEERS, LLC
 3455 BRIARFIELD BLVD, SUITE E
 WILMINGTON, OH 43087
 PHONE: 419.535.1015
 www.dgl-ltd.com

SAFE HARBOR STORAGE CONDOMINIUM EIGHTEENTH AMENDMENT

LOCATED IN PART OF LOT 03, SECTION 04, DANBURY TOWNSHIP, OTTAWA COUNTY, OHIO.

FILE:	EIGHTEENTH
JOB NO.:	22060-1
DRAWN BY:	PJS/GSW
ISSUED:	9/15/2022