
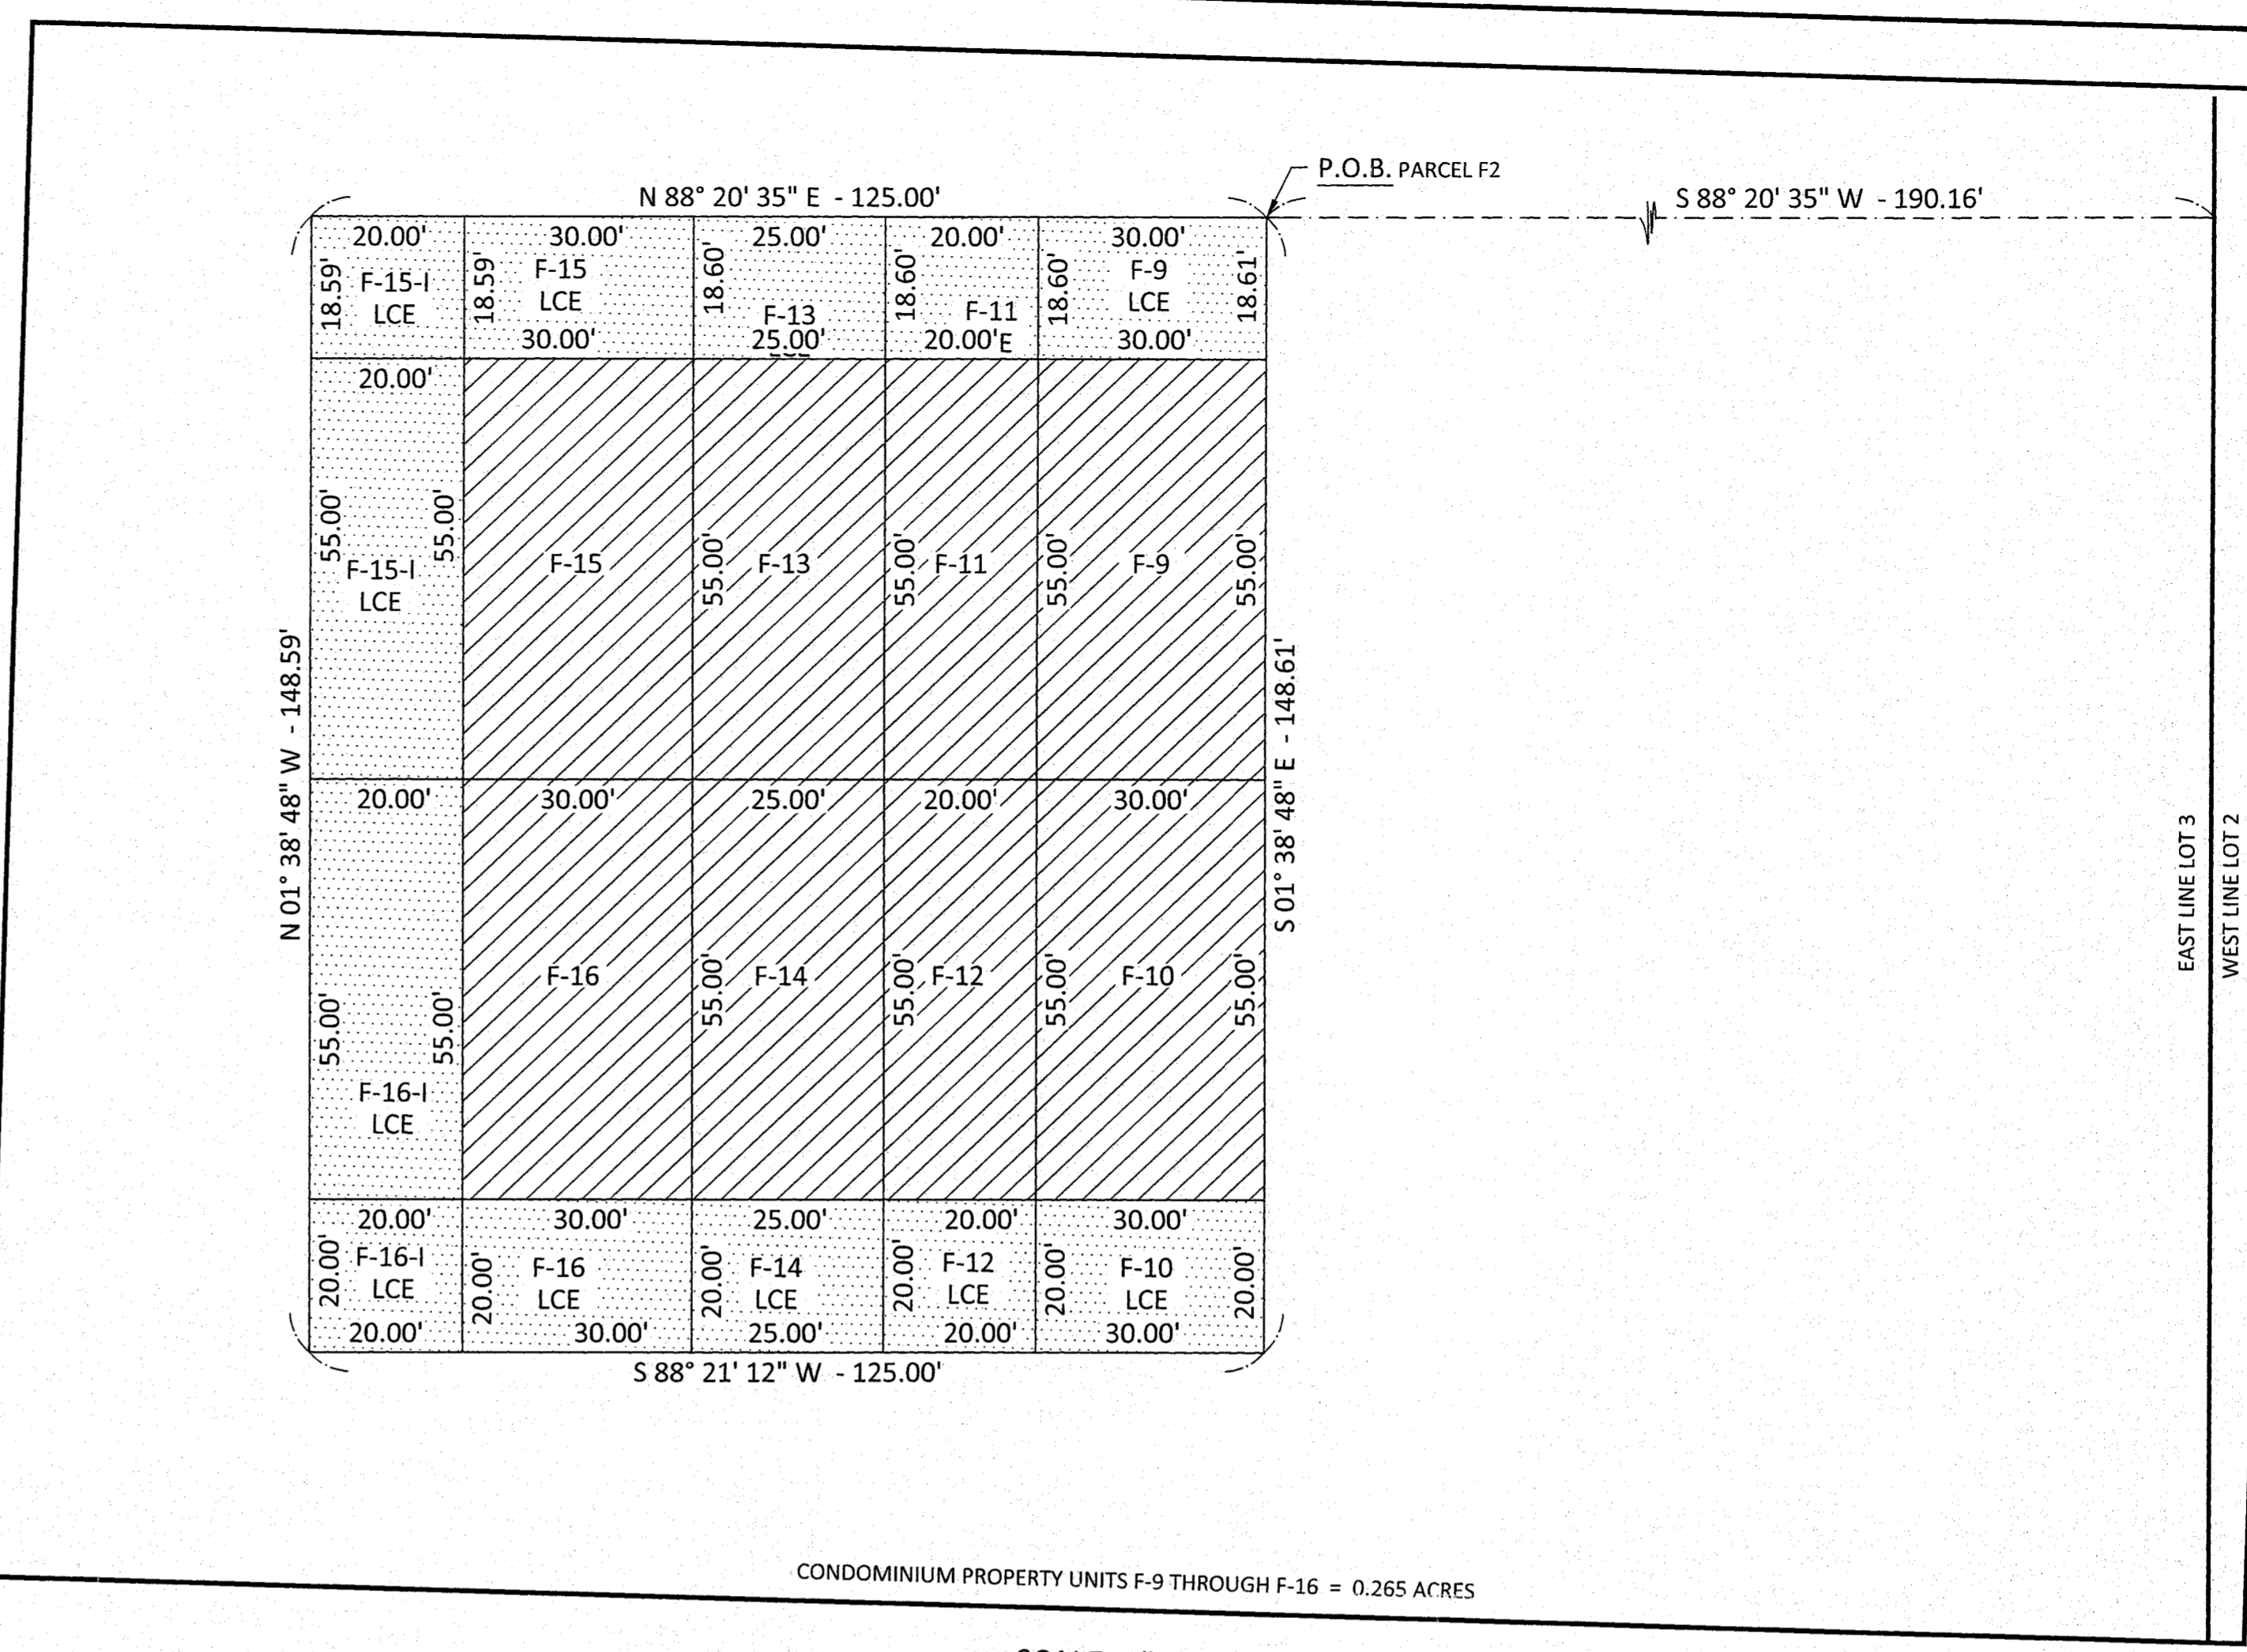


PLOTTED: Oct 31, 2022 - 1:47pm
 DRAWING: M:\22060 (Safe Harbor Development - Storage Condo Ph 2)\SURVEY\DWG\22x34 Safe Harbor Condominiums Nineteenth Amendment.dwg - PAGE1

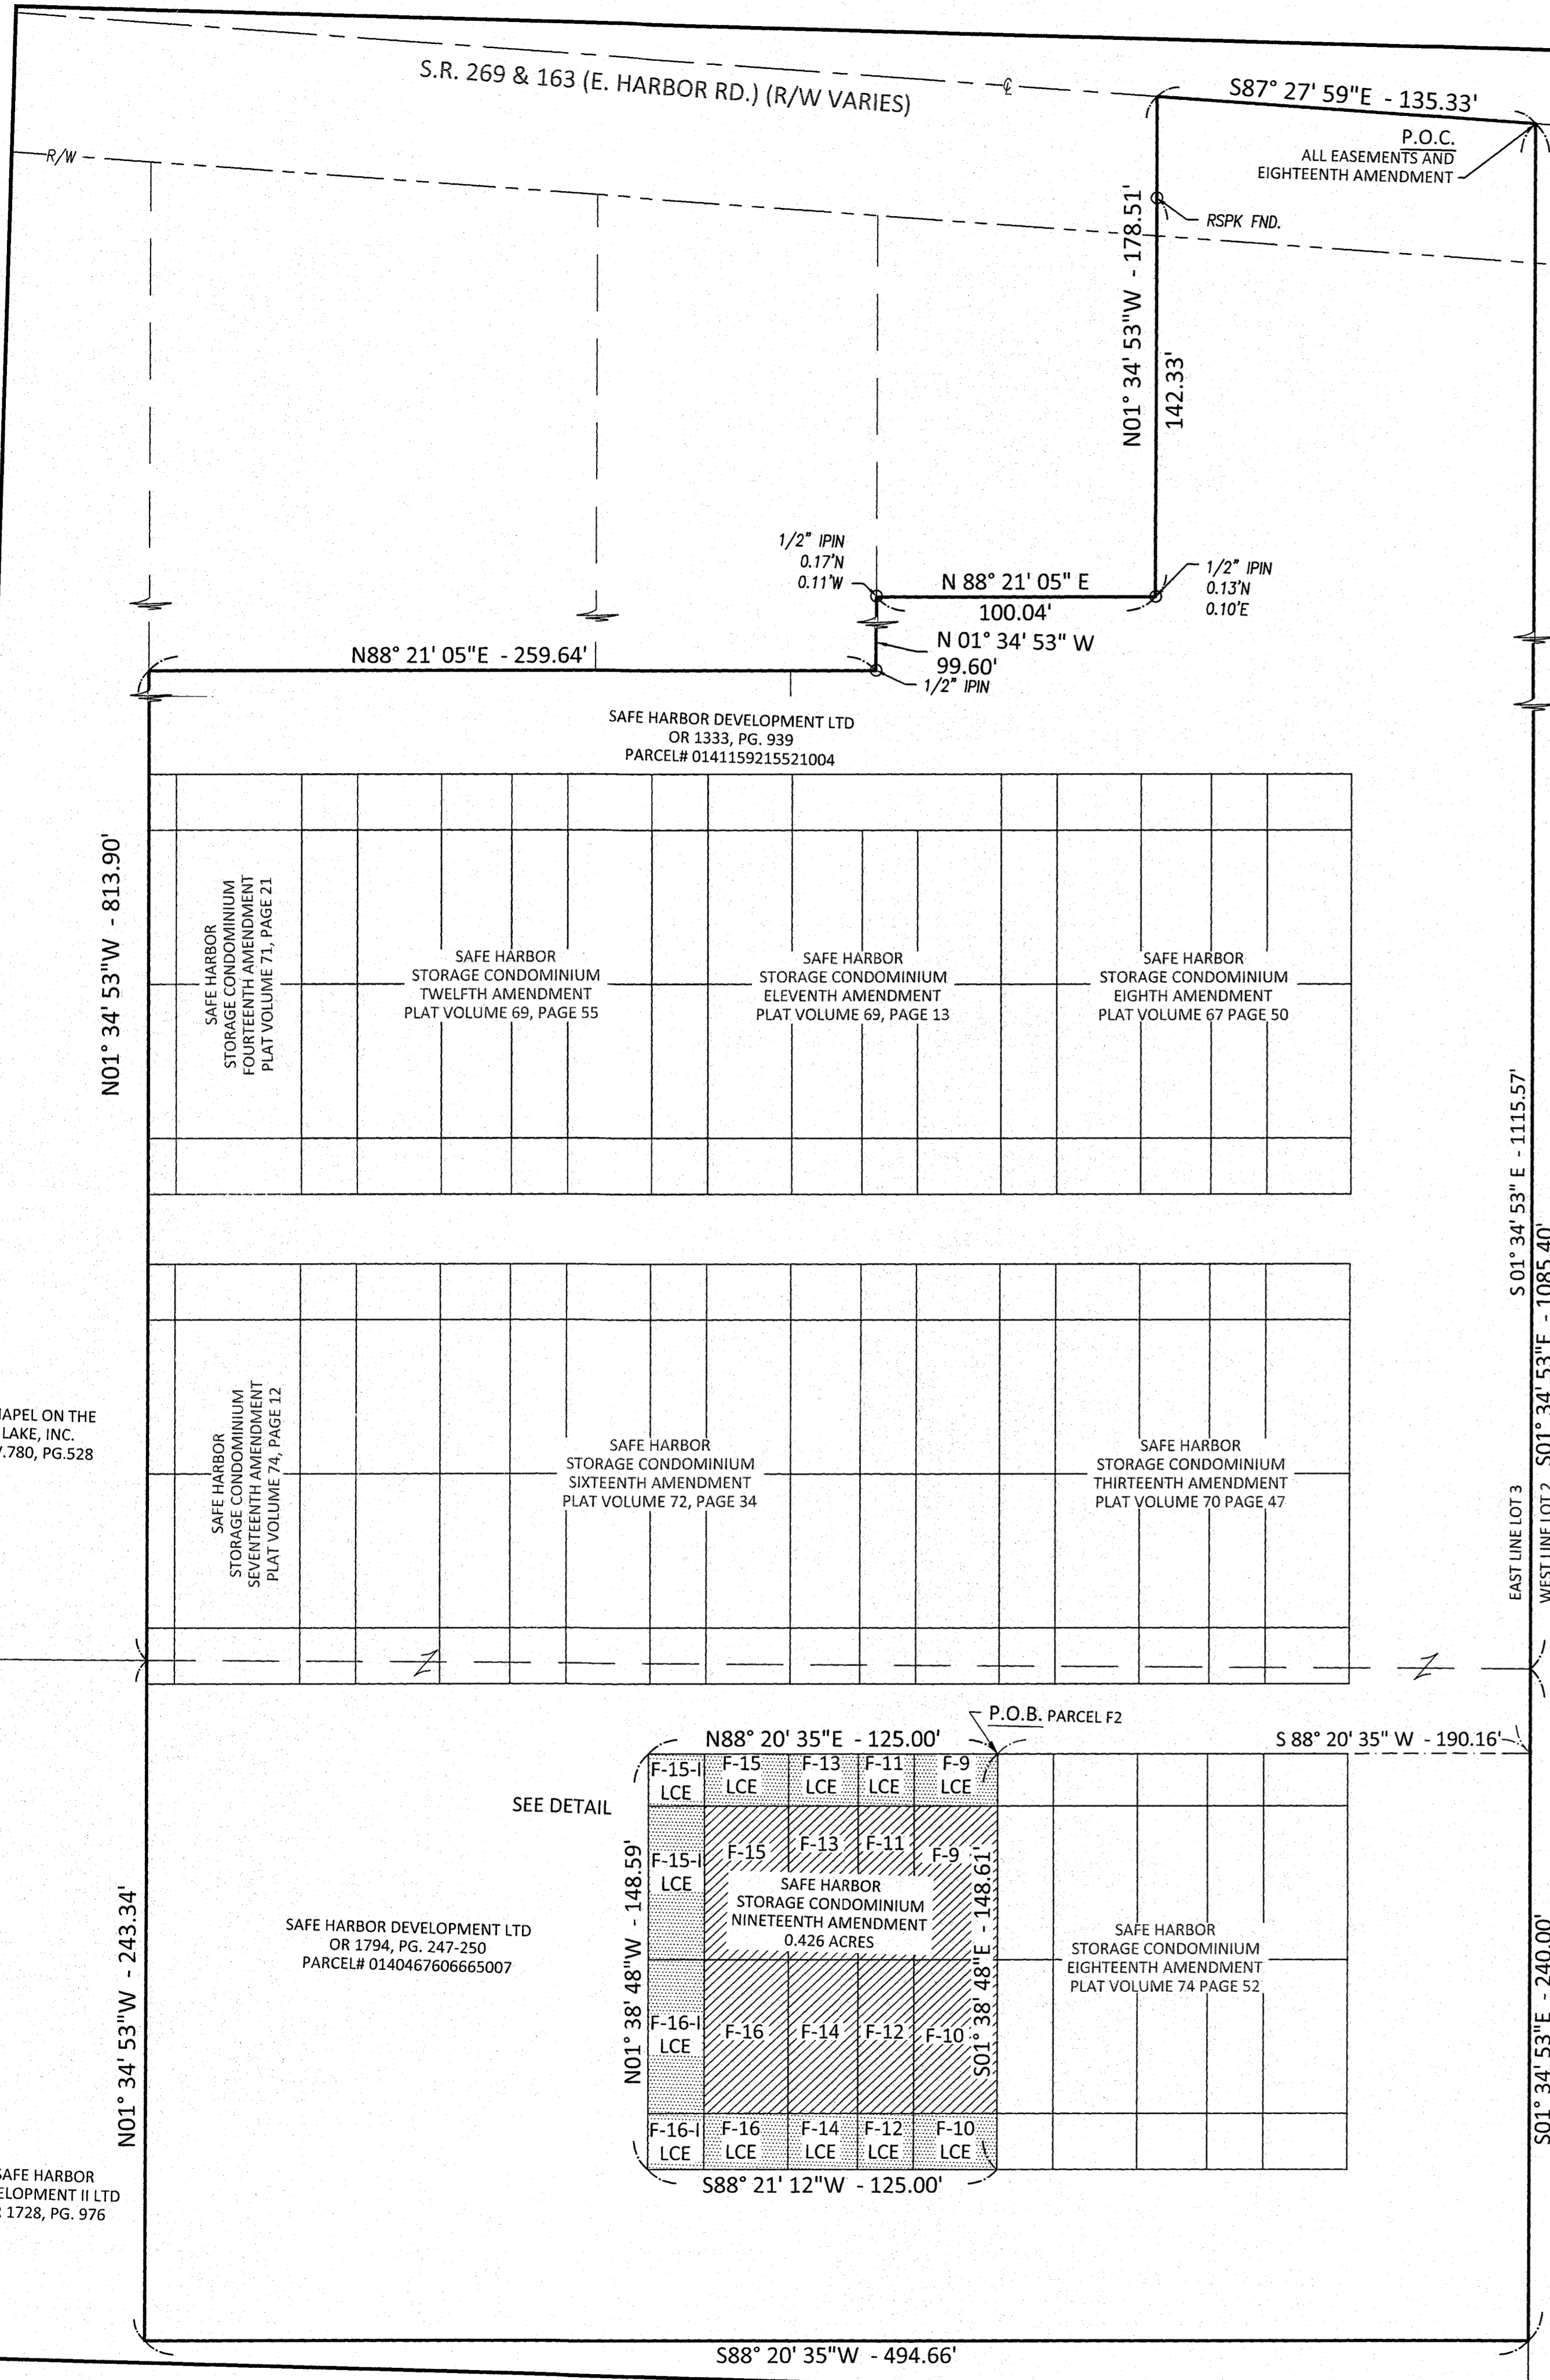


NINETEENTH AMENDMENT

SCALE: 1"=20'

REFERENCES


- DEEDS AS SHOWN.
- SAFE HARBOR STORAGE CONDOMINIUM FIRST AMENDMENT, PLAT VOLUME 62, PAGE 24.
- SAFE HARBOR STORAGE CONDOMINIUM, PLAT VOLUME 60, PAGE 17.
- SAFE HARBOR STORAGE CONDOMINIUM THIRD AMENDMENT, PLAT VOLUME 63, PAGE 48.
- SAFE HARBOR STORAGE CONDOMINIUM FOURTH AMENDMENT, PLAT VOLUME 64, PAGE 29.
- SAFE HARBOR STORAGE CONDOMINIUM FIFTH AMENDMENT, PLAT VOLUME 65, PAGE 2.
- SAFE HARBOR STORAGE CONDOMINIUM SIXTH AMENDMENT, PLAT VOLUME 66, PAGE 17.
- SAFE HARBOR STORAGE CONDOMINIUM SEVENTH AMENDMENT, PLAT VOLUME 67, PAGE 36.
- SAFE HARBOR STORAGE CONDOMINIUM EIGHTH AMENDMENT, PLAT VOLUME 67, PAGE 50.
- SAFE HARBOR STORAGE CONDOMINIUM ELEVENTH AMENDMENT, PLAT VOLUME 69, PAGE 13.
- SAFE HARBOR STORAGE CONDOMINIUM TWELFTH AMENDMENT, PLAT VOLUME 69, PAGE 55.
- SAFE HARBOR STORAGE CONDOMINIUM THIRTEENTH AMENDMENT, PLAT VOLUME 70, PAGE 47.
- SAFE HARBOR STORAGE CONDOMINIUM FOURTEENTH AMENDMENT, PLAT VOLUME 71, PAGE 21.
- SAFE HARBOR STORAGE CONDOMINIUM FIFTEENTH AMENDMENT, DEED BOOK 1833, PAGE 132.
- SAFE HARBOR STORAGE CONDOMINIUM SIXTEENTH AMENDMENT, PLAT VOLUME 72, PAGE 34.
- SAFE HARBOR STORAGE CONDOMINIUM SEVENTEENTH AMENDMENT, PLAT VOLUME 74, PAGE 12.
- SAFE HARBOR STORAGE CONDOMINIUM EIGHTEENTH AMENDMENT, PLAT VOLUME 74, PAGE 52.

SAFE HARBOR STORAGE CONDOMINIUM NINETEENTH AMENDMENT
 LOCATED IN PART OF LOT 03, SECTION 04, DANBURY TOWNSHIP, OTTAWA COUNTY, OHIO.

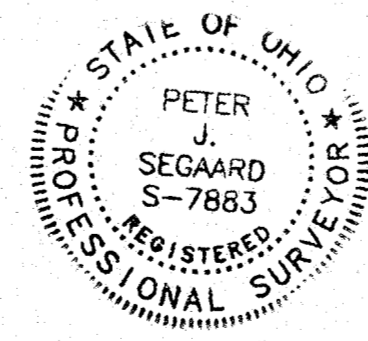

SURVEYOR'S CERTIFICATION:
 I HEREBY DECLARE THAT THE DRAWING ACCURATELY REFLECTS THE LOCATION OF IMPROVEMENTS AND RECORDED EASEMENTS TO THE BEST OF MY KNOWLEDGE AND BELIEF.

Peter J. Segard
 PETER J. SEGARD, P.S.
 OHIO PROFESSIONAL SURVEYOR NO. 7883

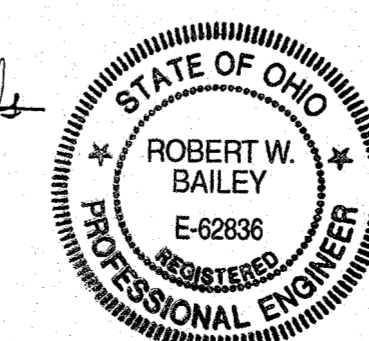


ENGINEER'S CERTIFICATION:
 I HEREBY DECLARE THAT THE DRAWING ACCURATELY SHOWS EACH BUILDING AS BUILT TO THE BEST OF MY KNOWLEDGE AND BELIEF.

Robert W. Bailey
 ROBERT W. BAILEY, P.E.
 OHIO PROFESSIONAL ENGINEER NO. 62836

FILE:	NINETEENTH
JOB NO.:	22060-
DRAWN BY:	GSW
ISSUED:	10/31/2022



1/4

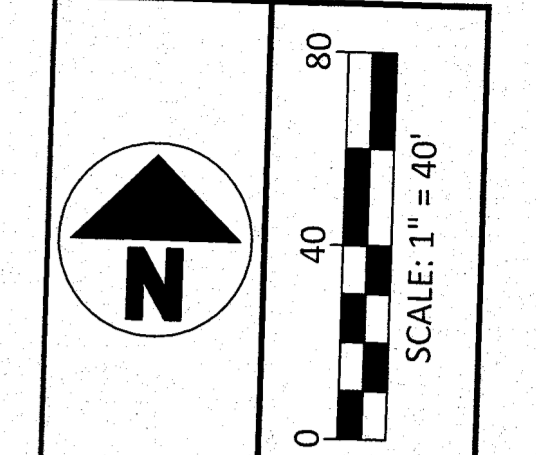

NO	REVISION	DATE
9		
8		
7		
6		
5		
4		
3		
2		
1		


DGL CONSULTING ENGINEERS, LLC
 3455 BRIARFIELD BLVD., SUITE E
 MAUMEE, OH 43537
 PHONE: 419.535.1015
 www.dgl-llc.com

20220823270
 Filed for Record in OTTAWA COUNTY, OHIO
 Nathan J. Daniels
 REC. FEES: \$288.80
 OF VOL 74, PAGE 62 - 65

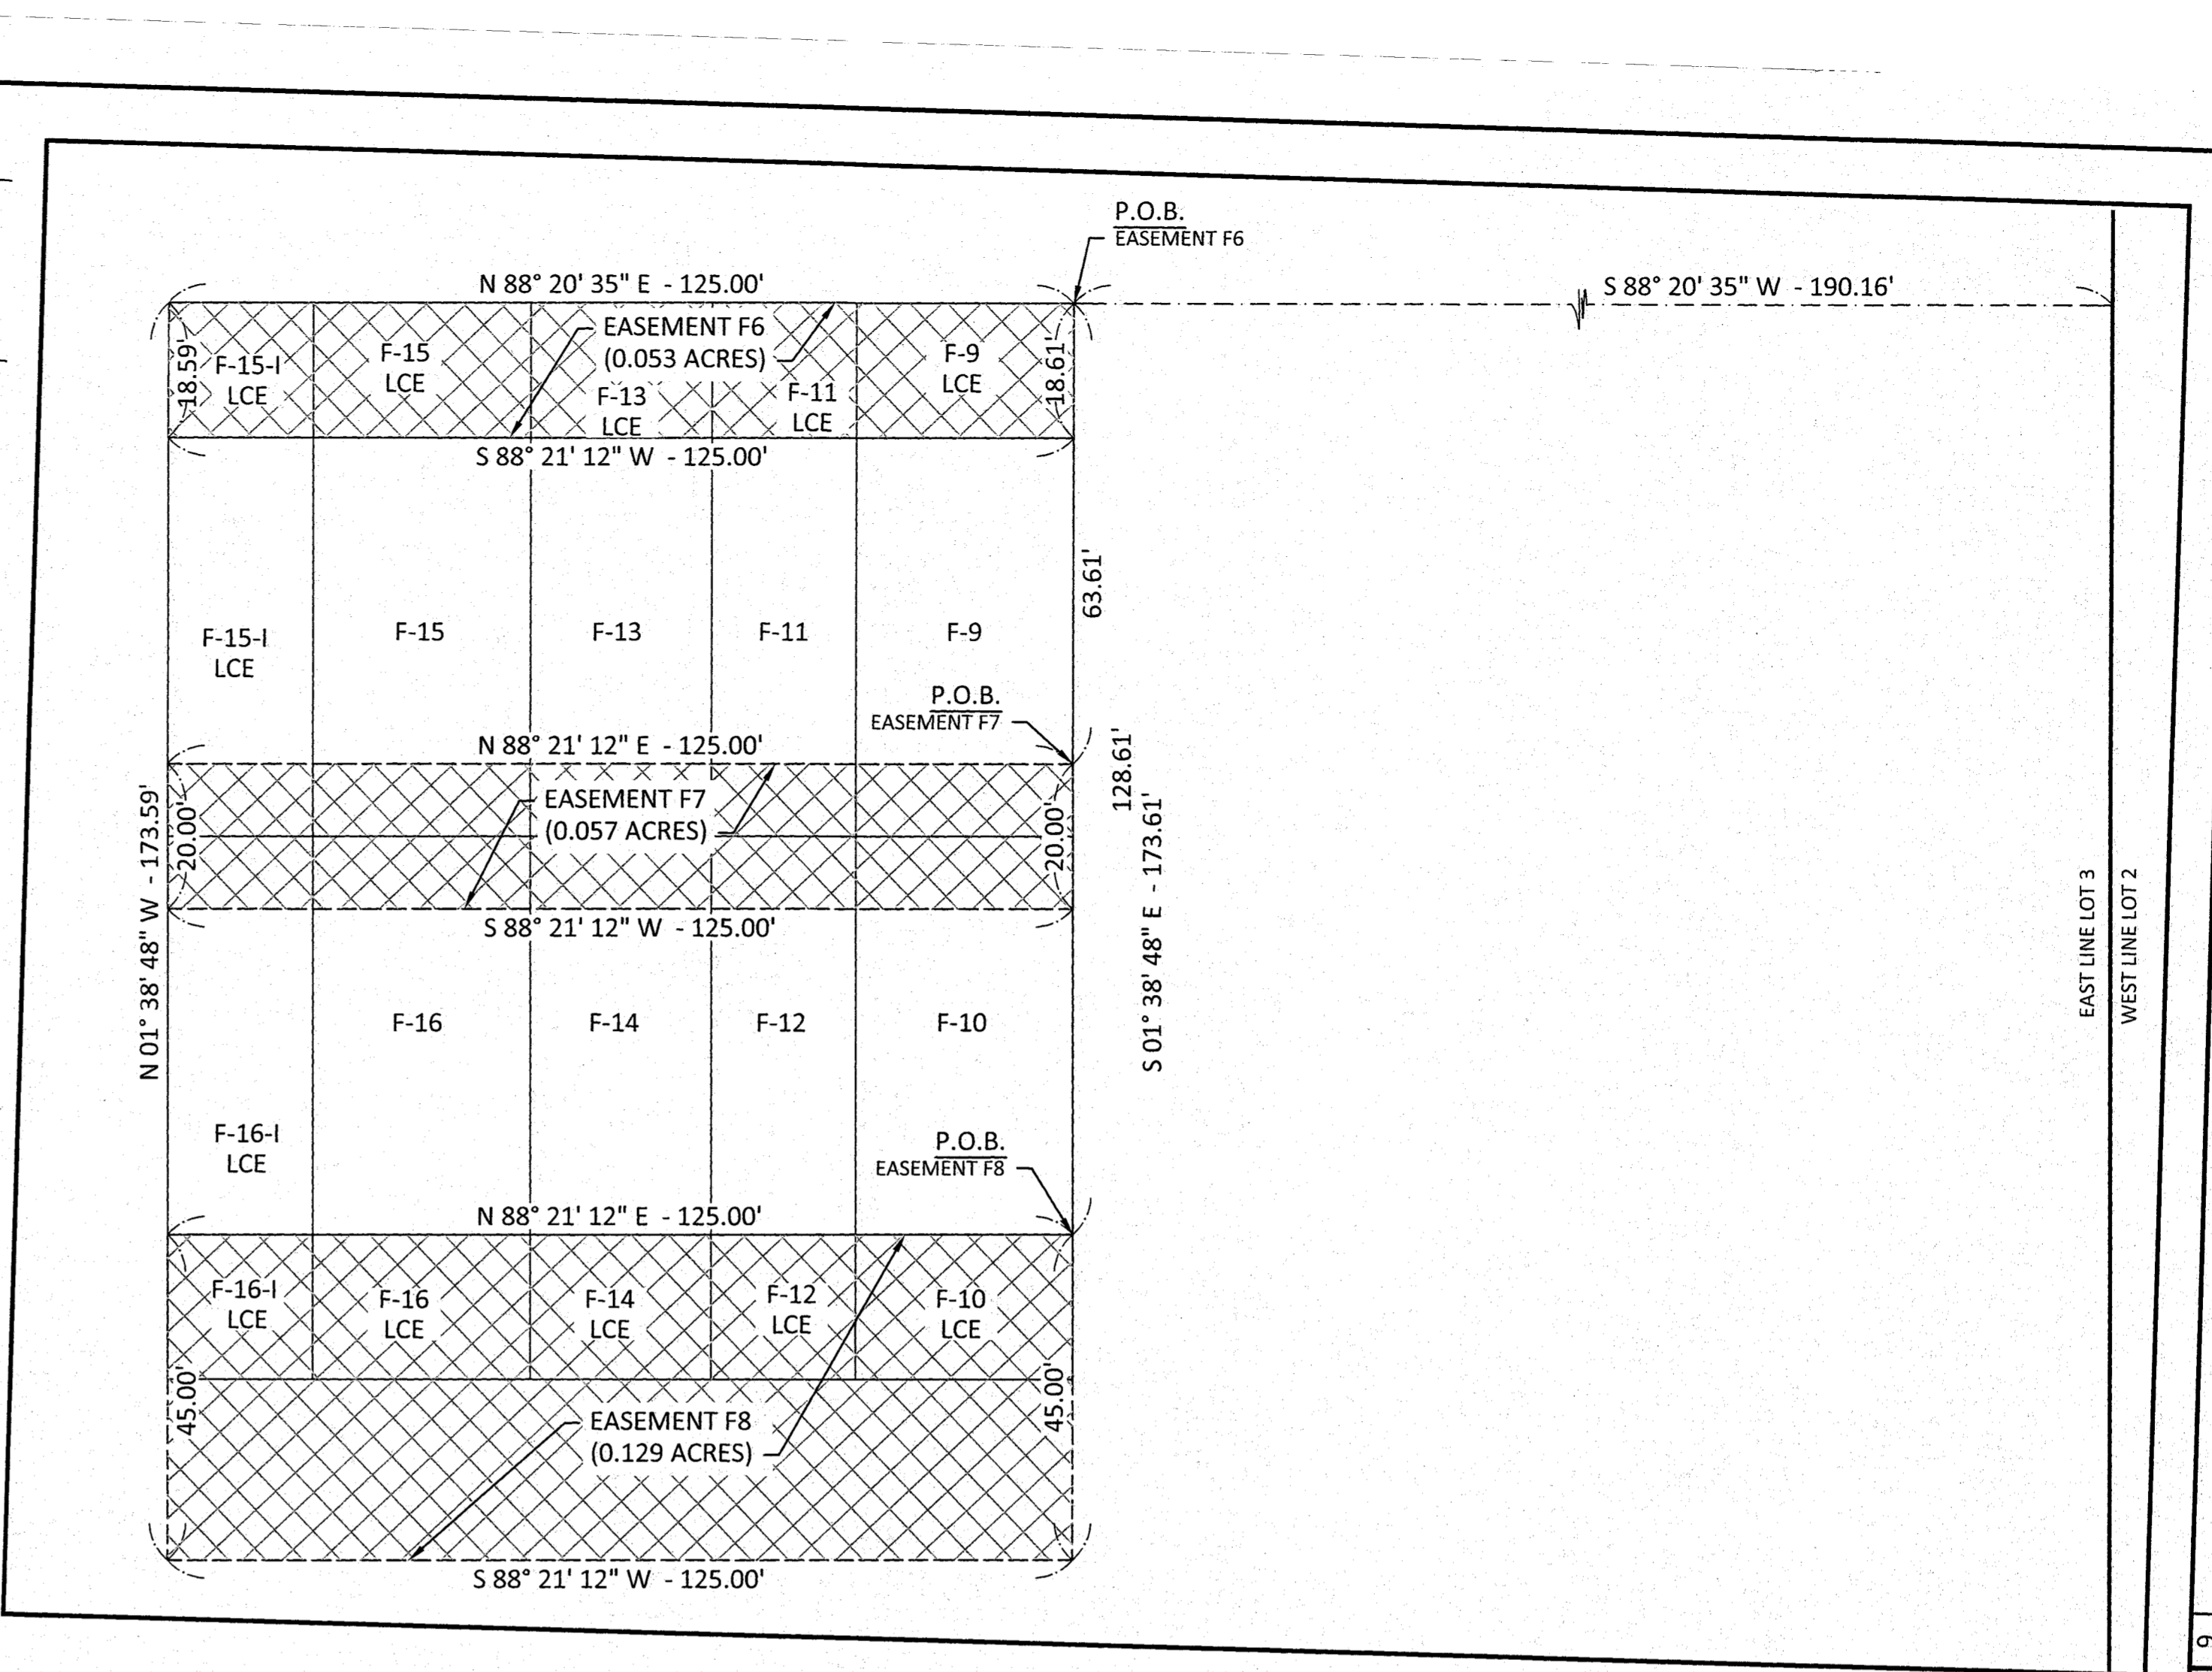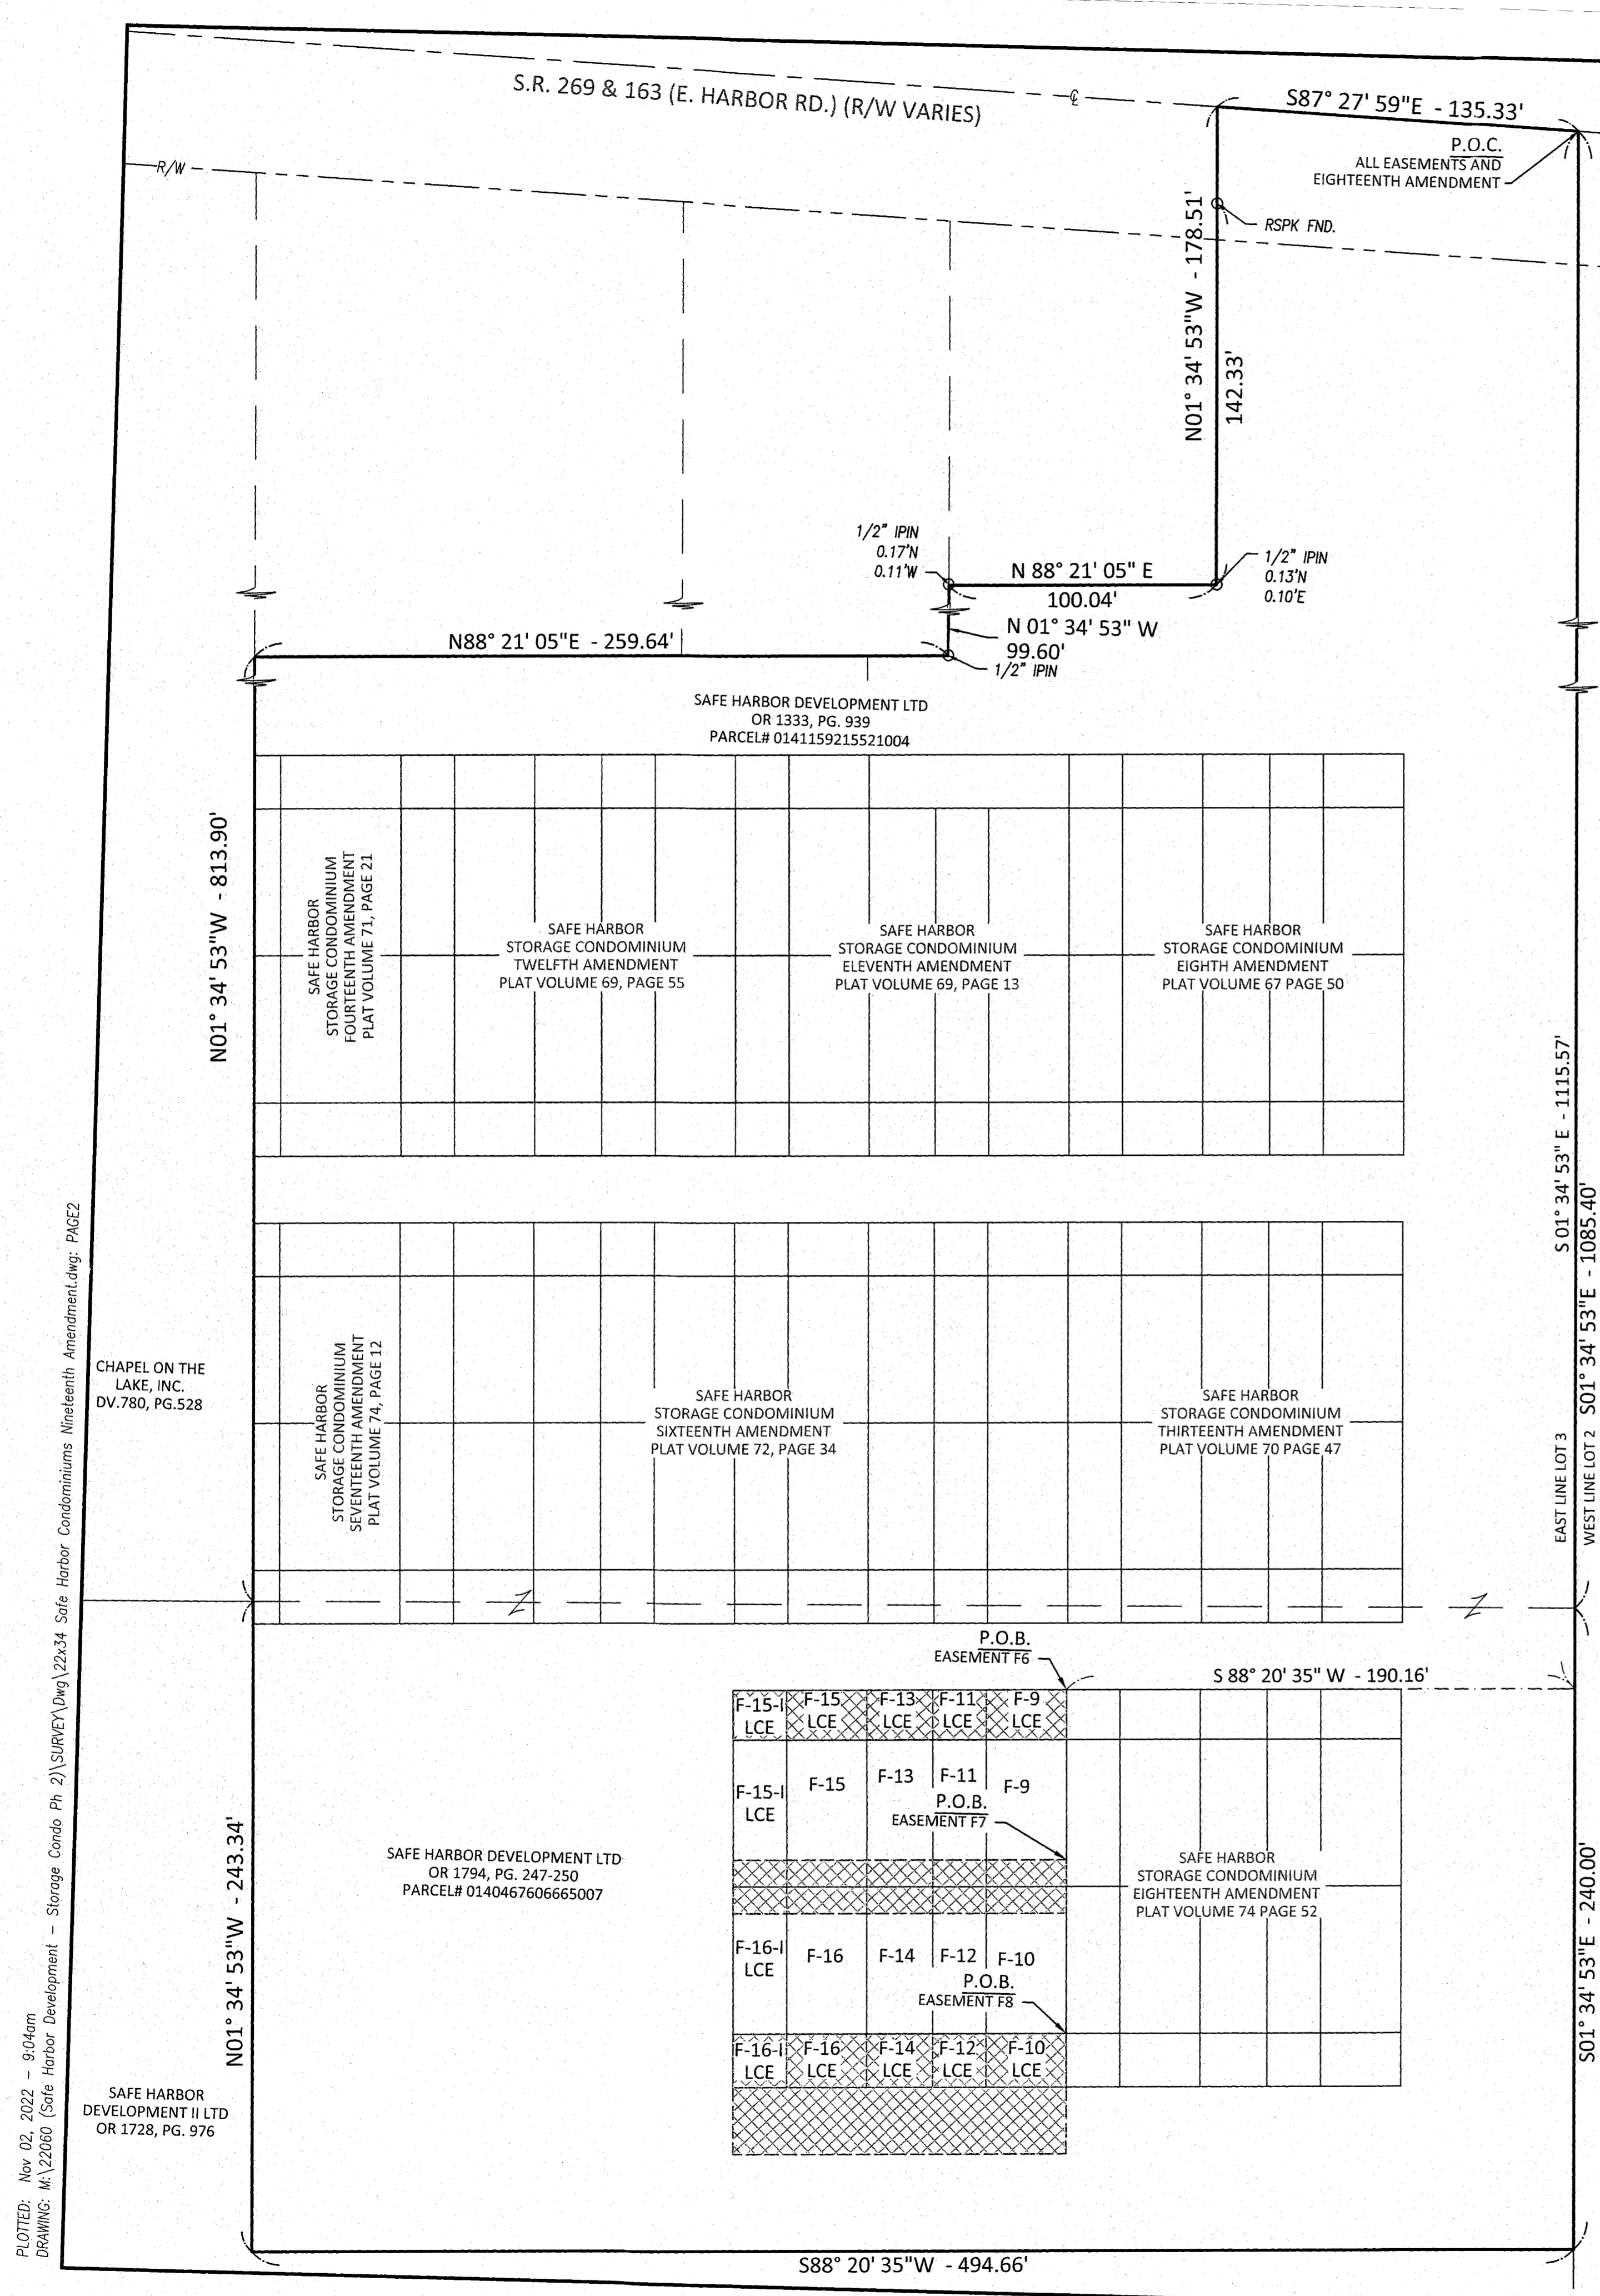

- LEGEND**
- MONUMENT FOUND
 - MONUMENT SET
 - (C) CALCULATED DISTANCE
 - (M) MEASURED DISTANCE
 - (REC) RECORD DISTANCE
 - R/W RIGHT-OF-WAY
 - P.O.B. POINT OF BEGINNING
 - P.O.C. POINT OF COMMENCEMENT
 - UNIT
 - LIMITED COMMON ELEMENT
 - EASEMENT

- REFERENCES**
- DEEDS AS SHOWN.
 - SAFE HARBOR STORAGE CONDOMINIUM FIRST AMENDMENT, PLAT VOLUME 62, PAGE 24.
 - SAFE HARBOR STORAGE CONDOMINIUM, PLAT VOLUME 60, PAGE 17.
 - SAFE HARBOR STORAGE CONDOMINIUM THIRD AMENDMENT, PLAT VOLUME 63, PAGE 48.
 - SAFE HARBOR STORAGE CONDOMINIUM FOURTH AMENDMENT, PLAT VOLUME 64, PAGE 29.
 - SAFE HARBOR STORAGE CONDOMINIUM FIFTH AMENDMENT, PLAT VOLUME 65, PAGE 2.
 - SAFE HARBOR STORAGE CONDOMINIUM SIXTH AMENDMENT, PLAT VOLUME 66, PAGE 17.
 - SAFE HARBOR STORAGE CONDOMINIUM SEVENTH AMENDMENT, PLAT VOLUME 67, PAGE 36.
 - SAFE HARBOR STORAGE CONDOMINIUM EIGHTH AMENDMENT, PLAT VOLUME 67, PAGE 50.
 - SAFE HARBOR STORAGE CONDOMINIUM ELEVENTH AMENDMENT, PLAT VOLUME 69, PAGE 13.
 - SAFE HARBOR STORAGE CONDOMINIUM TWELFTH AMENDMENT, PLAT VOLUME 69, PAGE 55.
 - SAFE HARBOR STORAGE CONDOMINIUM THIRTEENTH AMENDMENT, PLAT VOLUME 70, PAGE 47.
 - SAFE HARBOR STORAGE CONDOMINIUM FOURTEENTH AMENDMENT, PLAT VOLUME 71, PAGE 21.
 - SAFE HARBOR STORAGE CONDOMINIUM FIFTEENTH AMENDMENT, DEED BOOK 1833, PAGE 132.
 - SAFE HARBOR STORAGE CONDOMINIUM SIXTEENTH AMENDMENT, PLAT VOLUME 72, PAGE 34.
 - SAFE HARBOR STORAGE CONDOMINIUM SEVENTEENTH AMENDMENT, PLAT VOLUME 74, PAGE 12.
 - SAFE HARBOR STORAGE CONDOMINIUM EIGHTEENTH AMENDMENT, PLAT VOLUME 74, PAGE 52.

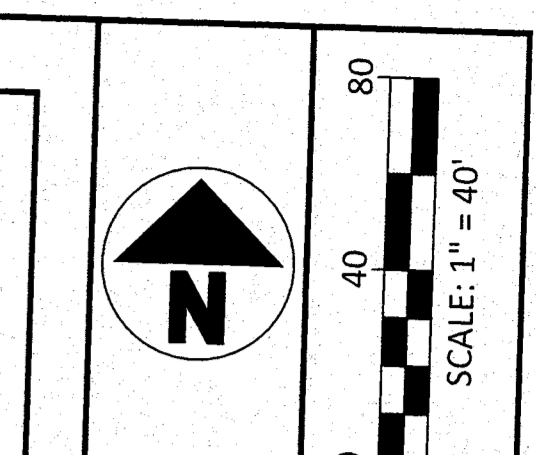

NO	REVISION	DATE
9		
8		
7		
6		
5		
4		
3		
2		
1		

DGL CONSULTING ENGINEERS, LLC
 3455 BRIARFIELD BLVD., SUITE E
 MAUMEE, OH 43537
 PHONE: 419.535.1015
 www.dgl-tcd.com

SAFE HARBOR STORAGE CONDOMINIUM NINETEENTH AMENDMENT

LOCATED IN PART OF LOT 03, SECTION 04, DANBURY TOWNSHIP, OTTAWA COUNTY, OHIO.

FILE:	NINETEENTH
JOB NO.:	22060-
DRAWN BY:	GSW
ISSUED:	10/31/2022