

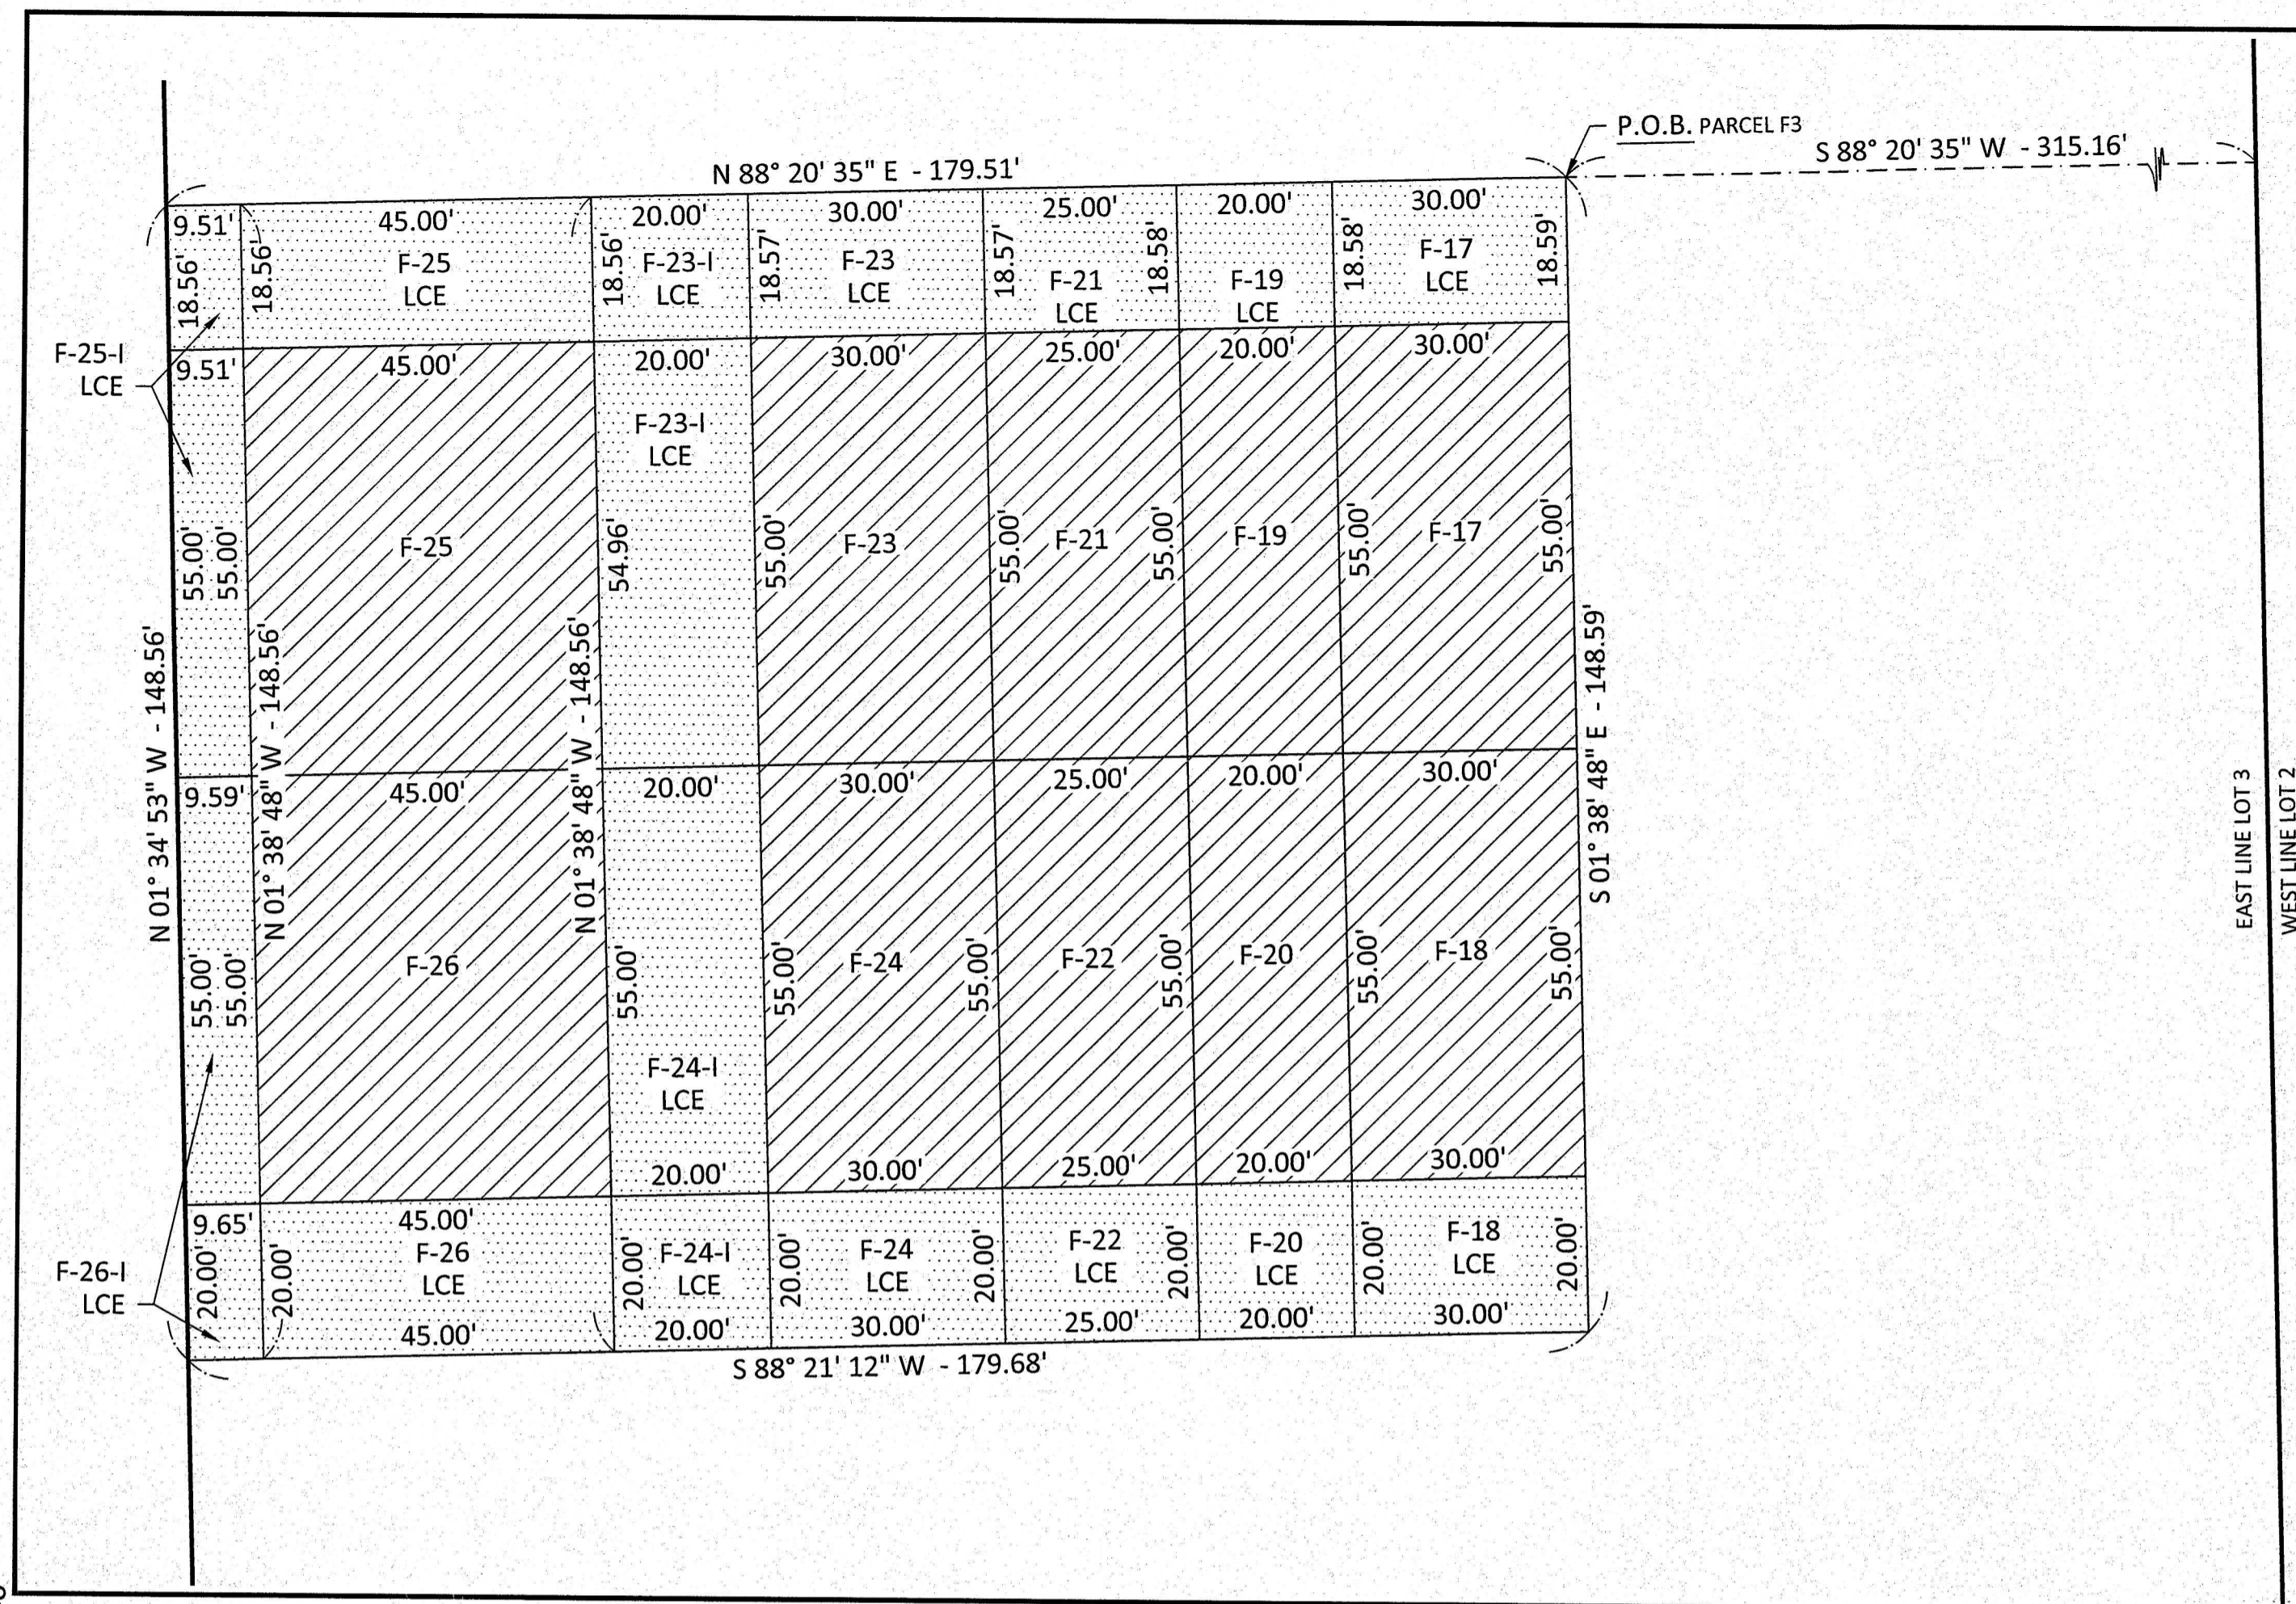



PLOTTED: Nov 11, 2022 - 12:06pm  
 DRAWING: M:\22060 (Safe Harbor Development - Storage Condo Ph 2)\SURVEY\DWG\22x34 Safe Harbor Condominiums Twentieth Amendment.dwg: PAGE1

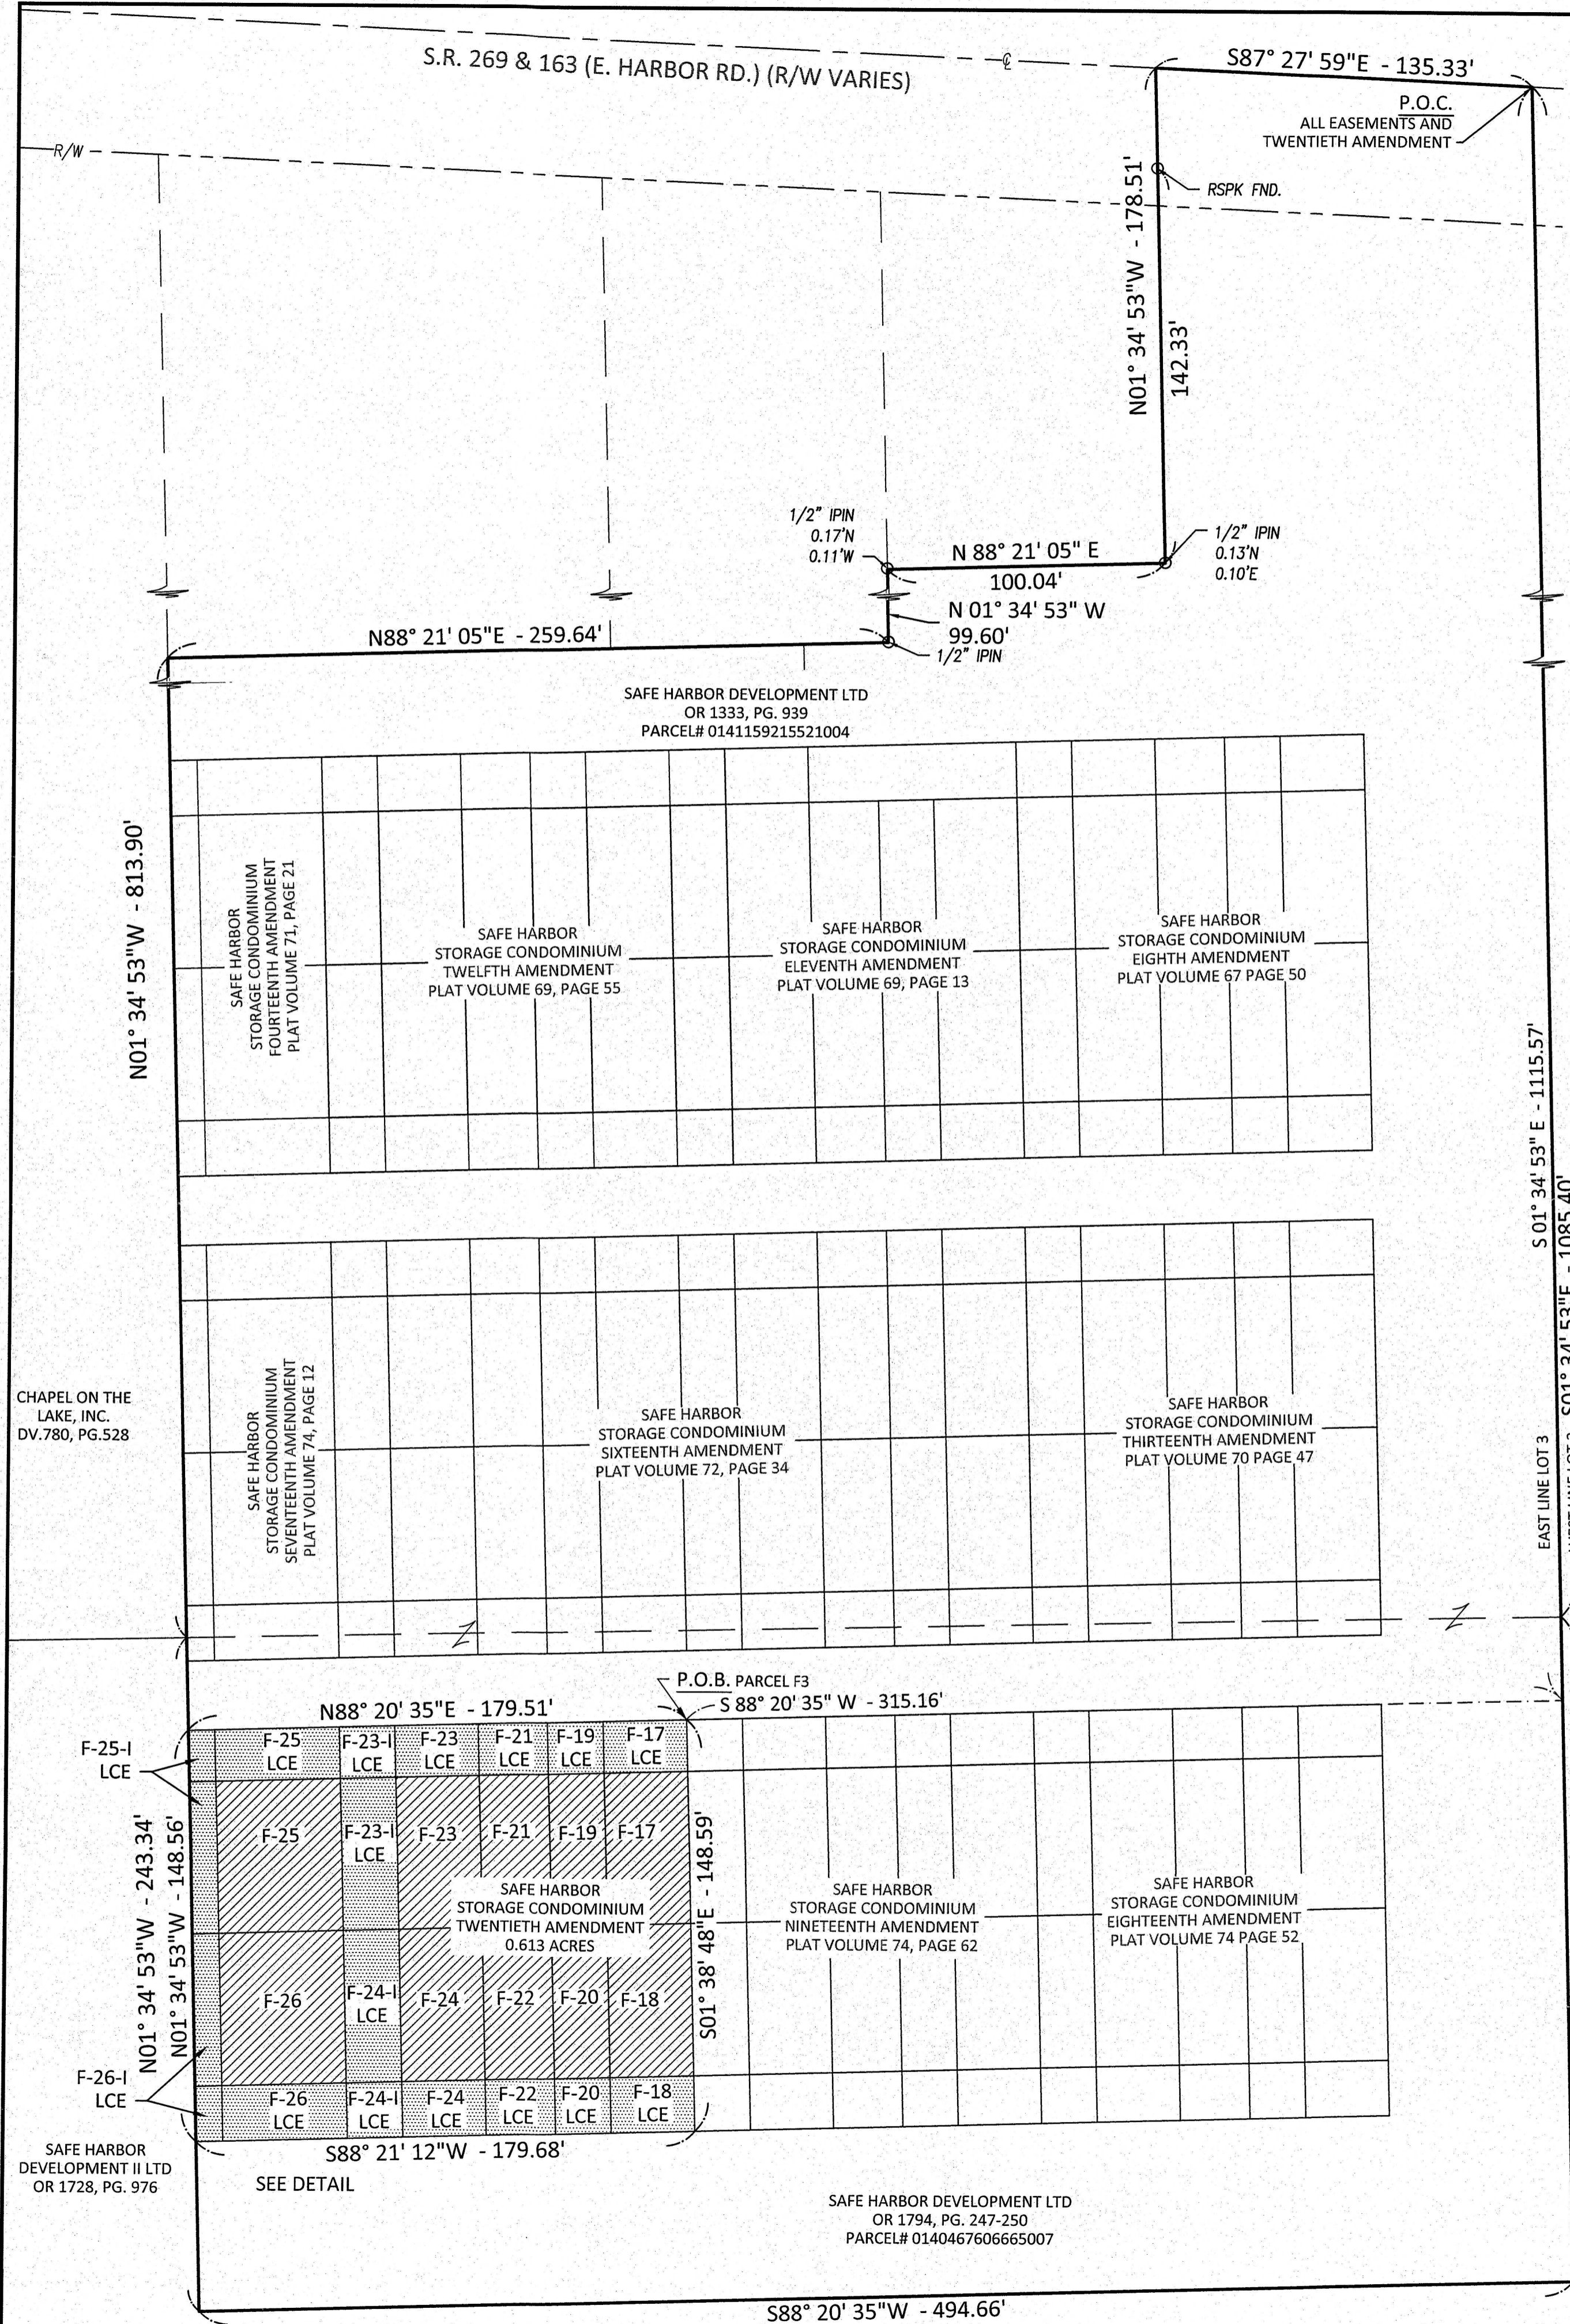

202200322742 12/01/2022 10:46 AM  
 Filed for Record in OTTAWA County, Ohio  
 Nathan J. Daniels Rec Fees: \$403.20  
 OR Vol 74 Pgs 73 - 78

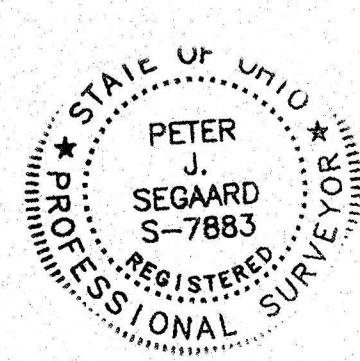


Recorder  
*Nathan J. Daniels* 12/01/22  
 SURVEYOR'S CERTIFICATION:  
 I HEREBY DECLARE THAT THE DRAWING ACCURATELY REFLECTS THE LOCATION OF IMPROVEMENTS AND RECORDED EASEMENTS TO THE BEST OF MY KNOWLEDGE AND BELIEF.  
*Peter J. Segard*  
 PETER J. SEGARD, P.S.  
 OHIO PROFESSIONAL SURVEYOR NO. 7883  
 DATE 11-16-2022

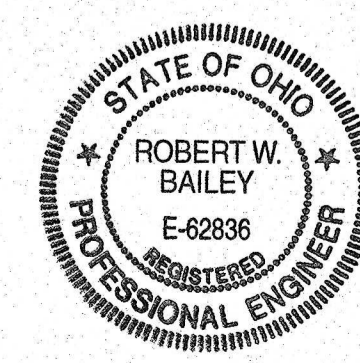

ENGINEER'S CERTIFICATION:  
 I HEREBY DECLARE THAT THE DRAWING ACCURATELY SHOWS EACH BUILDING AS BUILT TO THE BEST OF MY KNOWLEDGE AND BELIEF.  
*Robert W. Bailey*  
 ROBERT W. BAILEY, P.E.  
 OHIO PROFESSIONAL ENGINEER NO. 62836  
 DATE 11-17-22

- REFERENCES**
- DEEDS AS SHOWN.
  - SAFE HARBOR STORAGE CONDOMINIUM FIRST AMENDMENT, PLAT VOLUME 62, PAGE 24.
  - SAFE HARBOR STORAGE CONDOMINIUM, PLAT VOLUME 60, PAGE 17.
  - SAFE HARBOR STORAGE CONDOMINIUM THIRD AMENDMENT, PLAT VOLUME 63, PAGE 48.
  - SAFE HARBOR STORAGE CONDOMINIUM FOURTH AMENDMENT, PLAT VOLUME 64, PAGE 29.
  - SAFE HARBOR STORAGE CONDOMINIUM FIFTH AMENDMENT, PLAT VOLUME 65, PAGE 2.
  - SAFE HARBOR STORAGE CONDOMINIUM SIXTH AMENDMENT, PLAT VOLUME 66, PAGE 17.
  - SAFE HARBOR STORAGE CONDOMINIUM SEVENTH AMENDMENT, PLAT VOLUME 67, PAGE 36.
  - SAFE HARBOR STORAGE CONDOMINIUM EIGHTH AMENDMENT, PLAT VOLUME 67, PAGE 50.
  - SAFE HARBOR STORAGE CONDOMINIUM ELEVENTH AMENDMENT, PLAT VOLUME 69, PAGE 13.
  - SAFE HARBOR STORAGE CONDOMINIUM TWELFTH AMENDMENT, PLAT VOLUME 69, PAGE 55.
  - SAFE HARBOR STORAGE CONDOMINIUM THIRTEENTH AMENDMENT, PLAT VOLUME 70, PAGE 47.
  - SAFE HARBOR STORAGE CONDOMINIUM FOURTEENTH AMENDMENT, PLAT VOLUME 71, PAGE 21.
  - SAFE HARBOR STORAGE CONDOMINIUM FIFTEENTH AMENDMENT, DEED BOOK 1833, PAGE 132.
  - SAFE HARBOR STORAGE CONDOMINIUM SIXTEENTH AMENDMENT, PLAT VOLUME 72, PAGE 34.
  - SAFE HARBOR STORAGE CONDOMINIUM SEVENTEENTH AMENDMENT, PLAT VOLUME 74, PAGE 12.
  - SAFE HARBOR STORAGE CONDOMINIUM EIGHTEENTH AMENDMENT, PLAT VOLUME 74, PAGE 52.
  - SAFE HARBOR STORAGE CONDOMINIUM NINETEENTH AMENDMENT, PLAT VOLUME 74, PAGE 62.

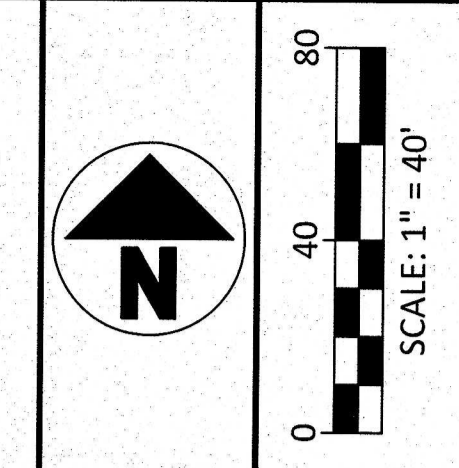

**LEGEND**

- MONUMENT FOUND
- MONUMENT SET
- (C) CALCULATED DISTANCE
- (M) MEASURED DISTANCE
- (RE) RECORD DISTANCE
- R/W RIGHT-OF-WAY
- P.O.B. POINT OF BEGINNING
- P.O.C. POINT OF COMMENCEMENT
- UNITS
- LIMITED COMMON ELEMENT
- FENCE

NO	REVISION	DATE
9		
8		
7		
6		
5		
4		
3		
2		
1		
NO		





**SAFE HARBOR STORAGE CONDOMINIUM TWENTIETH AMENDMENT**  
 LOCATED IN PART OF LOT 03, SECTION 04, DANBURY TOWNSHIP, OTTAWA COUNTY, OHIO.

FILE:	TWENTIETH
JOB NO.:	22060-
DRAWN BY:	GSW/PJS
ISSUED:	11/11/2022


1/6

PLOTTED: Nov 11, 2022 - 12:05pm  
 DRAWING: M:\22060 (Safe Harbor Development - Storage Condo Ph 2)\SURVEY\DWG\22x34 Safe Harbor Condominiums Twentieth Amendment.dwg - PAGE2

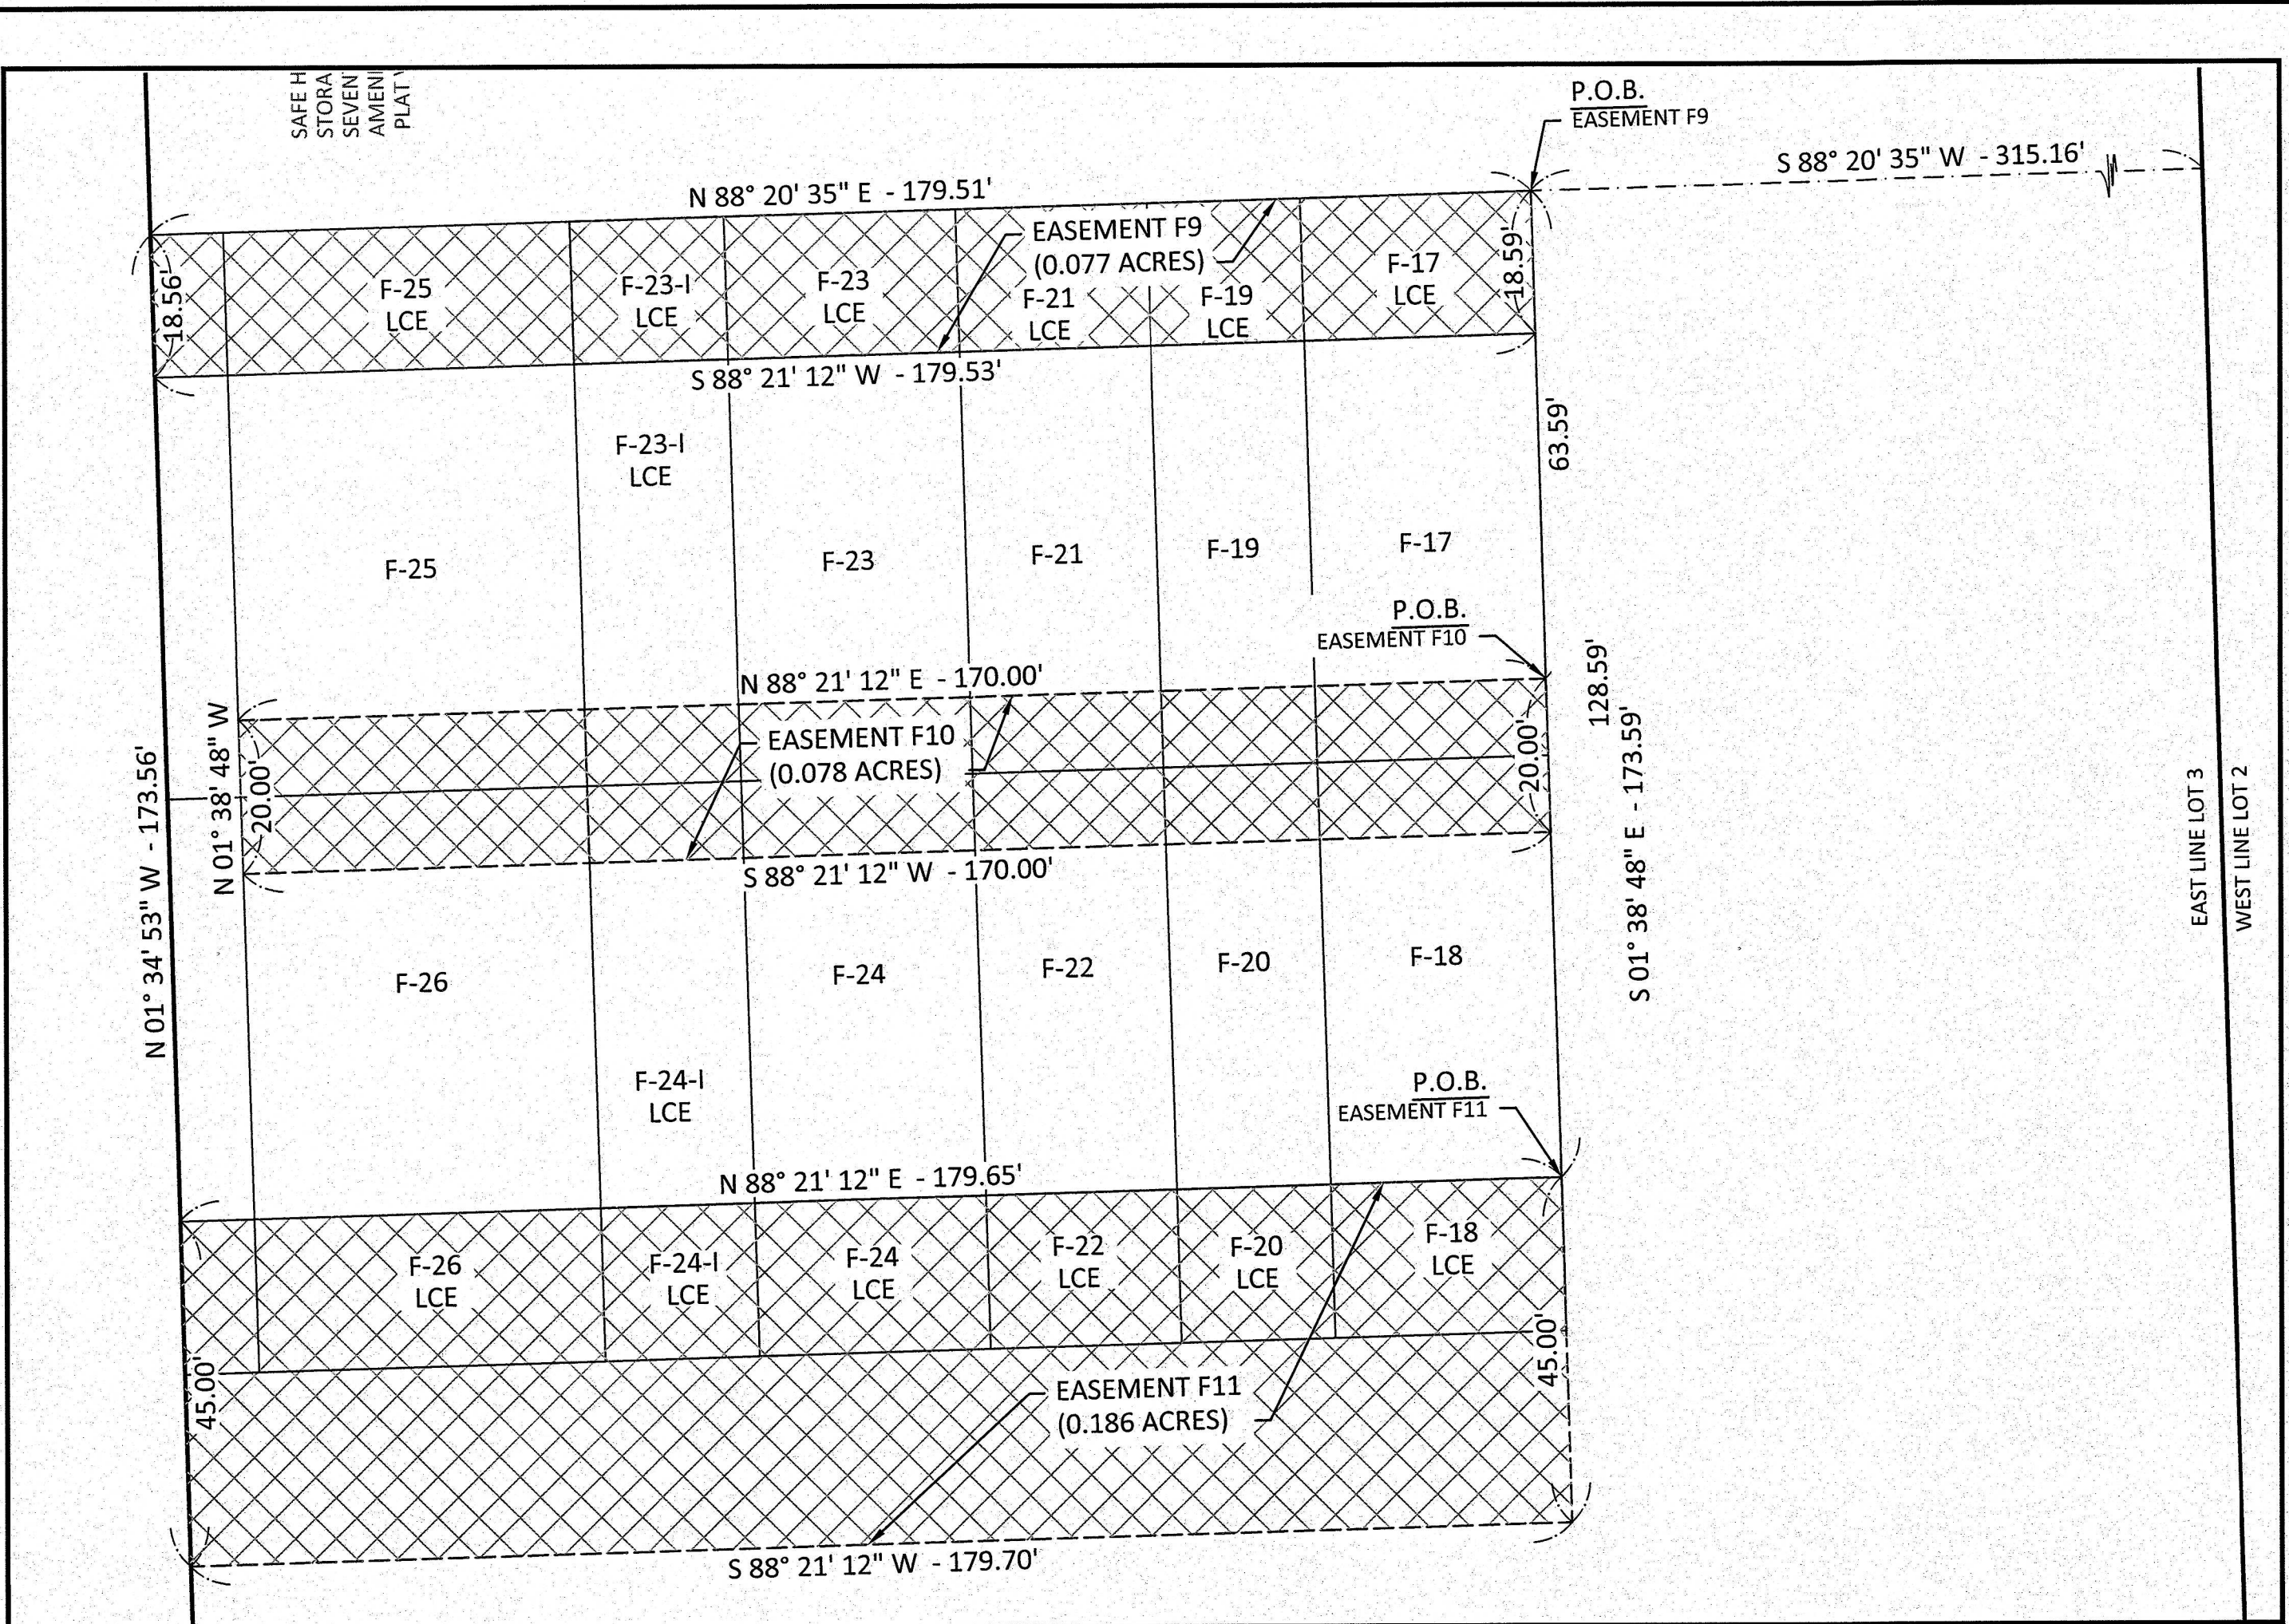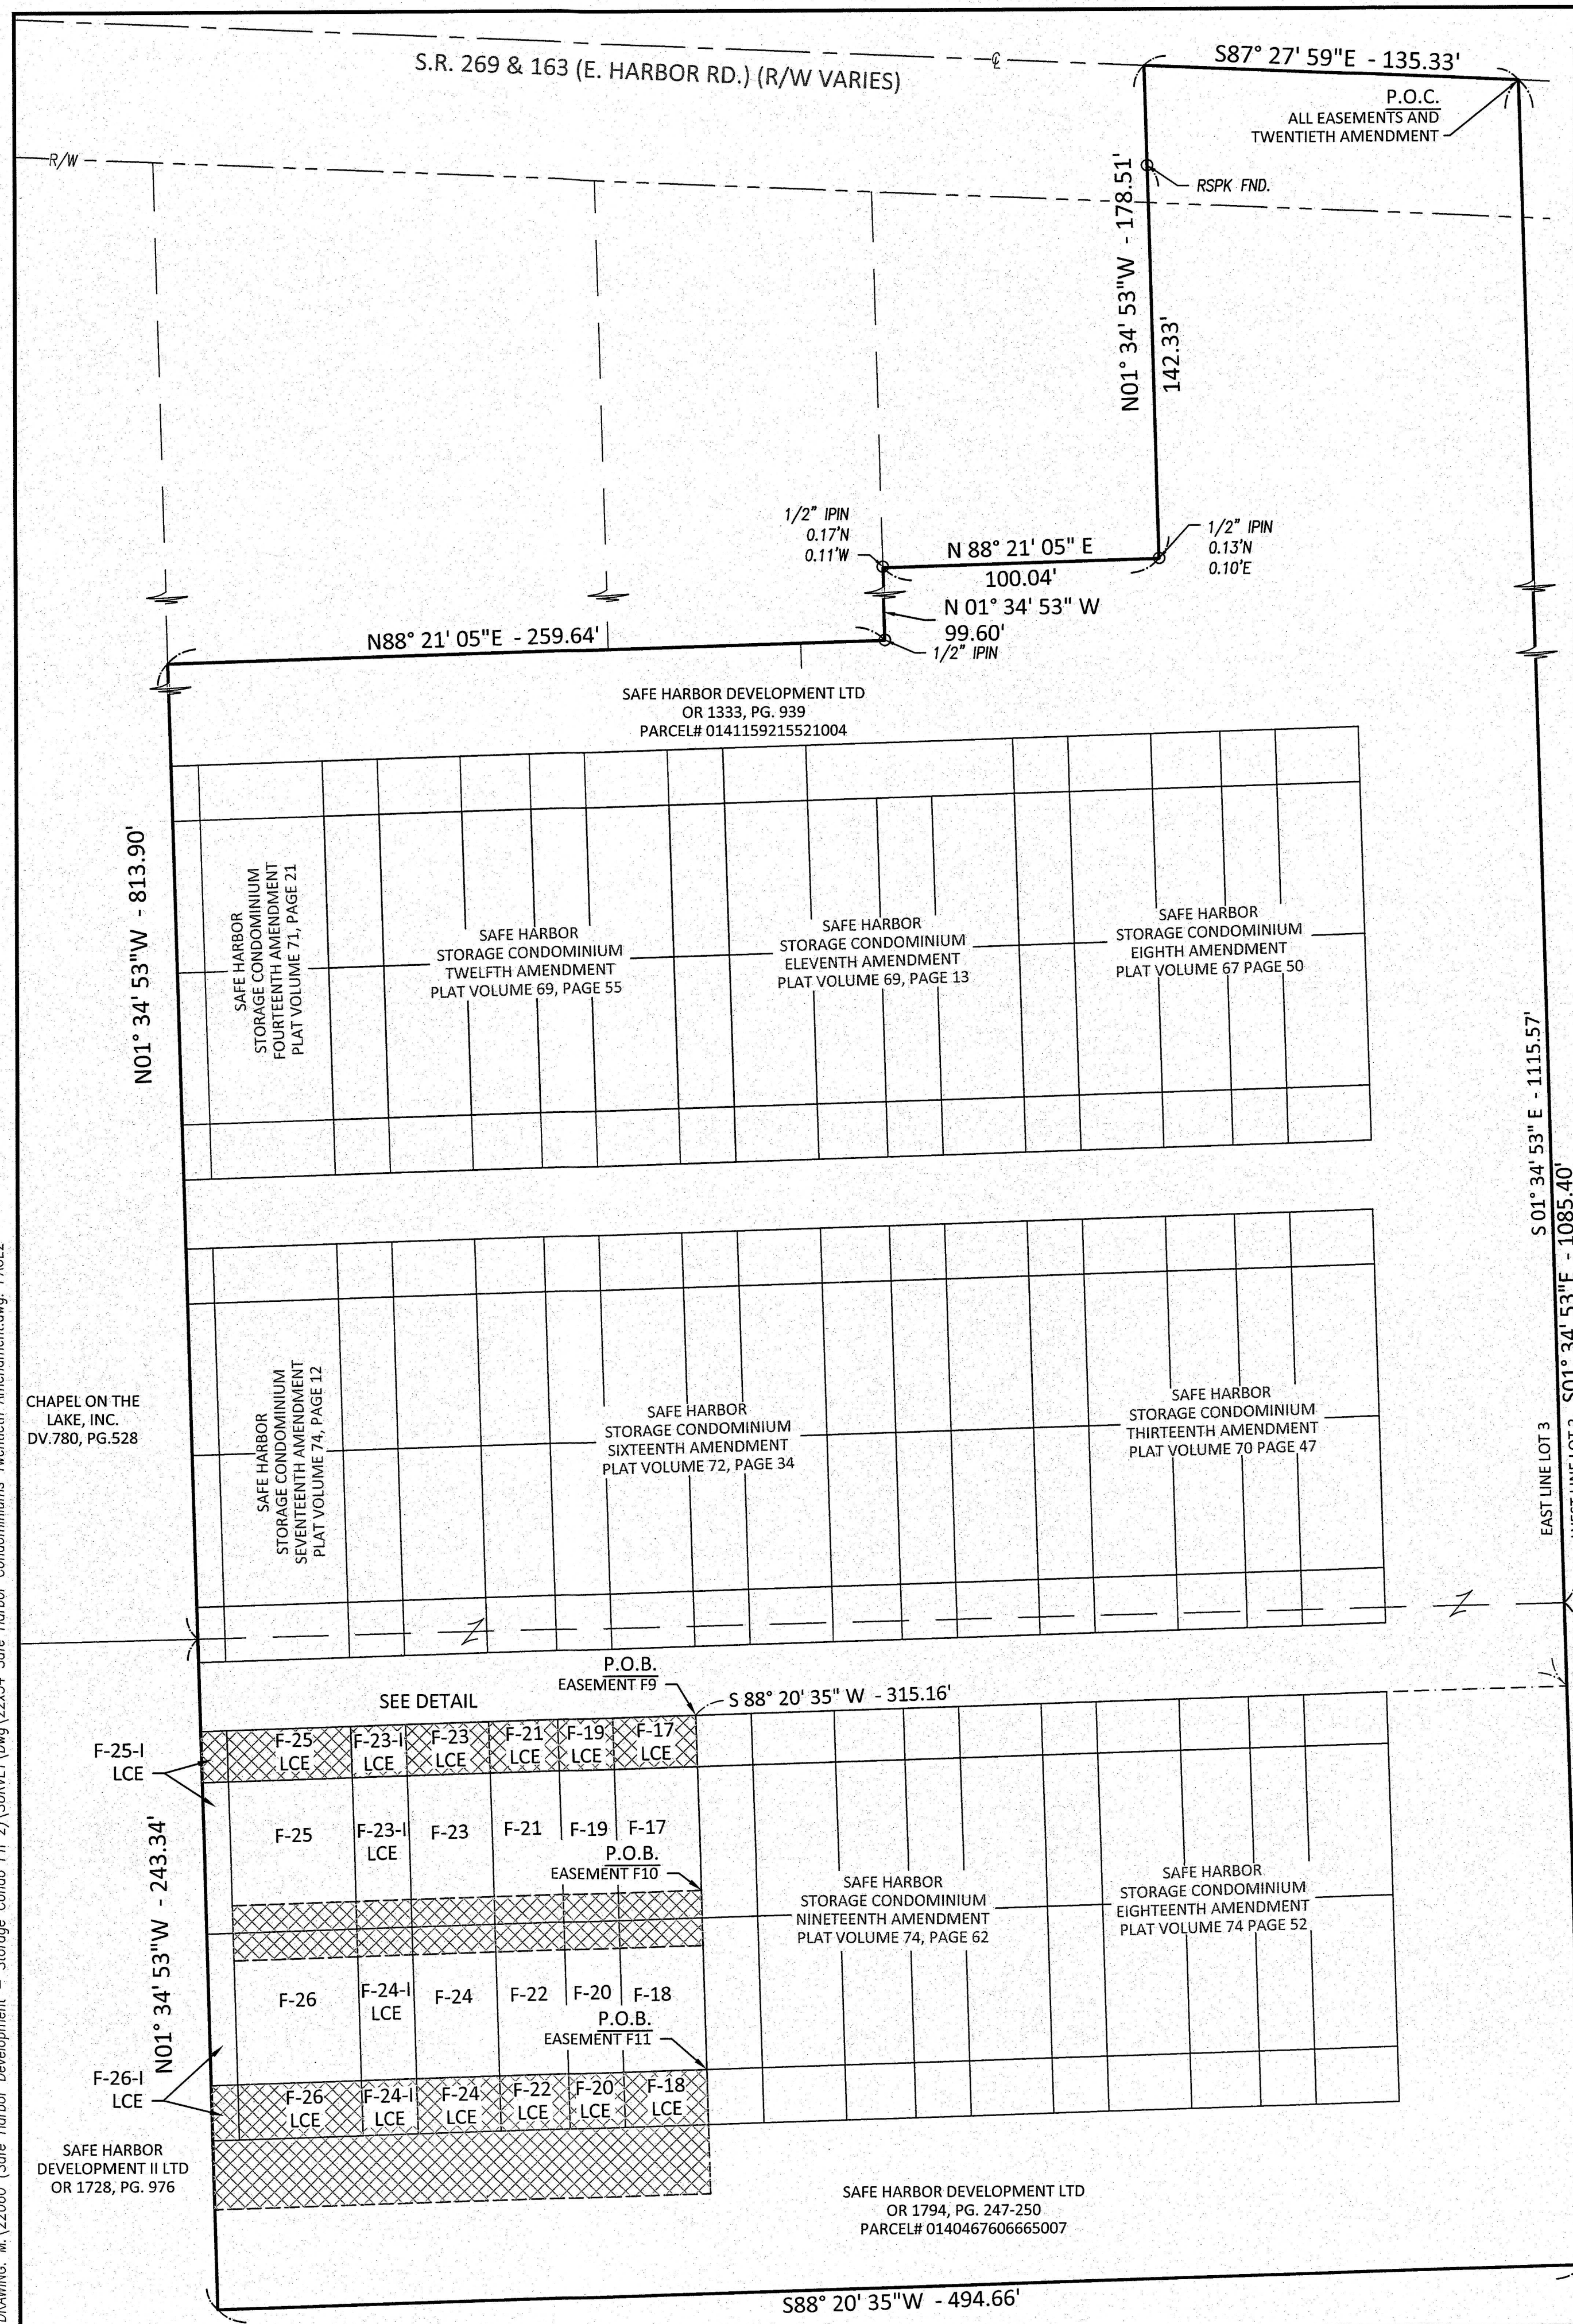

- LEGEND**
- MONUMENT FOUND
  - MONUMENT SET
  - (C) CALCULATED DISTANCE
  - (M) MEASURED DISTANCE
  - (REC) RECORD DISTANCE
  - R/W RIGHT-OF-WAY
  - P.O.B. POINT OF BEGINNING
  - P.O.C. POINT OF COMMENCEMENT
  - UNIT
  - LIMITED COMMON ELEMENT
  - EASEMENT

- REFERENCES**
- DEEDS AS SHOWN.
  - SAFE HARBOR STORAGE CONDOMINIUM FIRST AMENDMENT, PLAT VOLUME 62, PAGE 24.
  - SAFE HARBOR STORAGE CONDOMINIUM, PLAT VOLUME 60, PAGE 17.
  - SAFE HARBOR STORAGE CONDOMINIUM THIRD AMENDMENT, PLAT VOLUME 63, PAGE 48.
  - SAFE HARBOR STORAGE CONDOMINIUM FOURTH AMENDMENT, PLAT VOLUME 64, PAGE 29.
  - SAFE HARBOR STORAGE CONDOMINIUM FIFTH AMENDMENT, PLAT VOLUME 65, PAGE 2.
  - SAFE HARBOR STORAGE CONDOMINIUM SIXTH AMENDMENT, PLAT VOLUME 66, PAGE 17.
  - SAFE HARBOR STORAGE CONDOMINIUM SEVENTH AMENDMENT, PLAT VOLUME 67, PAGE 36.
  - SAFE HARBOR STORAGE CONDOMINIUM EIGHTH AMENDMENT, PLAT VOLUME 67, PAGE 50.
  - SAFE HARBOR STORAGE CONDOMINIUM ELEVENTH AMENDMENT, PLAT VOLUME 69, PAGE 13.
  - SAFE HARBOR STORAGE CONDOMINIUM TWELFTH AMENDMENT, PLAT VOLUME 69, PAGE 55.
  - SAFE HARBOR STORAGE CONDOMINIUM THIRTEENTH AMENDMENT, PLAT VOLUME 70, PAGE 47.
  - SAFE HARBOR STORAGE CONDOMINIUM FOURTEENTH AMENDMENT, PLAT VOLUME 71, PAGE 21.
  - SAFE HARBOR STORAGE CONDOMINIUM FIFTEENTH AMENDMENT, DEED BOOK 1833, PAGE 132.
  - SAFE HARBOR STORAGE CONDOMINIUM SIXTEENTH AMENDMENT, PLAT VOLUME 72, PAGE 34.
  - SAFE HARBOR STORAGE CONDOMINIUM SEVENTEENTH AMENDMENT, PLAT VOLUME 74, PAGE 12.
  - SAFE HARBOR STORAGE CONDOMINIUM EIGHTEENTH AMENDMENT, PLAT VOLUME 74, PAGE 52.
  - SAFE HARBOR STORAGE CONDOMINIUM NINETEENTH AMENDMENT, PLAT VOLUME 74, PAGE 62.

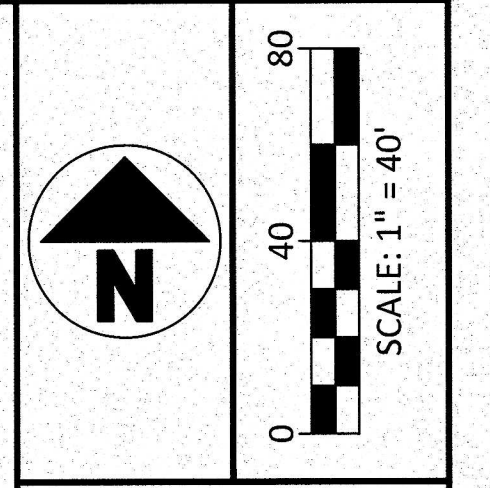

NO	REVISION	DATE
9		
8		
7		
6		
5		
4		
3		
2		
1		
NO		

DGL CONSULTING ENGINEERS, LLC  
 3455 BRIARFIELD BLVD., SUITE E  
 MAUMEE, OH 43537  
 PHONE: 419.535.1015  
 www.dgl-td.com

**SAFE HARBOR STORAGE CONDOMINIUM TWENTIETH AMENDMENT**

LOCATED IN PART OF LOT 03, SECTION 04, DANBURY TOWNSHIP, OTTAWA COUNTY, OHIO.

FILE: TWENTIETH  
 JOB NO.: 22060-  
 DRAWN BY: GSW/PIS  
 ISSUED: 11/11/2022