
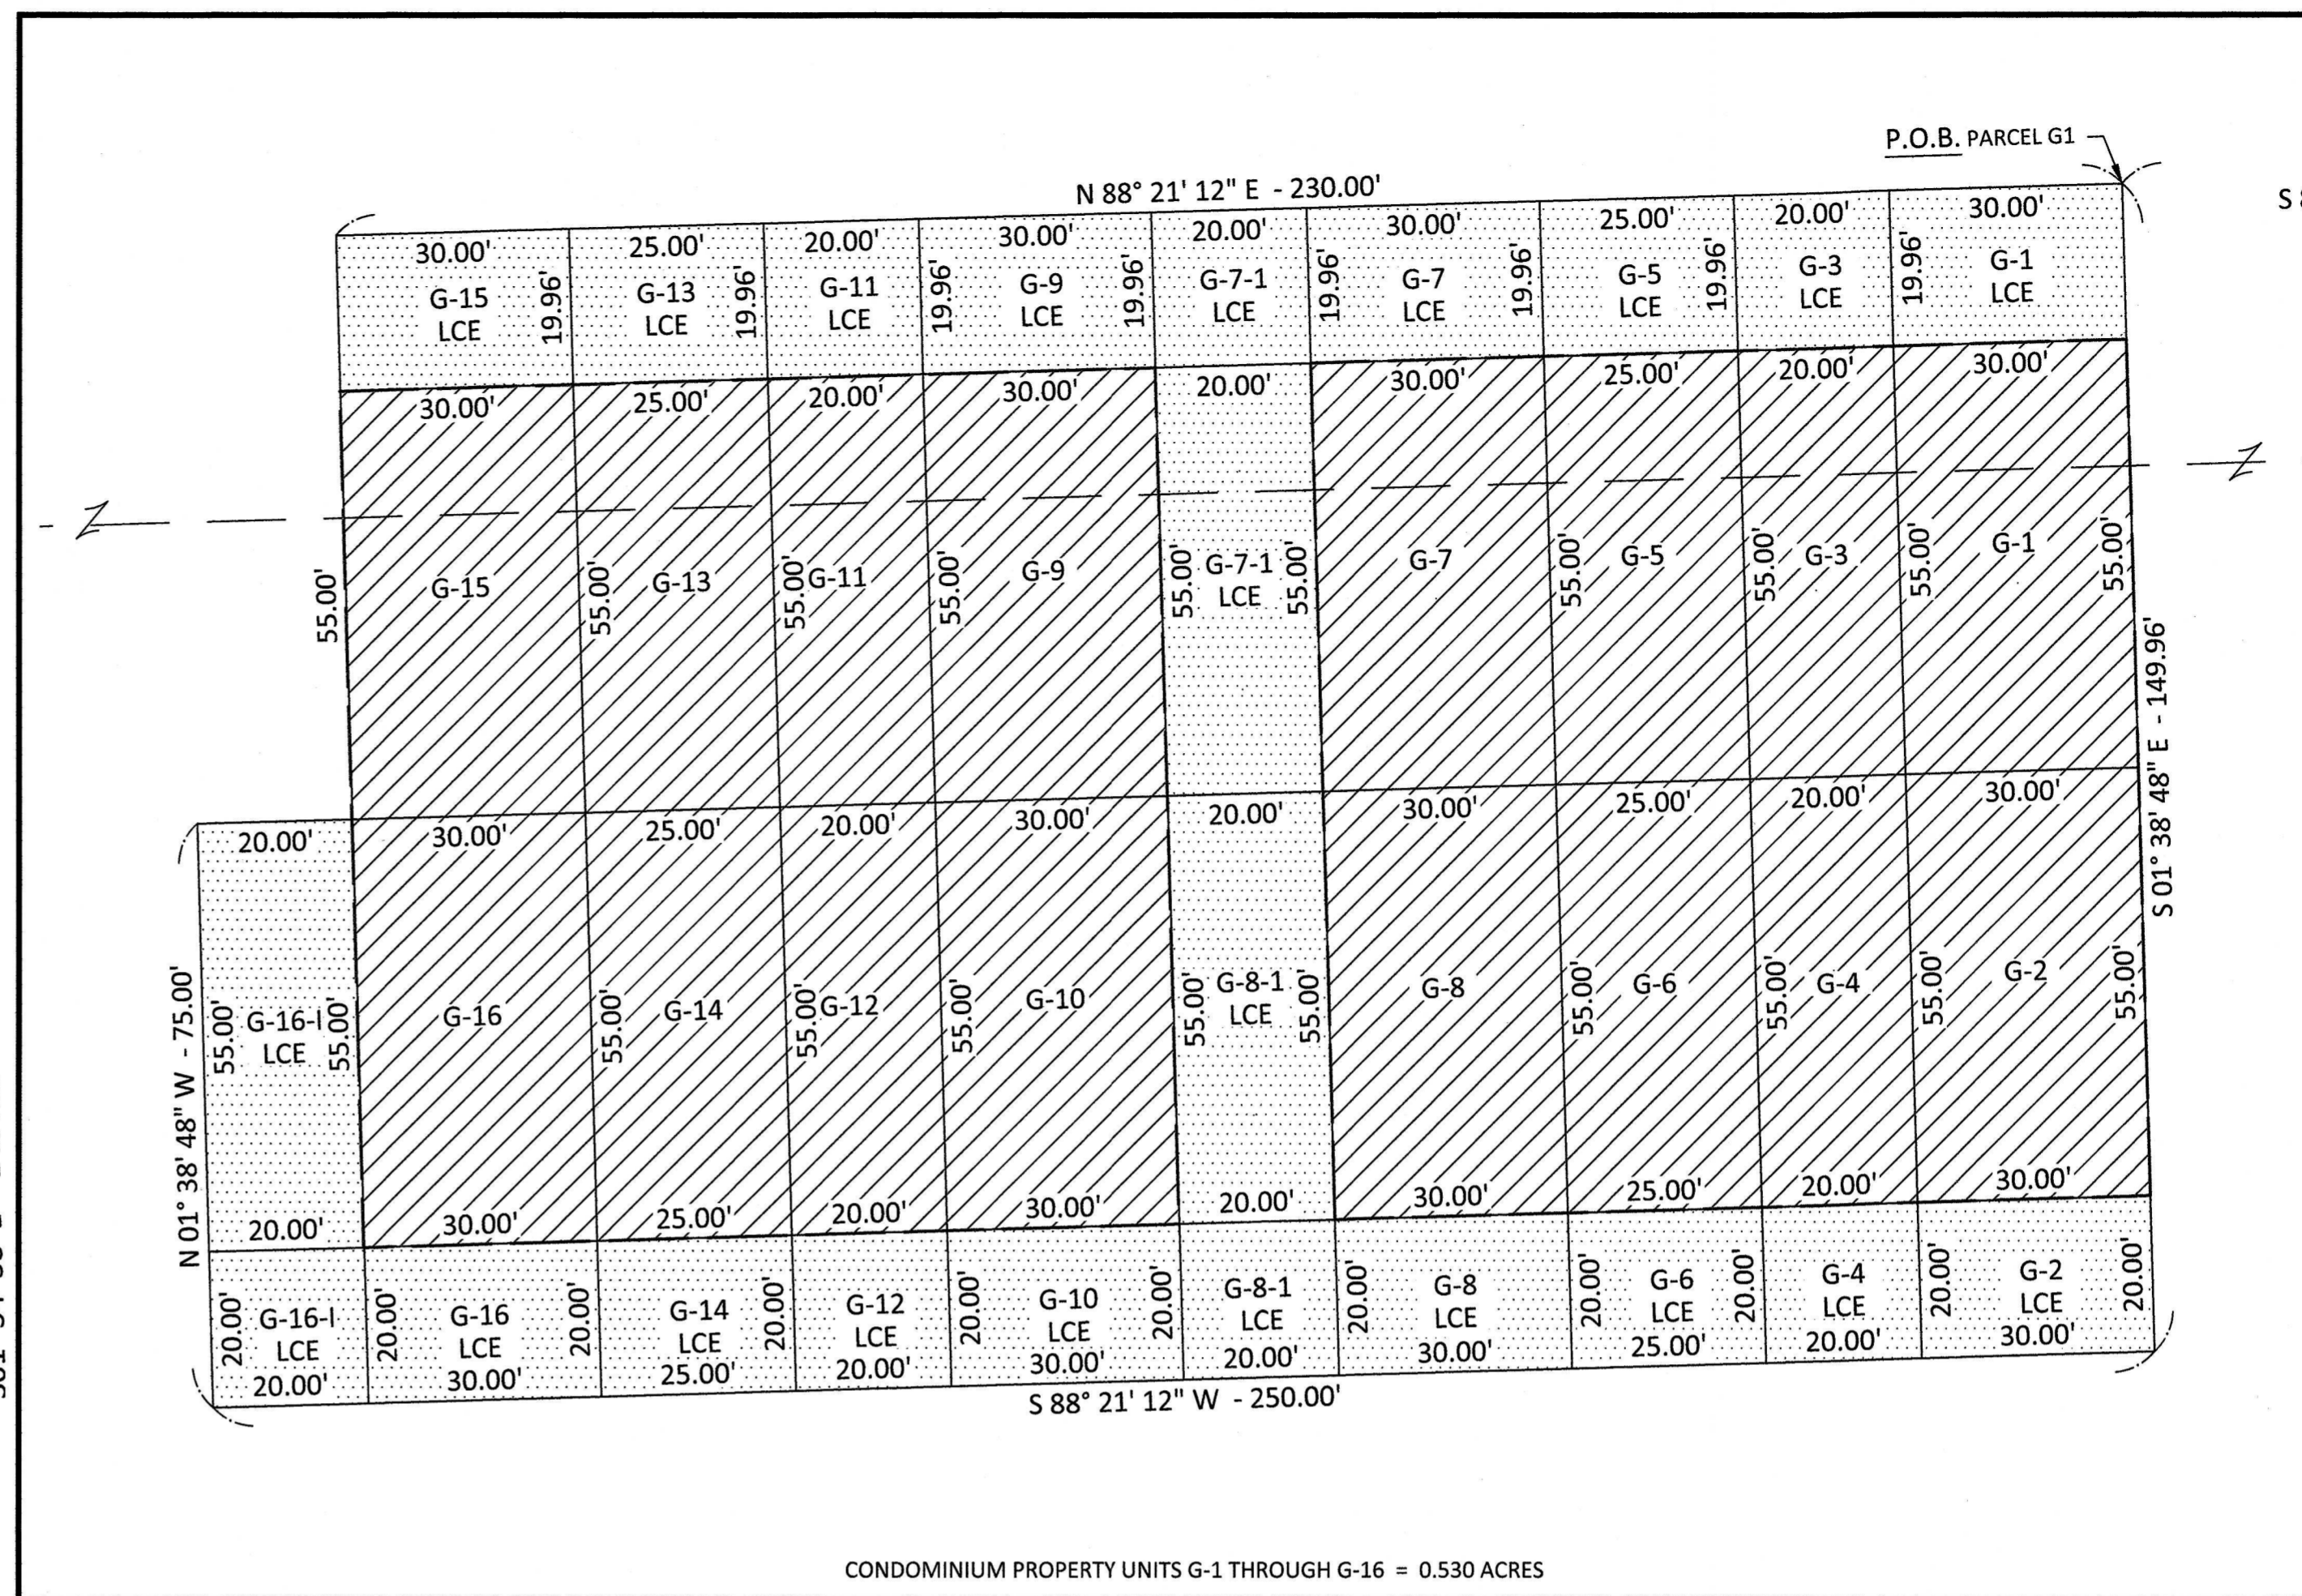


PLOTTED: Sep 26, 2023 - 3:15pm
 DRAWING: M:\22060 (Safe Harbor Development - Storage Condo Ph 2)\SURVEY\DWG\22x34 Safe Harbor Condominiums Twenty-First Amendment.dwg - PAGE1

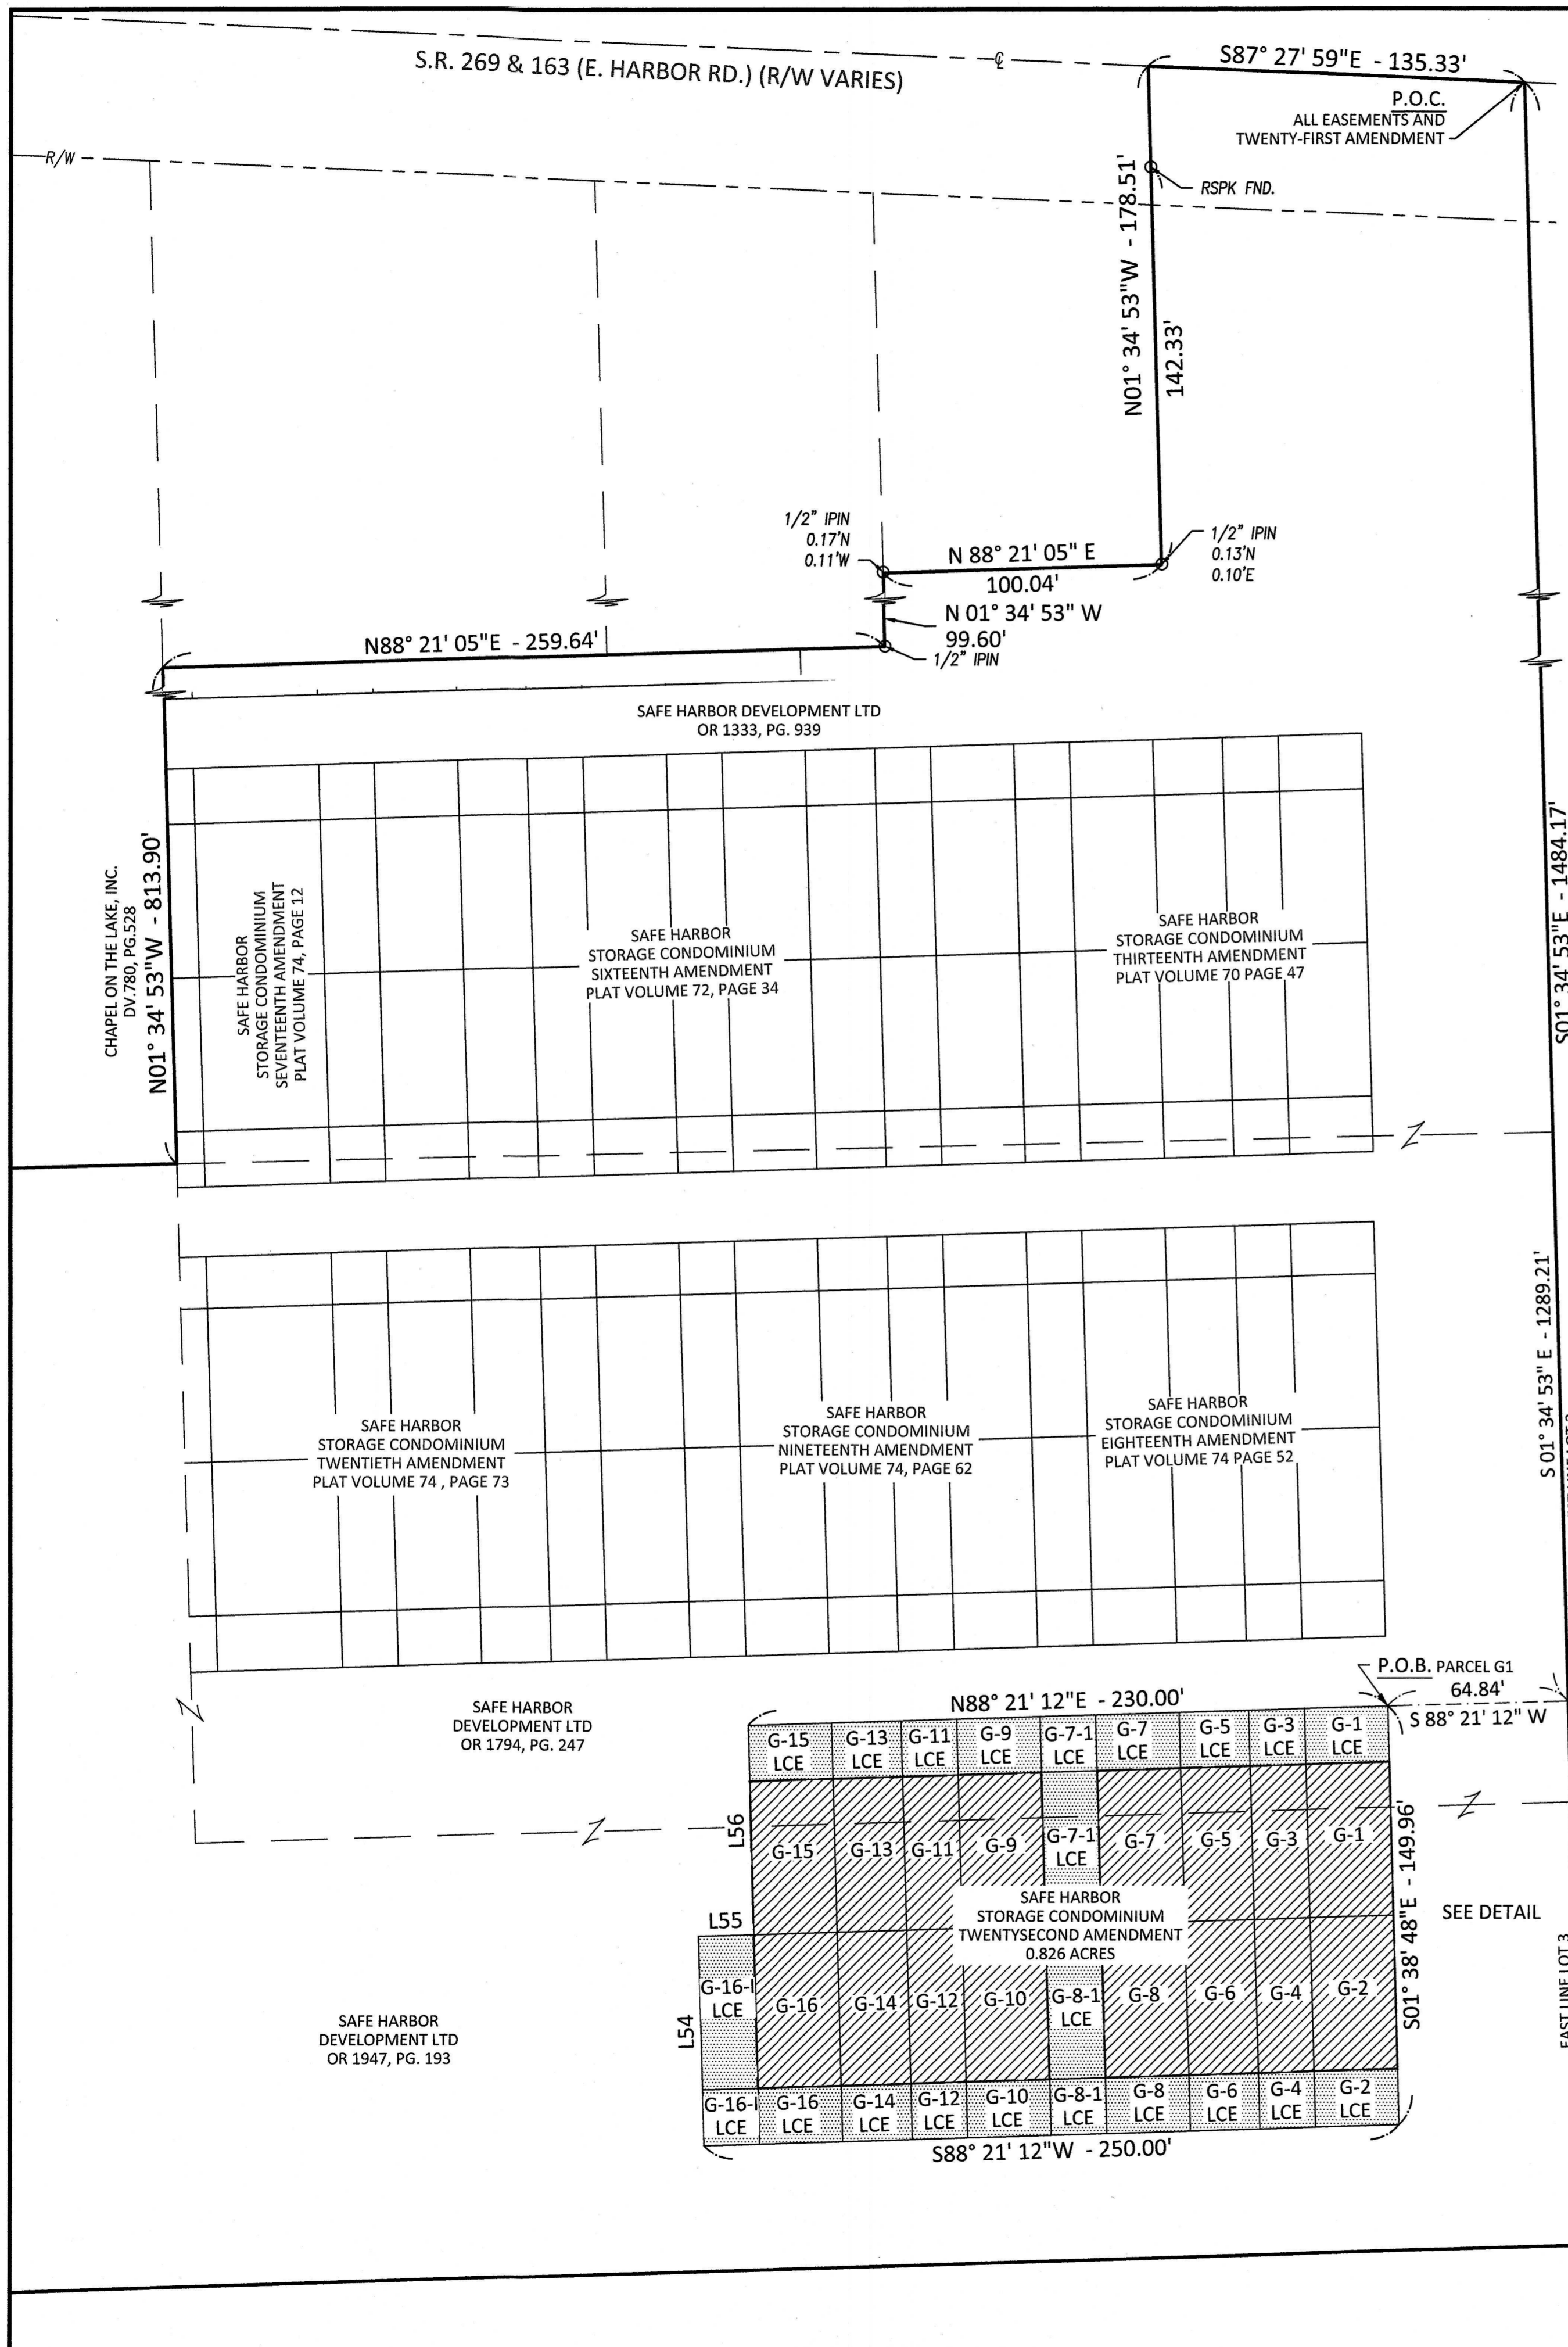

Line #	Direction	Length
L54	N 01° 38' 48" W	75.00'
L55	N 88° 21' 12" E	20.00'
L56	N 01° 38' 48" W	74.96'

TWENTYSECOND AMENDMENT

REFERENCES

- DEEDS AS SHOWN.
- SAFE HARBOR STORAGE CONDOMINIUM FIRST AMENDMENT, PLAT VOLUME 62, PAGE 24.
 - SAFE HARBOR STORAGE CONDOMINIUM, PLAT VOLUME 60, PAGE 17.
 - SAFE HARBOR STORAGE CONDOMINIUM THIRD AMENDMENT, PLAT VOLUME 63, PAGE 48.
 - SAFE HARBOR STORAGE CONDOMINIUM FOURTH AMENDMENT, PLAT VOLUME 64, PAGE 29.
 - SAFE HARBOR STORAGE CONDOMINIUM FIFTH AMENDMENT, PLAT VOLUME 65, PAGE 2.
 - SAFE HARBOR STORAGE CONDOMINIUM SIXTH AMENDMENT, PLAT VOLUME 66, PAGE 17.
 - SAFE HARBOR STORAGE CONDOMINIUM SEVENTH AMENDMENT, PLAT VOLUME 67, PAGE 36.
 - SAFE HARBOR STORAGE CONDOMINIUM EIGHTH AMENDMENT, PLAT VOLUME 67, PAGE 50.
 - SAFE HARBOR STORAGE CONDOMINIUM ELEVENTH AMENDMENT, PLAT VOLUME 69, PAGE 13.
 - SAFE HARBOR STORAGE CONDOMINIUM TWELFTH AMENDMENT, PLAT VOLUME 69, PAGE 55.
 - SAFE HARBOR STORAGE CONDOMINIUM THIRTEENTH AMENDMENT, PLAT VOLUME 70, PAGE 47.
 - SAFE HARBOR STORAGE CONDOMINIUM FOURTEENTH AMENDMENT, PLAT VOLUME 71, PAGE 21.
 - SAFE HARBOR STORAGE CONDOMINIUM FIFTEENTH AMENDMENT, DEED BOOK 1833, PAGE 132.
 - SAFE HARBOR STORAGE CONDOMINIUM SIXTEENTH AMENDMENT, PLAT VOLUME 72, PAGE 34.
 - SAFE HARBOR STORAGE CONDOMINIUM SEVENTEENTH AMENDMENT, PLAT VOLUME 74, PAGE 12.
 - SAFE HARBOR STORAGE CONDOMINIUM EIGHTEENTH AMENDMENT, PLAT VOLUME 74, PAGE 52.
 - SAFE HARBOR STORAGE CONDOMINIUM NINETEENTH AMENDMENT, PLAT VOLUME 74, PAGE 62.
 - SAFE HARBOR STORAGE CONDOMINIUM TWENTIETH AMENDMENT, PLAT VOLUME 74, PAGE 73.

DGL CONSULTING ENGINEERS, LLC
 3455 BRIARFIELD BLVD, SUITE E
 MAUMEE, OH 43537
 PHONE: 419.535.1015
 www.dgl-td.com

SAFE HARBOR STORAGE CONDOMINIUM TWENTYSECOND AMENDMENT

LOCATED IN PART OF LOT 03, SECTION 04, DANBURY TOWNSHIP, OTTAWA COUNTY, OHIO.

FILE:	TWENTYSECOND
JOB NO.:	22060-
DRAWN BY:	GSW
ISSUED:	08/30/2023


1/6



SURVEYOR'S CERTIFICATION:
 I HEREBY DECLARE THAT THE DRAWING ACCURATELY REFLECTS THE LOCATION OF IMPROVEMENTS AND RECORDED EASEMENTS TO THE BEST OF MY KNOWLEDGE AND BELIEF.

Peter J. Seggaard
 PETER J. SEGAARD, P.S. / OHIO PROFESSIONAL SURVEYOR NO. 7883

DATE: 9-26-2023

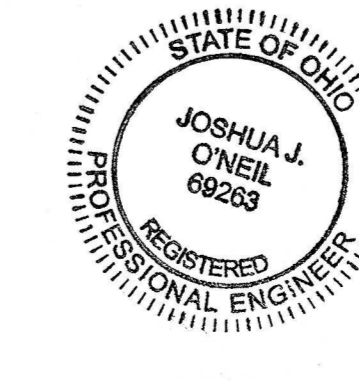

ENGINEER'S CERTIFICATION:
 I HEREBY DECLARE THAT THE DRAWING ACCURATELY SHOWS EACH BUILDING AS BUILT TO THE BEST OF MY KNOWLEDGE AND BELIEF.

Joshua J. O'Neil
 JOSHUA J. O'NEIL, P.E. / OHIO PROFESSIONAL ENGINEER NO. 69263


DATE: 9-27-2023

SCALE: 1" = 40'


NO	REVISION	DATE
9		
8		
7		
6		
5		
4		
3		
2	REVISED PER CLIENT MODIFICATION	9/14/23
1	LIMITED COMMON ELEMENT FENCE	

- LEGEND**
- MONUMENT FOUND
 - MONUMENT SET
 - (G) CALCULATED DISTANCE
 - (M) MEASURED DISTANCE
 - (RE) RECORD DISTANCE
 - R/W RIGHT-OF-WAY
 - P.O.C. POINT OF COMMENCEMENT
 - UNIT LIMITS
 - LIMITED COMMON ELEMENT
 - FENCE

PLOTTED: Sep 26, 2023 - 2:32pm
 DRAWING: W:\22060 (Safe Harbor Development - Storage Condo Ph 2)\SURVEY\DWG\22x34 Safe Harbor Condominiums Twenty-First Amendment.dwg - PAGE2

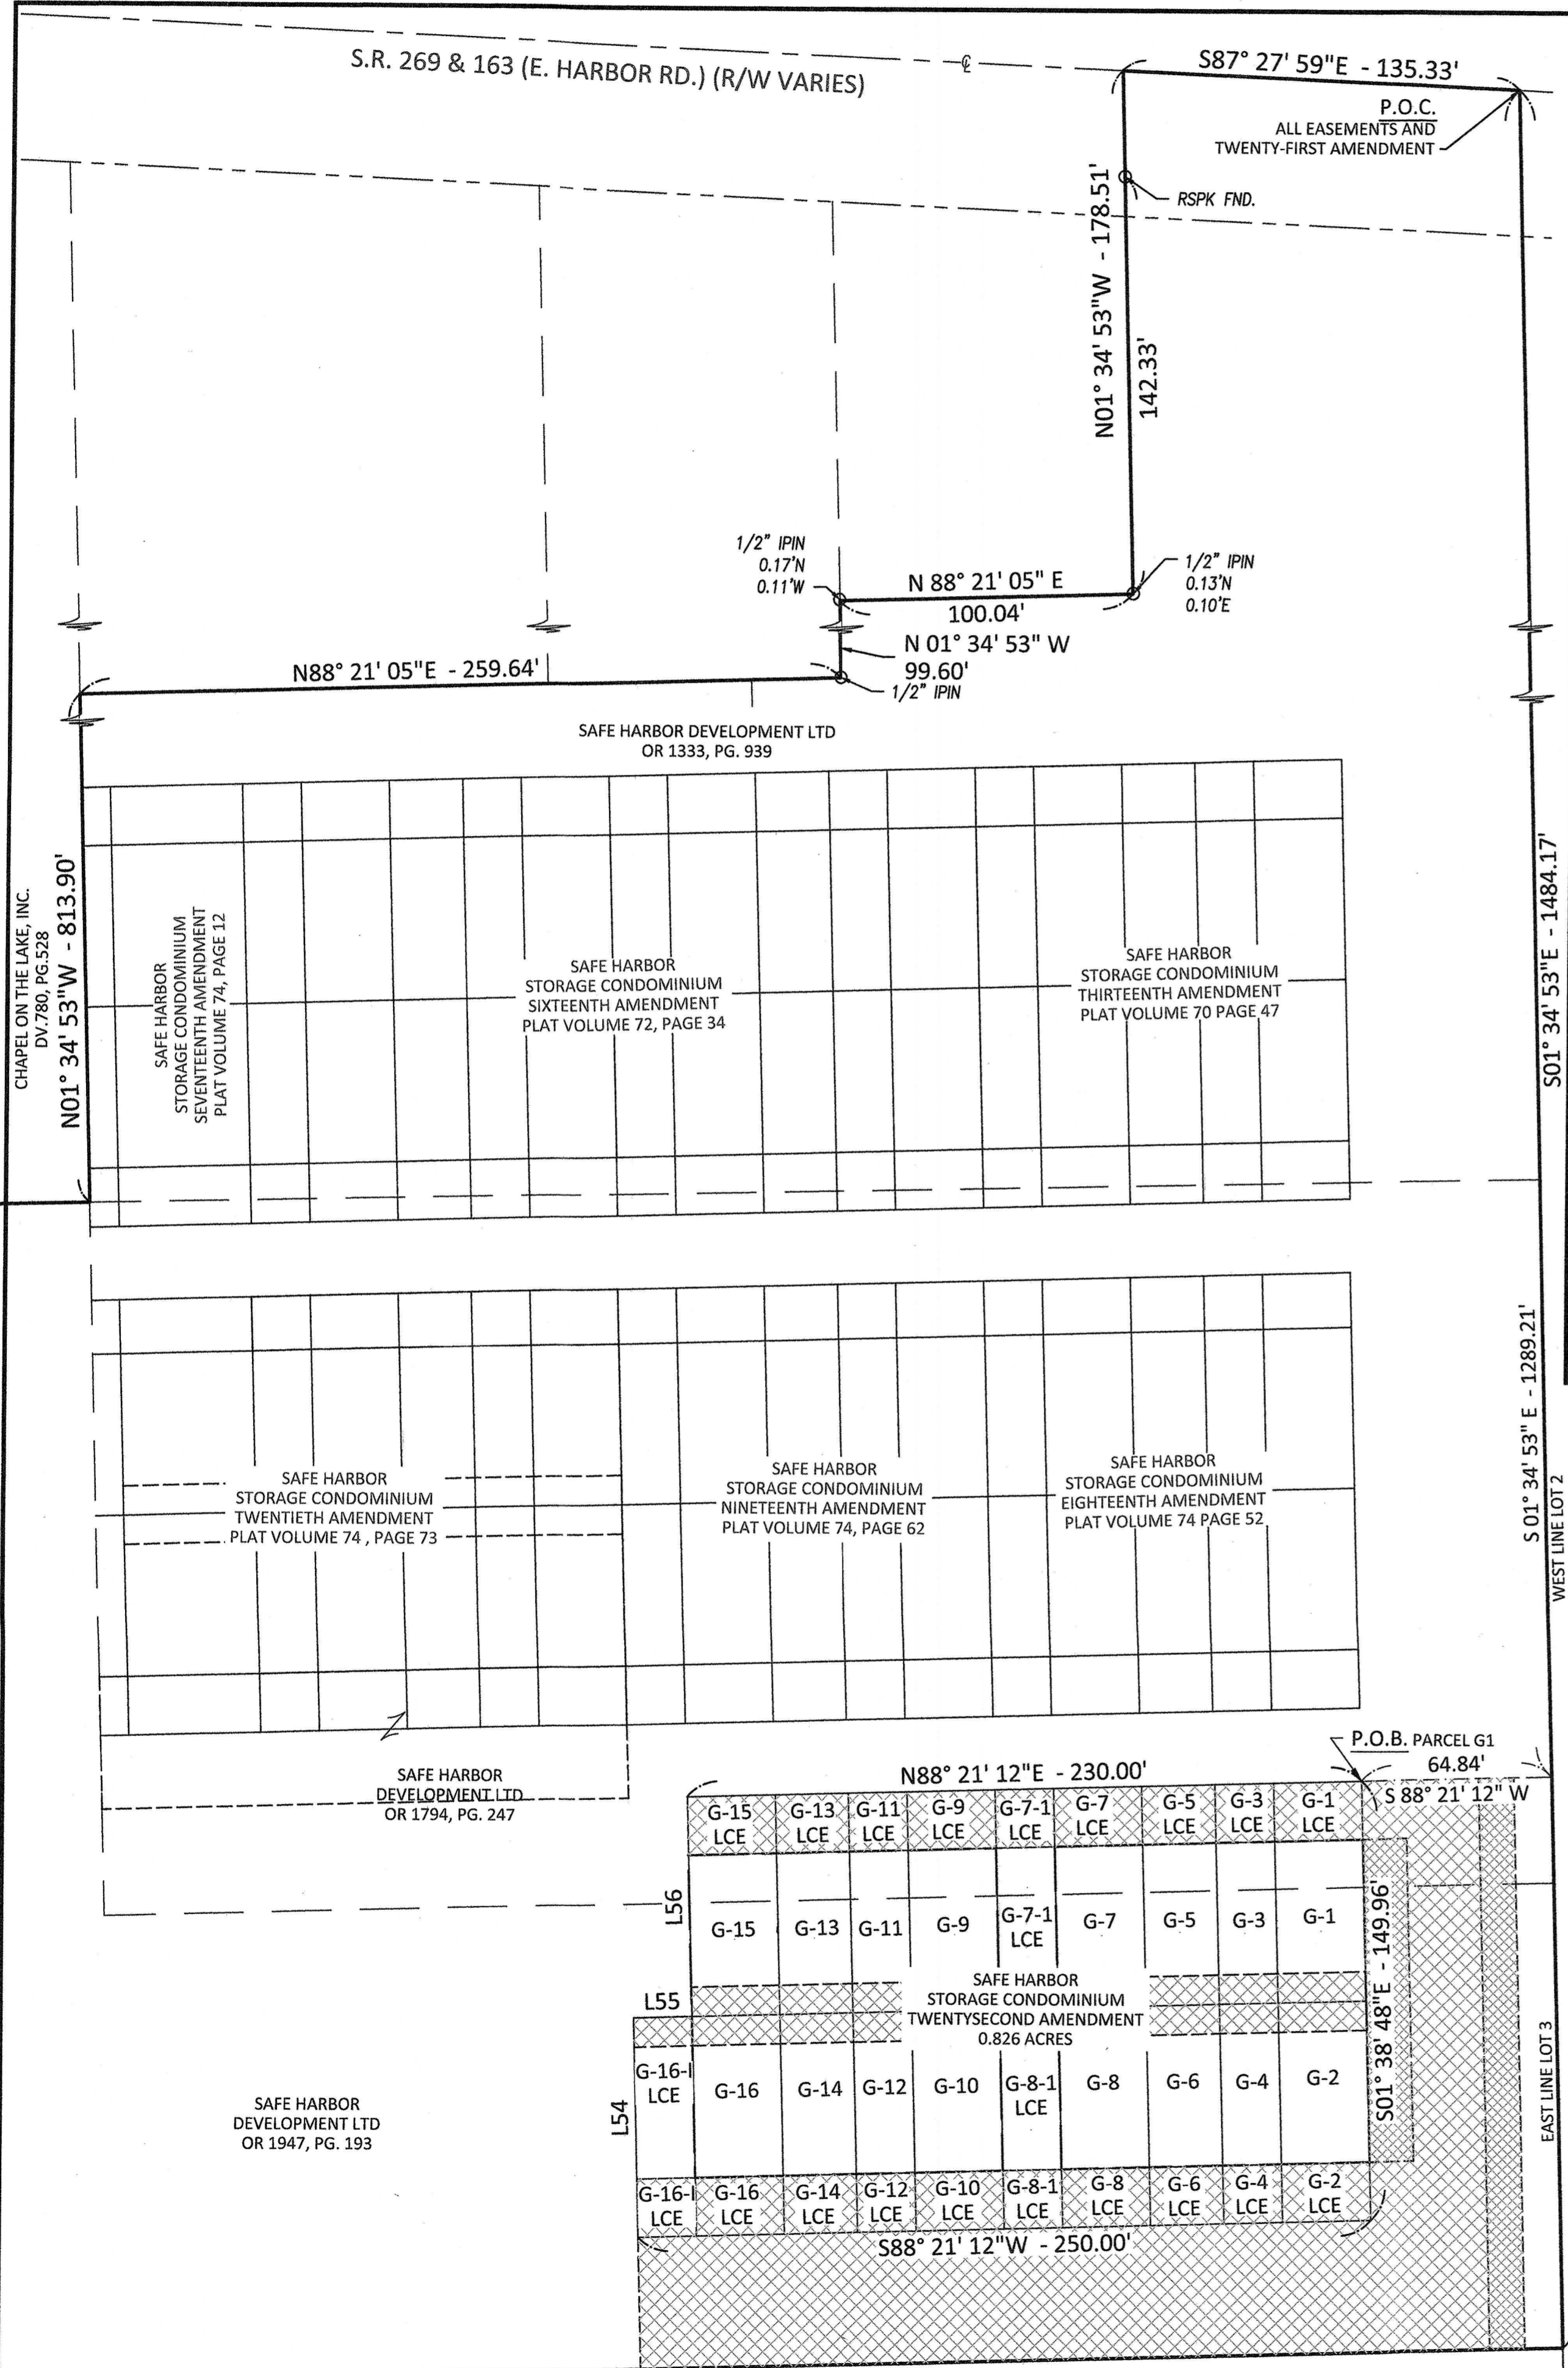

Line Table		
Line #	Direction	Length
L57	N 88° 21' 12" E	20.00'

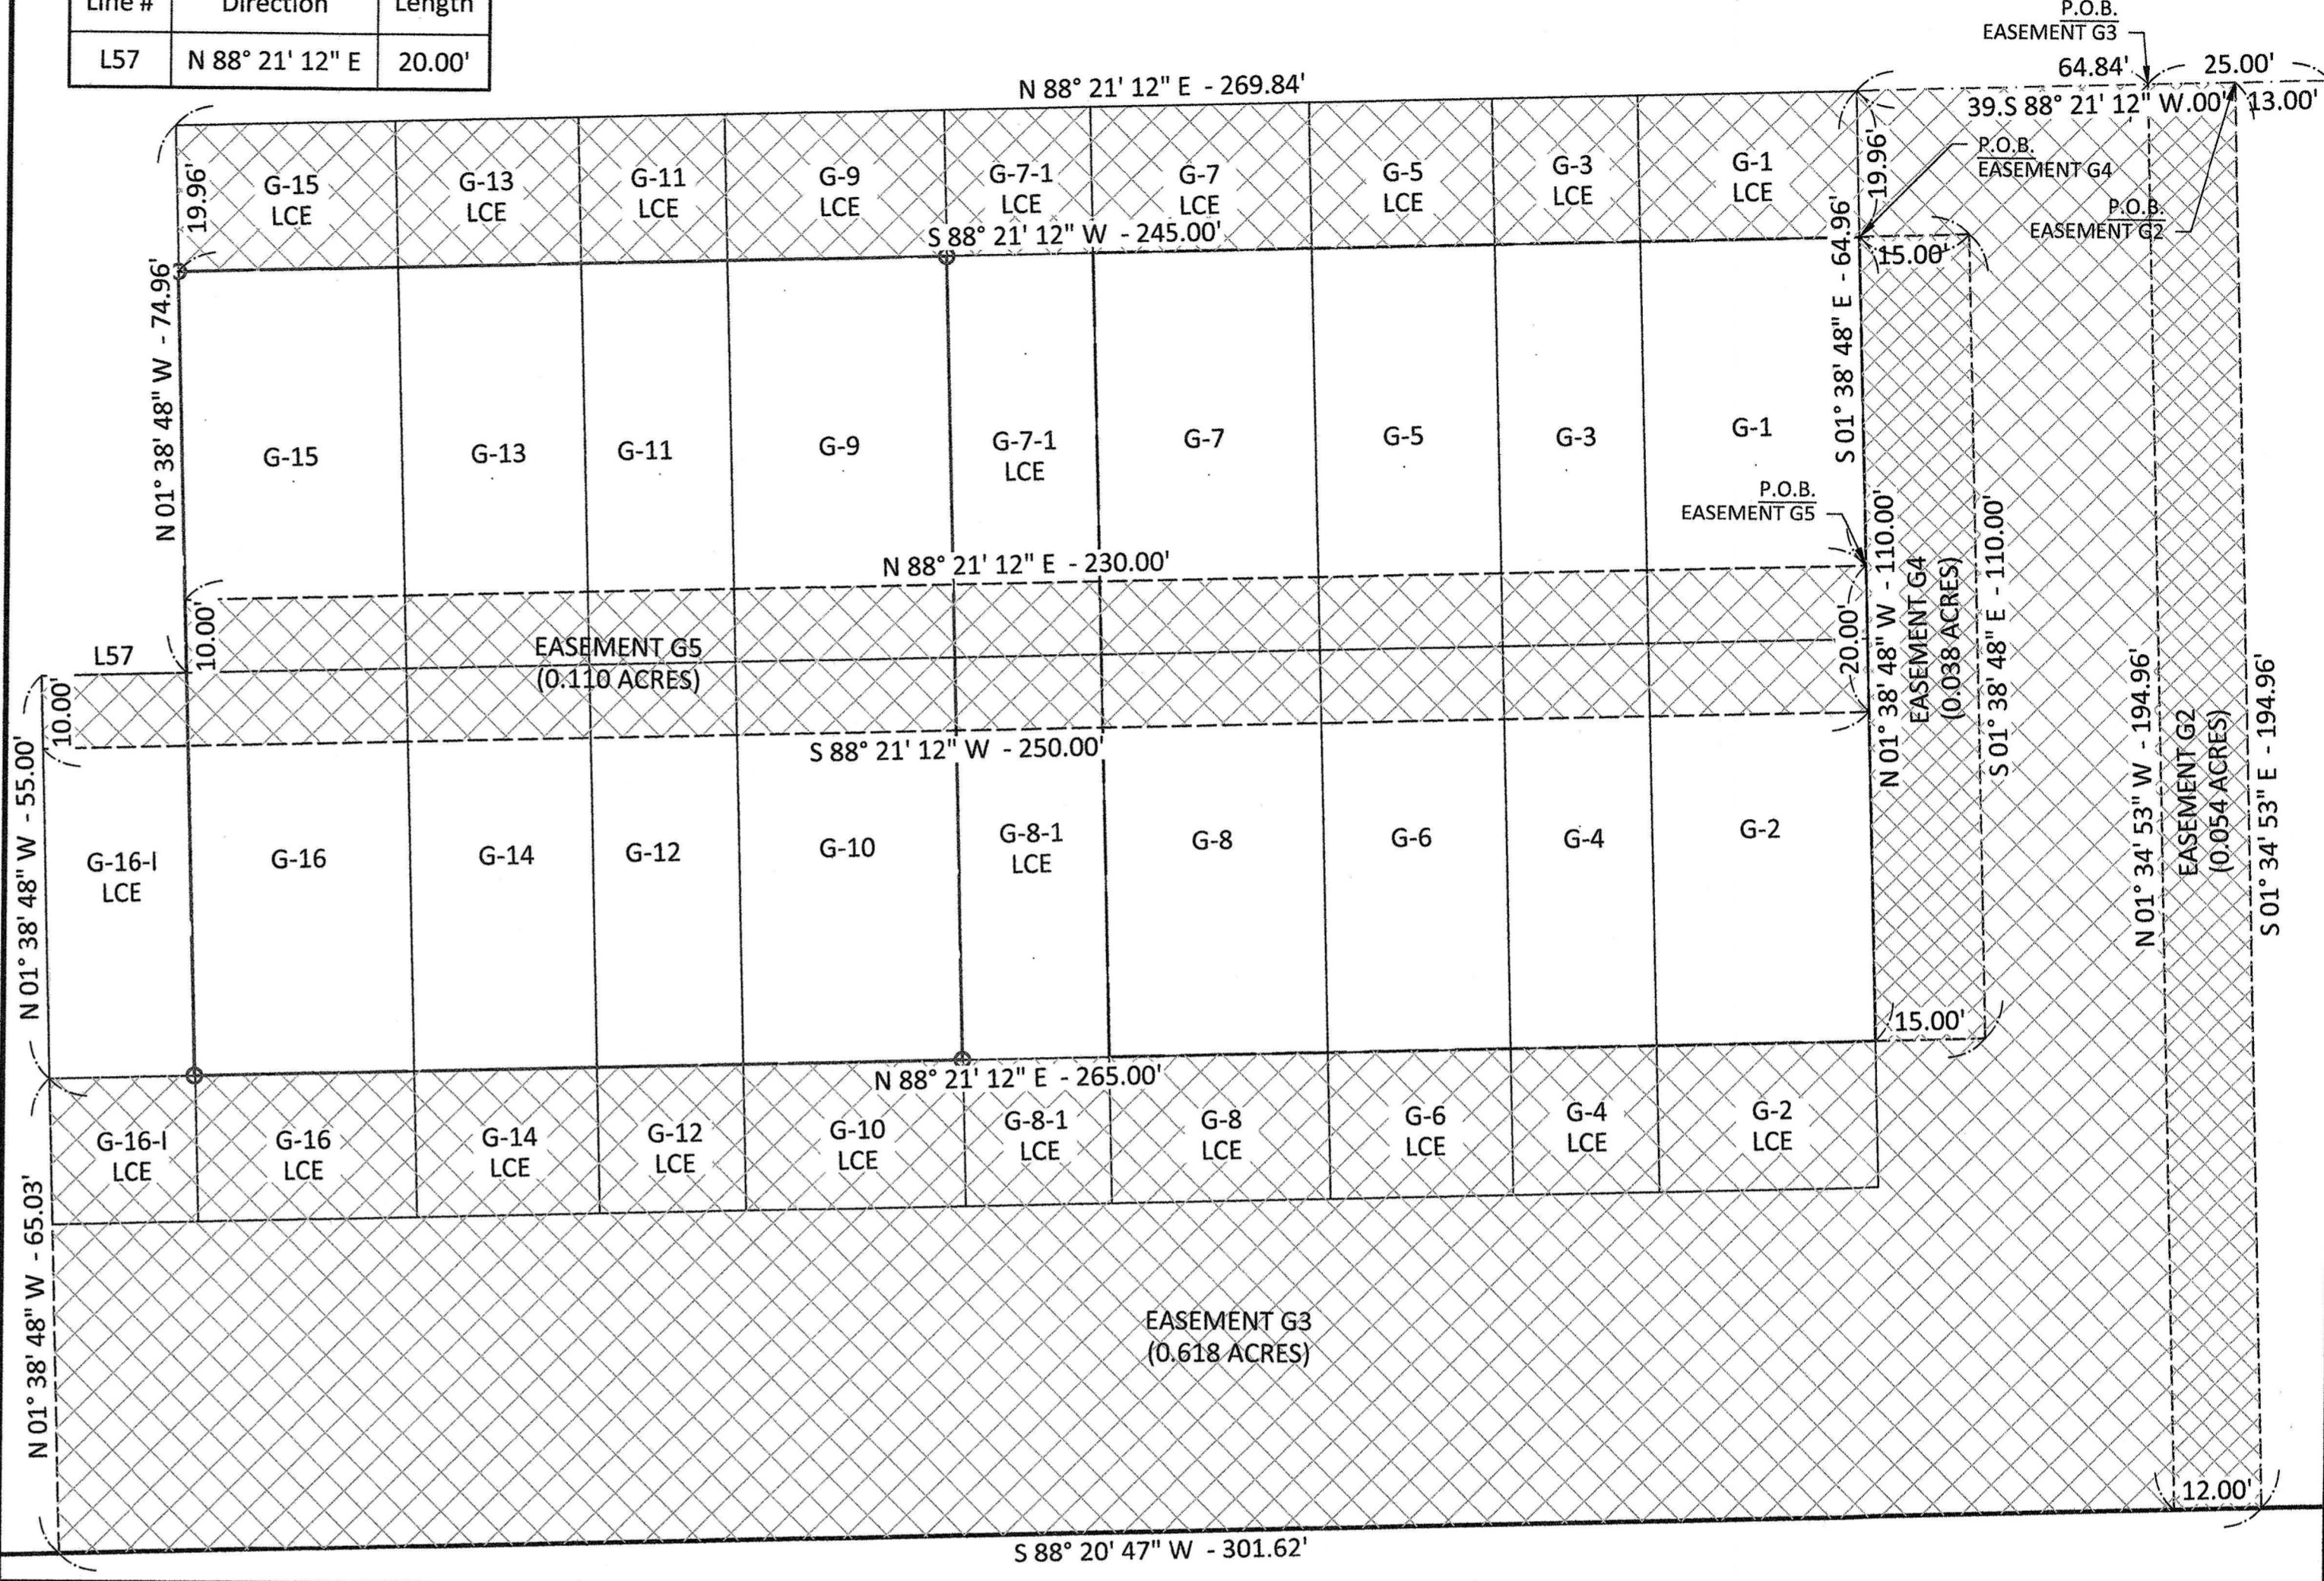


SCALE: 1"=20'

LEGEND

- MONUMENT FOUND
- MONUMENT SET
- (C) CALCULATED DISTANCE
- (M) MEASURED DISTANCE
- (REC) RECORD DISTANCE
- R/W RIGHT-OF-WAY
- P.O.B. POINT OF BEGINNING
- P.O.C. POINT OF COMMENCEMENT
- UNIT
- LIMITED COMMON ELEMENT
- EASEMENT

REFERENCES

- DEEDS AS SHOWN.
- SAFE HARBOR STORAGE CONDOMINIUM FIRST AMENDMENT, PLAT VOLUME 62, PAGE 24.
- SAFE HARBOR STORAGE CONDOMINIUM, PLAT VOLUME 60, PAGE 17.
- SAFE HARBOR STORAGE CONDOMINIUM THIRD AMENDMENT, PLAT VOLUME 63, PAGE 48.
- SAFE HARBOR STORAGE CONDOMINIUM FOURTH AMENDMENT, PLAT VOLUME 64, PAGE 29.
- SAFE HARBOR STORAGE CONDOMINIUM FIFTH AMENDMENT, PLAT VOLUME 65, PAGE 2.
- SAFE HARBOR STORAGE CONDOMINIUM SIXTH AMENDMENT, PLAT VOLUME 66, PAGE 17.
- SAFE HARBOR STORAGE CONDOMINIUM SEVENTH AMENDMENT, PLAT VOLUME 67, PAGE 36.
- SAFE HARBOR STORAGE CONDOMINIUM EIGHTH AMENDMENT, PLAT VOLUME 67, PAGE 50.
- SAFE HARBOR STORAGE CONDOMINIUM ELEVENTH AMENDMENT, PLAT VOLUME 69, PAGE 13.
- SAFE HARBOR STORAGE CONDOMINIUM TWELFTH AMENDMENT, PLAT VOLUME 69, PAGE 55.
- SAFE HARBOR STORAGE CONDOMINIUM THIRTEENTH AMENDMENT, PLAT VOLUME 70, PAGE 47.
- SAFE HARBOR STORAGE CONDOMINIUM FOURTEENTH AMENDMENT, PLAT VOLUME 71, PAGE 21.
- SAFE HARBOR STORAGE CONDOMINIUM FIFTEENTH AMENDMENT, DEED BOOK 1833, PAGE 132.
- SAFE HARBOR STORAGE CONDOMINIUM SIXTEENTH AMENDMENT, PLAT VOLUME 72, PAGE 34.
- SAFE HARBOR STORAGE CONDOMINIUM SEVENTEENTH AMENDMENT, PLAT VOLUME 74, PAGE 12.
- SAFE HARBOR STORAGE CONDOMINIUM EIGHTEENTH AMENDMENT, PLAT VOLUME 74, PAGE 52.
- SAFE HARBOR STORAGE CONDOMINIUM NINETEENTH AMENDMENT, PLAT VOLUME 74, PAGE 62.
- SAFE HARBOR STORAGE CONDOMINIUM TWENTIETH AMENDMENT, PLAT VOLUME 74, PAGE 73.

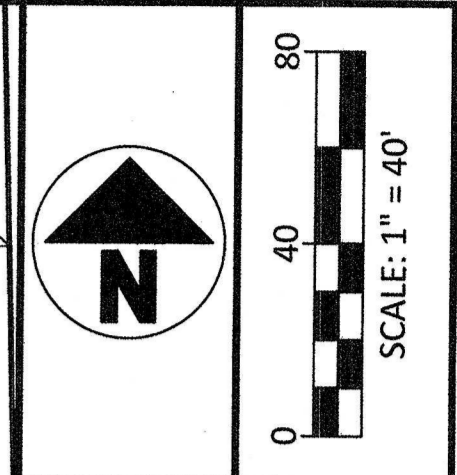

NO	REVISION	DATE
9		
8		
7		
6		
5		
4		
3		
2		
1		

DGL CONSULTING ENGINEERS, LLC
 3455 BRIARFIELD BLVD., SUITE E
 MAUMEE, OH 43537
 PHONE: 419-335-1015
 www.dglinc.com

SAFE HARBOR STORAGE CONDOMINIUM TWENTYSECOND AMENDMENT
 LOCATED IN PART OF LOT 03, SECTION 04, DANBURY TOWNSHIP, OTTAWA COUNTY, OHIO.

FILE:	TWENTYSECOND
JOB NO.:	22060-
DRAWN BY:	GSW/PJS
ISSUED:	9/21/2023