
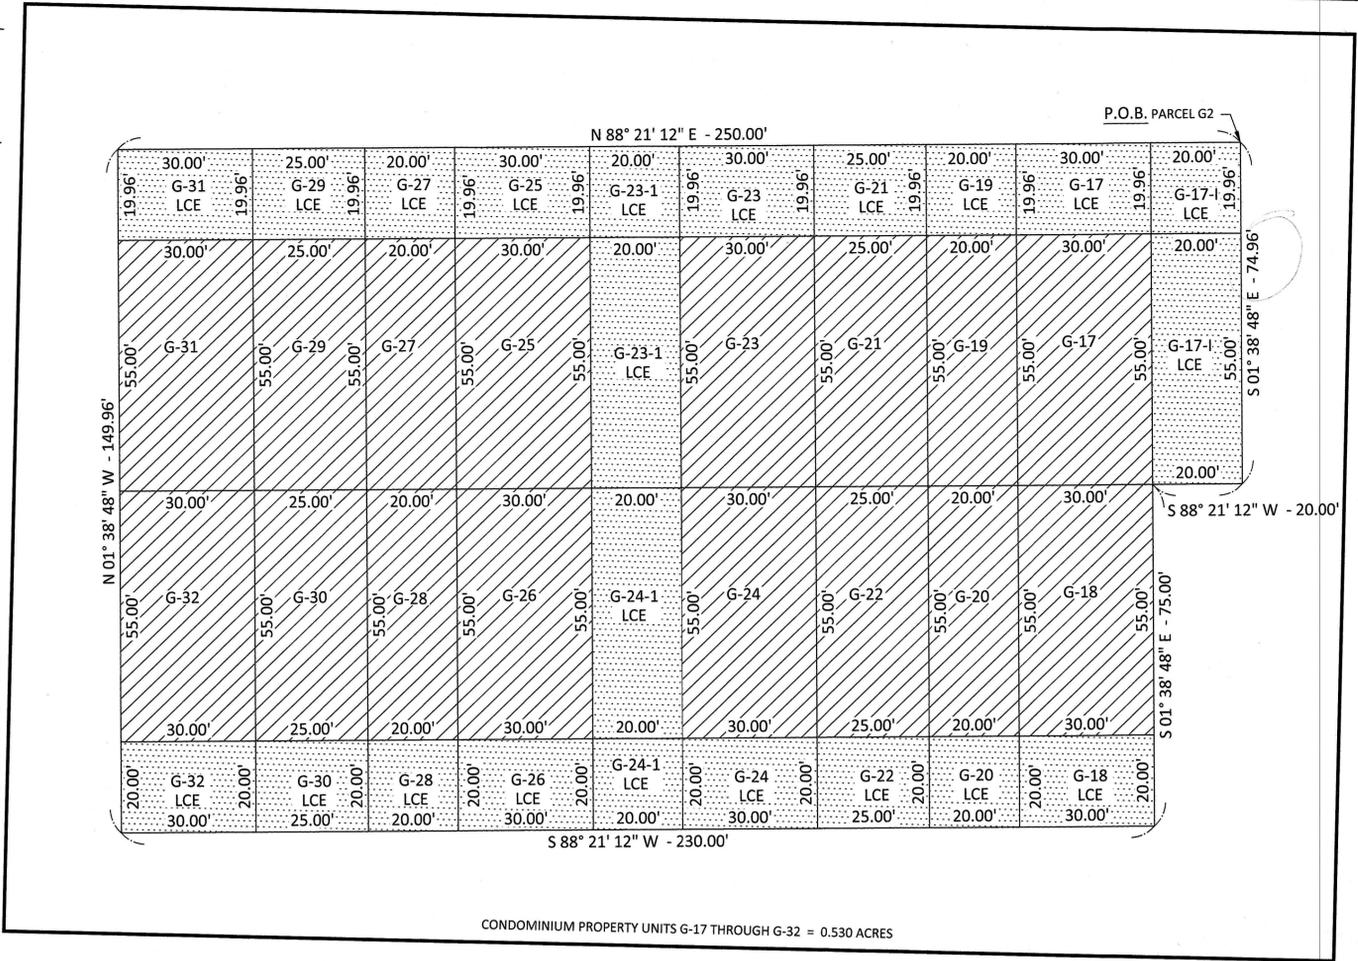


PLOTTED: Sep 25, 2024 - 12:00pm
 DRAWING: M:\22060 (Safe Harbor Development - Storage Condo Ph 2)\SURVEY\DWG\22060 Safe Harbor Condominiums Twenty-Third Amendment.dwg - PAGE1

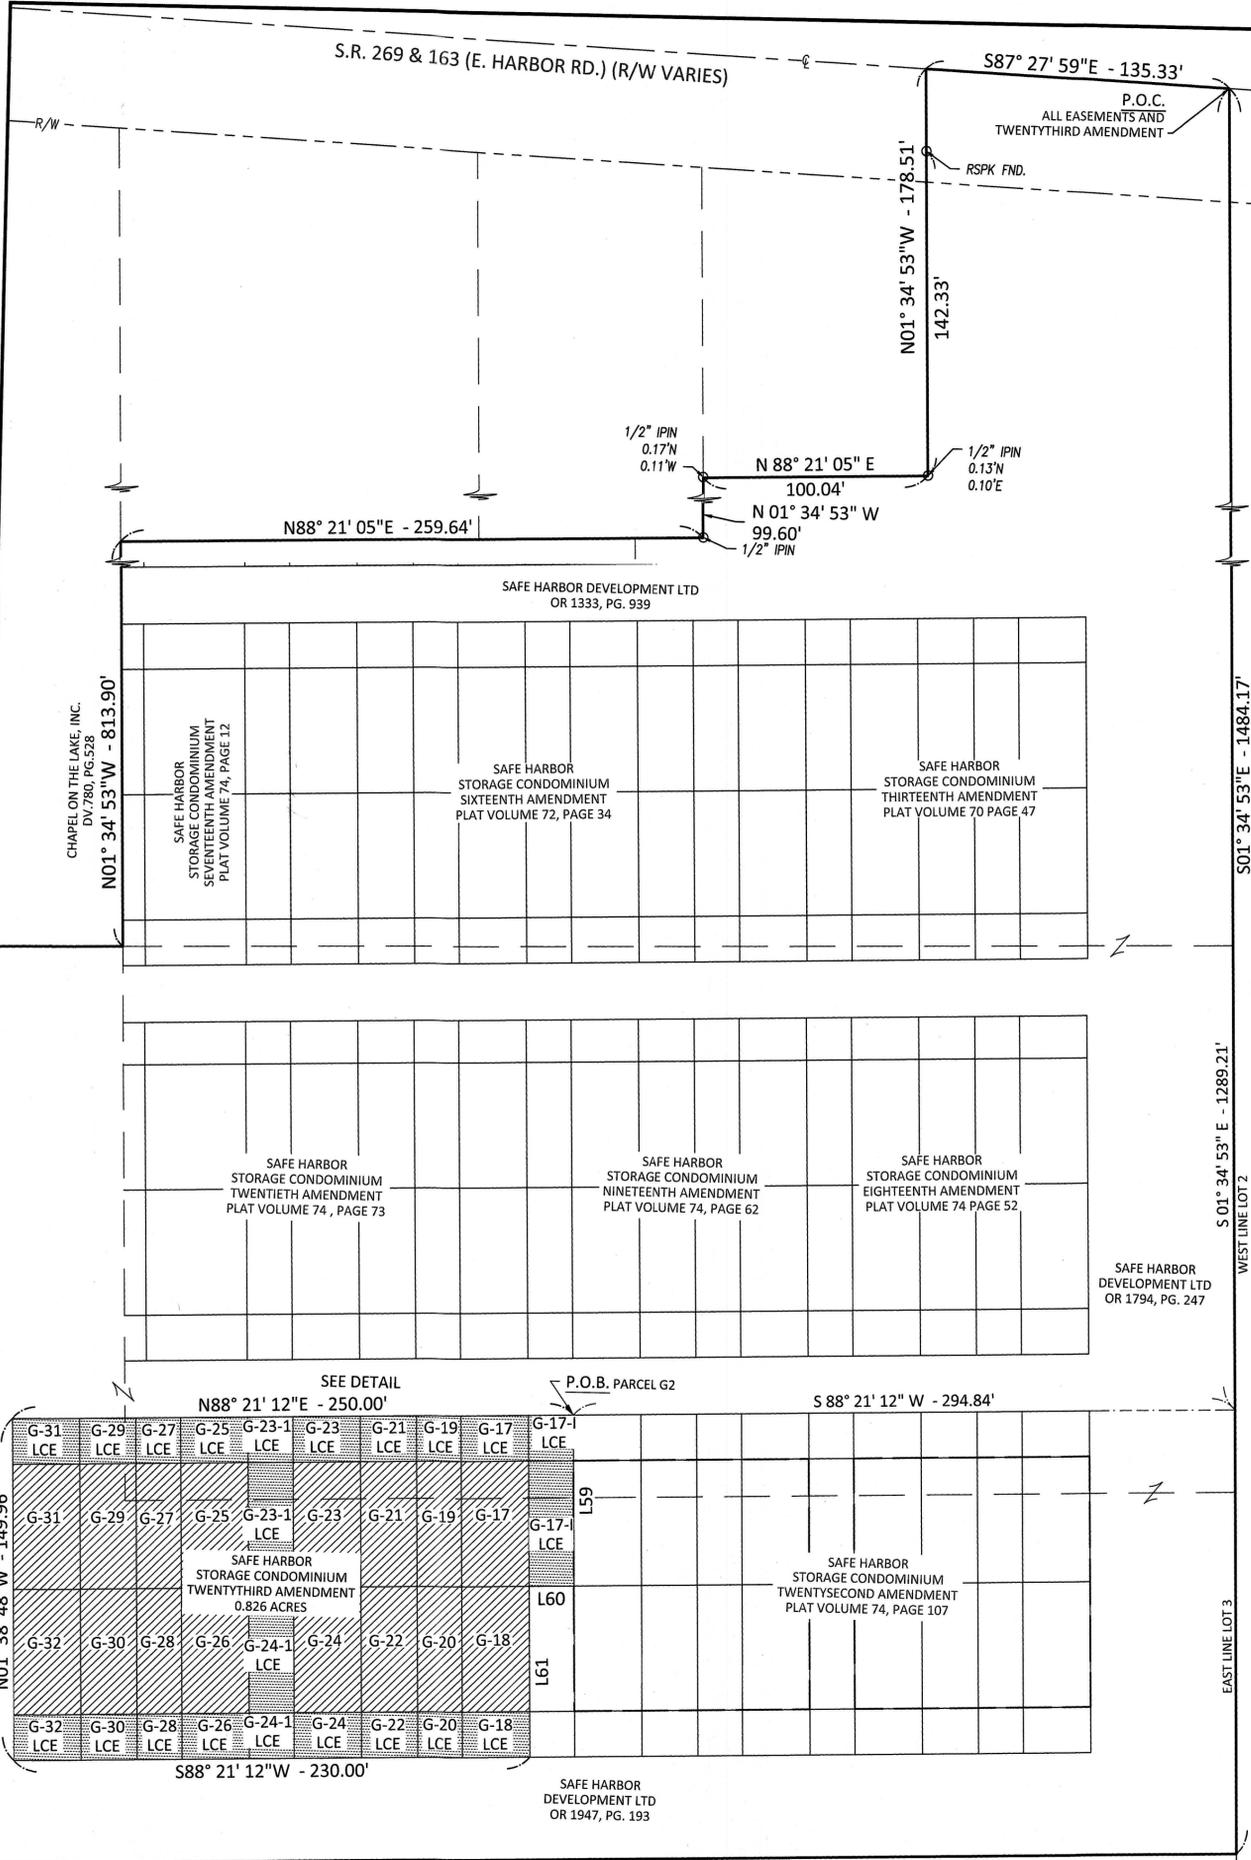

Line Table

Line #	Direction	Length
L59	S 01° 38' 48" E	74.96'
L60	S 88° 21' 12" W	20.00'
L61	S 01° 38' 48" E	75.00'

TWENTYTHIRD AMENDMENT

SCALE: 1"=20'

- REFERENCES
- DEEDS AS SHOWN.
 - SAFE HARBOR STORAGE CONDOMINIUM FIRST AMENDMENT, PLAT VOLUME 62, PAGE 24.
 - SAFE HARBOR STORAGE CONDOMINIUM, PLAT VOLUME 60, PAGE 17.
 - SAFE HARBOR STORAGE CONDOMINIUM THIRD AMENDMENT, PLAT VOLUME 63, PAGE 48.
 - SAFE HARBOR STORAGE CONDOMINIUM FOURTH AMENDMENT, PLAT VOLUME 64, PAGE 29.
 - SAFE HARBOR STORAGE CONDOMINIUM FIFTH AMENDMENT, PLAT VOLUME 65, PAGE 2.
 - SAFE HARBOR STORAGE CONDOMINIUM SIXTH AMENDMENT, PLAT VOLUME 66, PAGE 17.
 - SAFE HARBOR STORAGE CONDOMINIUM SEVENTH AMENDMENT, PLAT VOLUME 67, PAGE 36.
 - SAFE HARBOR STORAGE CONDOMINIUM EIGHTH AMENDMENT, PLAT VOLUME 67, PAGE 50.
 - SAFE HARBOR STORAGE CONDOMINIUM ELEVENTH AMENDMENT, PLAT VOLUME 69, PAGE 13.
 - SAFE HARBOR STORAGE CONDOMINIUM TWELFTH AMENDMENT, PLAT VOLUME 69, PAGE 55.
 - SAFE HARBOR STORAGE CONDOMINIUM THIRTEENTH AMENDMENT, PLAT VOLUME 70, PAGE 47.
 - SAFE HARBOR STORAGE CONDOMINIUM FOURTEENTH AMENDMENT, PLAT VOLUME 71, PAGE 21.
 - SAFE HARBOR STORAGE CONDOMINIUM FIFTEENTH AMENDMENT, DEED BOOK 1833, PAGE 132.
 - SAFE HARBOR STORAGE CONDOMINIUM SIXTEENTH AMENDMENT, PLAT VOLUME 72, PAGE 34.
 - SAFE HARBOR STORAGE CONDOMINIUM SEVENTEENTH AMENDMENT, PLAT VOLUME 74, PAGE 12.
 - SAFE HARBOR STORAGE CONDOMINIUM EIGHTEENTH AMENDMENT, PLAT VOLUME 74, PAGE 52.
 - SAFE HARBOR STORAGE CONDOMINIUM NINETEENTH AMENDMENT, PLAT VOLUME 74, PAGE 62.
 - SAFE HARBOR STORAGE CONDOMINIUM TWENTIETH AMENDMENT, PLAT VOLUME 74, PAGE 73.
 - SAFE HARBOR STORAGE CONDOMINIUM TWENTYSECOND AMENDMENT, PLAT VOLUME 74, PAGE 107.



SURVEYOR'S CERTIFICATION:
 I HEREBY DECLARE THAT THE DRAWING ACCURATELY REFLECTS THE LOCATION OF IMPROVEMENTS AND RECORDED EASEMENTS TO THE BEST OF MY KNOWLEDGE AND BELIEF.

PETER J. SEGAARD, P.S.
 OHIO PROFESSIONAL SURVEYOR NO. 7883


DATE: 9-25-2024



ENGINEER'S CERTIFICATION:
 I HEREBY DECLARE THAT THE DRAWING ACCURATELY SHOWS EACH BUILDING AS BUILT TO THE BEST OF MY KNOWLEDGE AND BELIEF.

JOSHUA J. O'NEIL, P.E.
 OHIO PROFESSIONAL ENGINEER NO. 69263

DATE: 9-25-2024

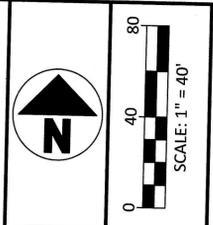

LEGEND

- MONUMENT FOUND
- CALCULATED DISTANCE
- MEASURED DISTANCE
- RIGHT-OF-WAY
- POINT OF BEGINNING
- POINT OF COMMENCEMENT
- UNITS
- LIMITED COMMON ELEMENT
- FENCE

NO	REVISION	DATE
9		
8		
7		
6		
5		
4		
3		
2		
1		




SAFE HARBOR STORAGE CONDOMINIUM TWENTYTHIRD AMENDMENT

LOCATED IN PART OF LOT 03, SECTION 04, DANBURY TOWNSHIP, OTTAWA COUNTY, OHIO.


FILE:	TWENTYTHIRD
JOB NO.:	22060-
DRAWN BY:	GSW
ISSUED:	07/11/2024

PLOTTED: Sep 25, 2024 - 12:02pm
 DRAWING: M:\22060 (Safe Harbor Development - Storage Condo Ph 2) \SURVEY (Dwg) 22060_Safe Harbor Condominiums Twenty-Third Amendment.dwg - PAGE 2

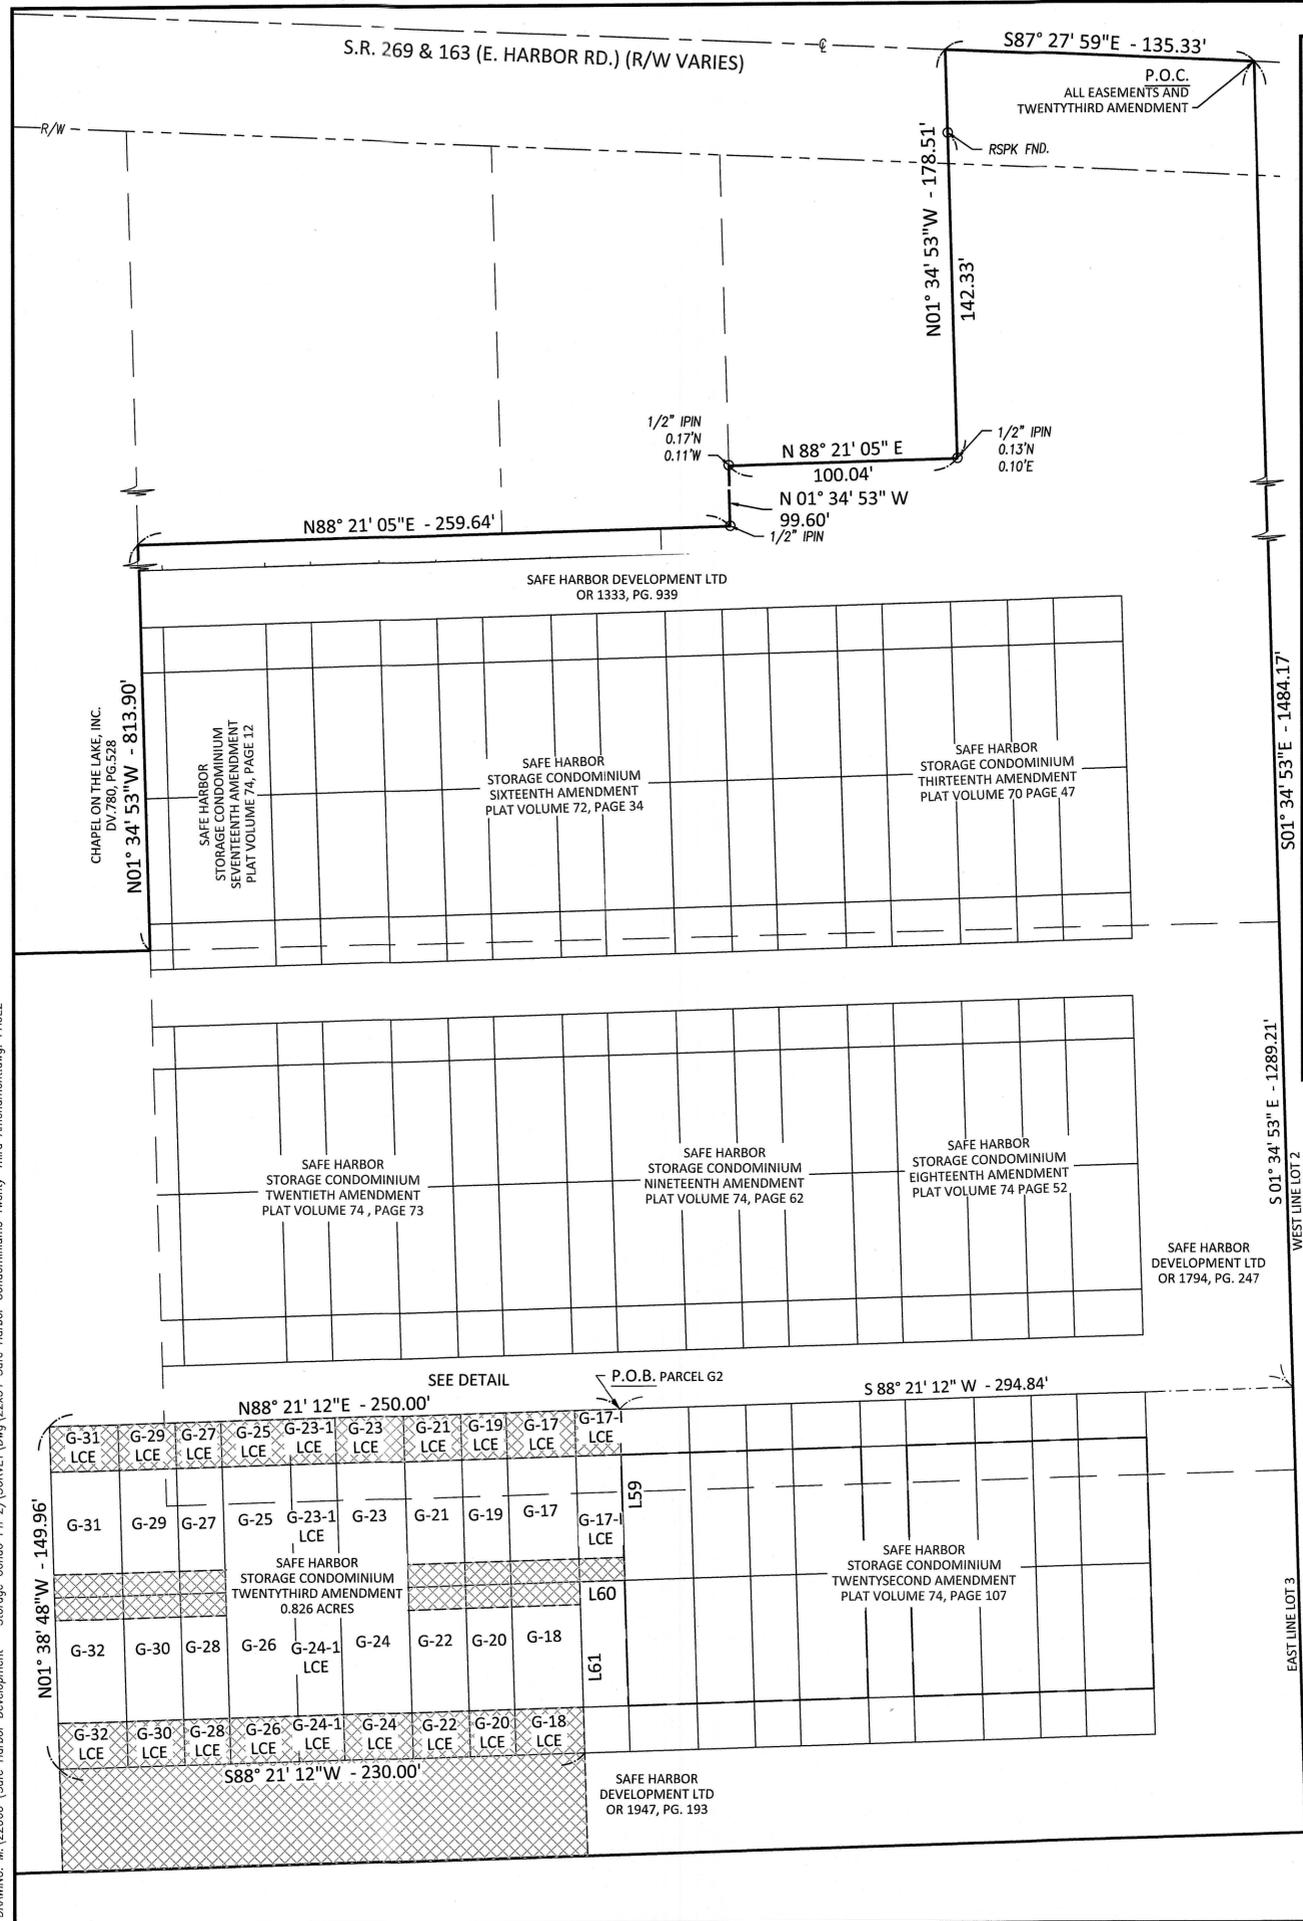

- LEGEND**
- MONUMENT FOUND
 - MONUMENT SET
 - CALCULATED DISTANCE
 - MEASURED DISTANCE
 - (RED) RECORD DISTANCE
 - R/W RIGHT-OF-WAY
 - P.O.B. POINT OF BEGINNING
 - P.O.C. POINT OF COMMENCEMENT
 - UNITS
 - ▨ LIMITED COMMON ELEMENT
 - ▩ EASEMENT

- REFERENCES**
- DEEDS AS SHOWN.
 - SAFE HARBOR STORAGE CONDOMINIUM FIRST AMENDMENT, PLAT VOLUME 62, PAGE 24.
 - SAFE HARBOR STORAGE CONDOMINIUM, PLAT VOLUME 60, PAGE 17.
 - SAFE HARBOR STORAGE CONDOMINIUM THIRD AMENDMENT, PLAT VOLUME 63, PAGE 48.
 - SAFE HARBOR STORAGE CONDOMINIUM FOURTH AMENDMENT, PLAT VOLUME 64, PAGE 29.
 - SAFE HARBOR STORAGE CONDOMINIUM FIFTH AMENDMENT, PLAT VOLUME 65, PAGE 2.
 - SAFE HARBOR STORAGE CONDOMINIUM SIXTH AMENDMENT, PLAT VOLUME 66, PAGE 17.
 - SAFE HARBOR STORAGE CONDOMINIUM SEVENTH AMENDMENT, PLAT VOLUME 67, PAGE 36.
 - SAFE HARBOR STORAGE CONDOMINIUM EIGHTH AMENDMENT, PLAT VOLUME 67, PAGE 50.
 - SAFE HARBOR STORAGE CONDOMINIUM ELEVENTH AMENDMENT, PLAT VOLUME 69, PAGE 13.
 - SAFE HARBOR STORAGE CONDOMINIUM TWELFTH AMENDMENT, PLAT VOLUME 69, PAGE 55.
 - SAFE HARBOR STORAGE CONDOMINIUM THIRTEENTH AMENDMENT, PLAT VOLUME 70, PAGE 47.
 - SAFE HARBOR STORAGE CONDOMINIUM FOURTEENTH AMENDMENT, PLAT VOLUME 71, PAGE 21.
 - SAFE HARBOR STORAGE CONDOMINIUM FIFTEENTH AMENDMENT, DEED BOOK 1833, PAGE 132.
 - SAFE HARBOR STORAGE CONDOMINIUM SIXTEENTH AMENDMENT, PLAT VOLUME 72, PAGE 34.
 - SAFE HARBOR STORAGE CONDOMINIUM SEVENTEENTH AMENDMENT, PLAT VOLUME 74, PAGE 12.
 - SAFE HARBOR STORAGE CONDOMINIUM EIGHTEENTH AMENDMENT, PLAT VOLUME 74, PAGE 52.
 - SAFE HARBOR STORAGE CONDOMINIUM NINETEENTH AMENDMENT, PLAT VOLUME 74, PAGE 62.
 - SAFE HARBOR STORAGE CONDOMINIUM TWENTIETH AMENDMENT, PLAT VOLUME 74, PAGE 73.
 - SAFE HARBOR STORAGE CONDOMINIUM TWENTYSECOND AMENDMENT, PLAT VOLUME 74, PAGE 107.

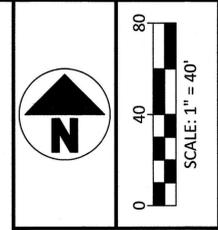

NO	REVISION	DATE
9		
8		
7		
6		
5		
4		
3		
2		
1		

DGL
 CONSULTING ENGINEERS

DGL CONSULTING ENGINEERS, LLC
 3455 BRIARFIELD BLVD, SUITE E
 MAUMEE, OH 43537
 PHONE: 419.535.1015
 www.dgl-td.com

SAFE HARBOR STORAGE CONDOMINIUM TWENTYTHIRD AMENDMENT

LOCATED IN PART OF LOT 03, SECTION 04, DANBURY TOWNSHIP, OTTAWA COUNTY, OHIO.

FILE:	TWENTYTHIRD
JOB NO.:	22060-
DRAWN BY:	GSW/PJS
ISSUED:	07/11/2024