
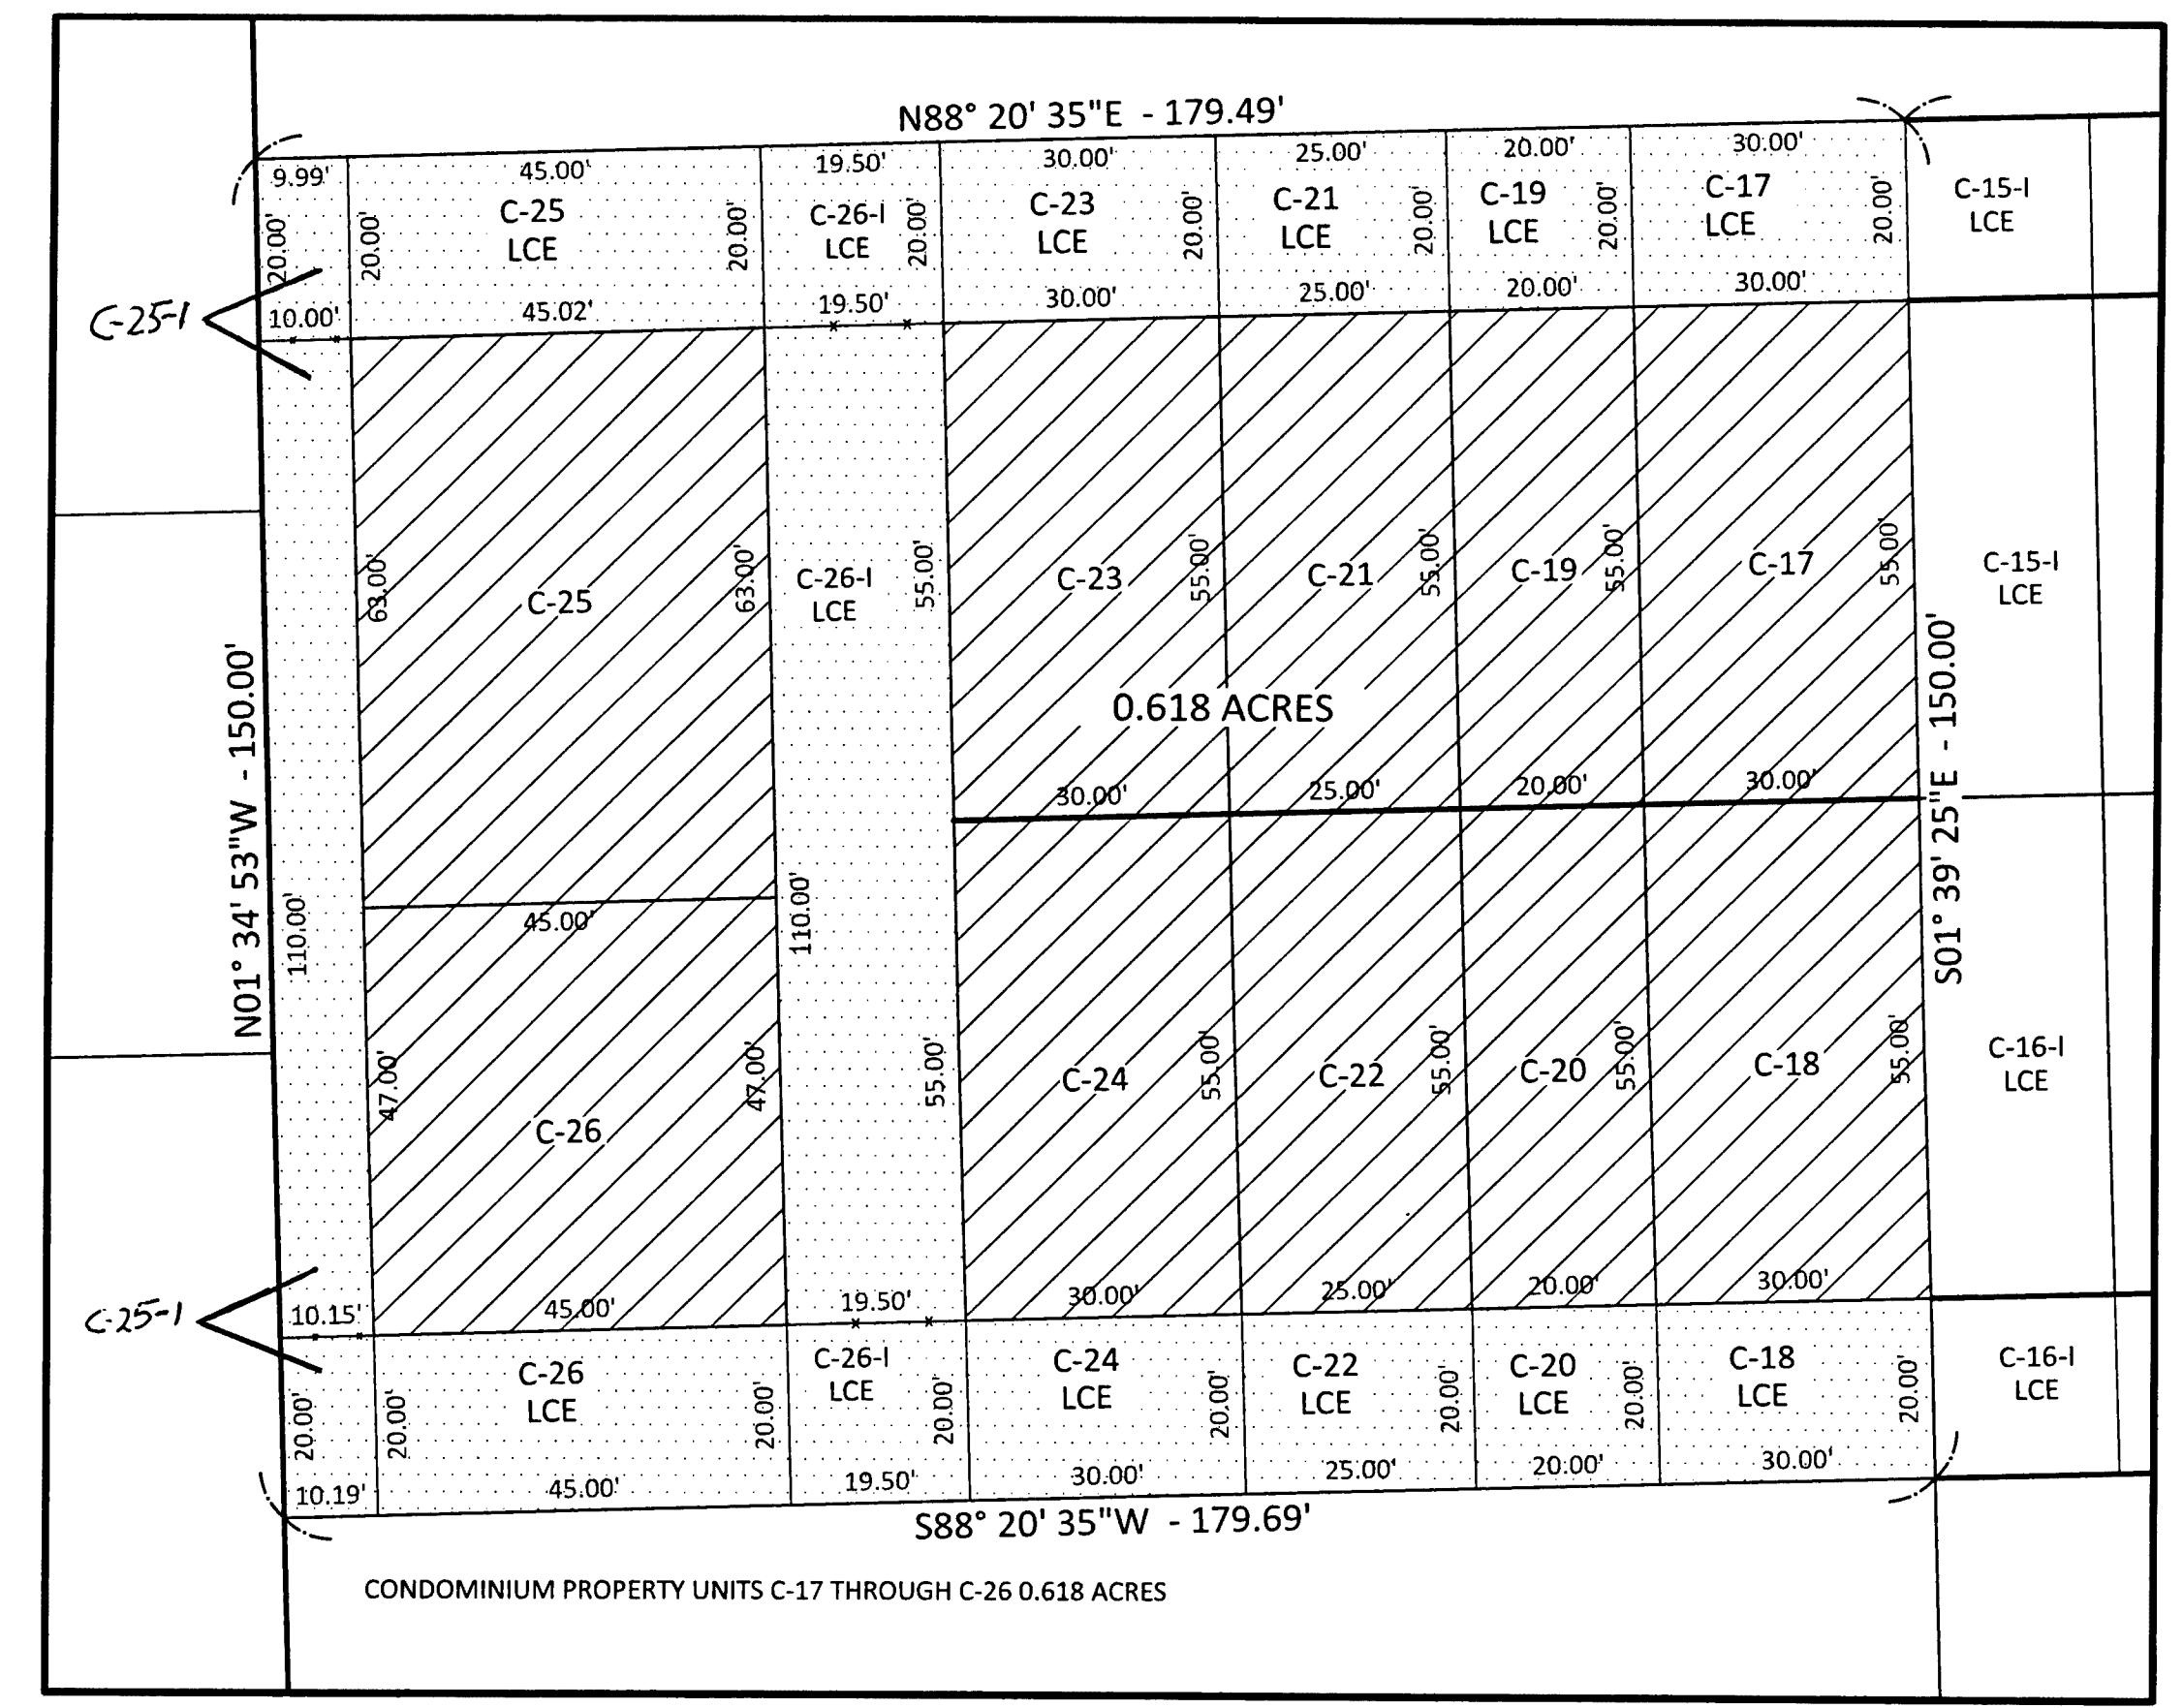


PLOTTED: Jun 19, 2018 - 8:19am
 DRAWING: M:\15080 (Safe Harbor Development) - Safe Harbor Plaza Building Layout\SURVEY\DWG\22x34 Safe Harbor Condominiums SEVENTH Amendment.dwg: PAGE1

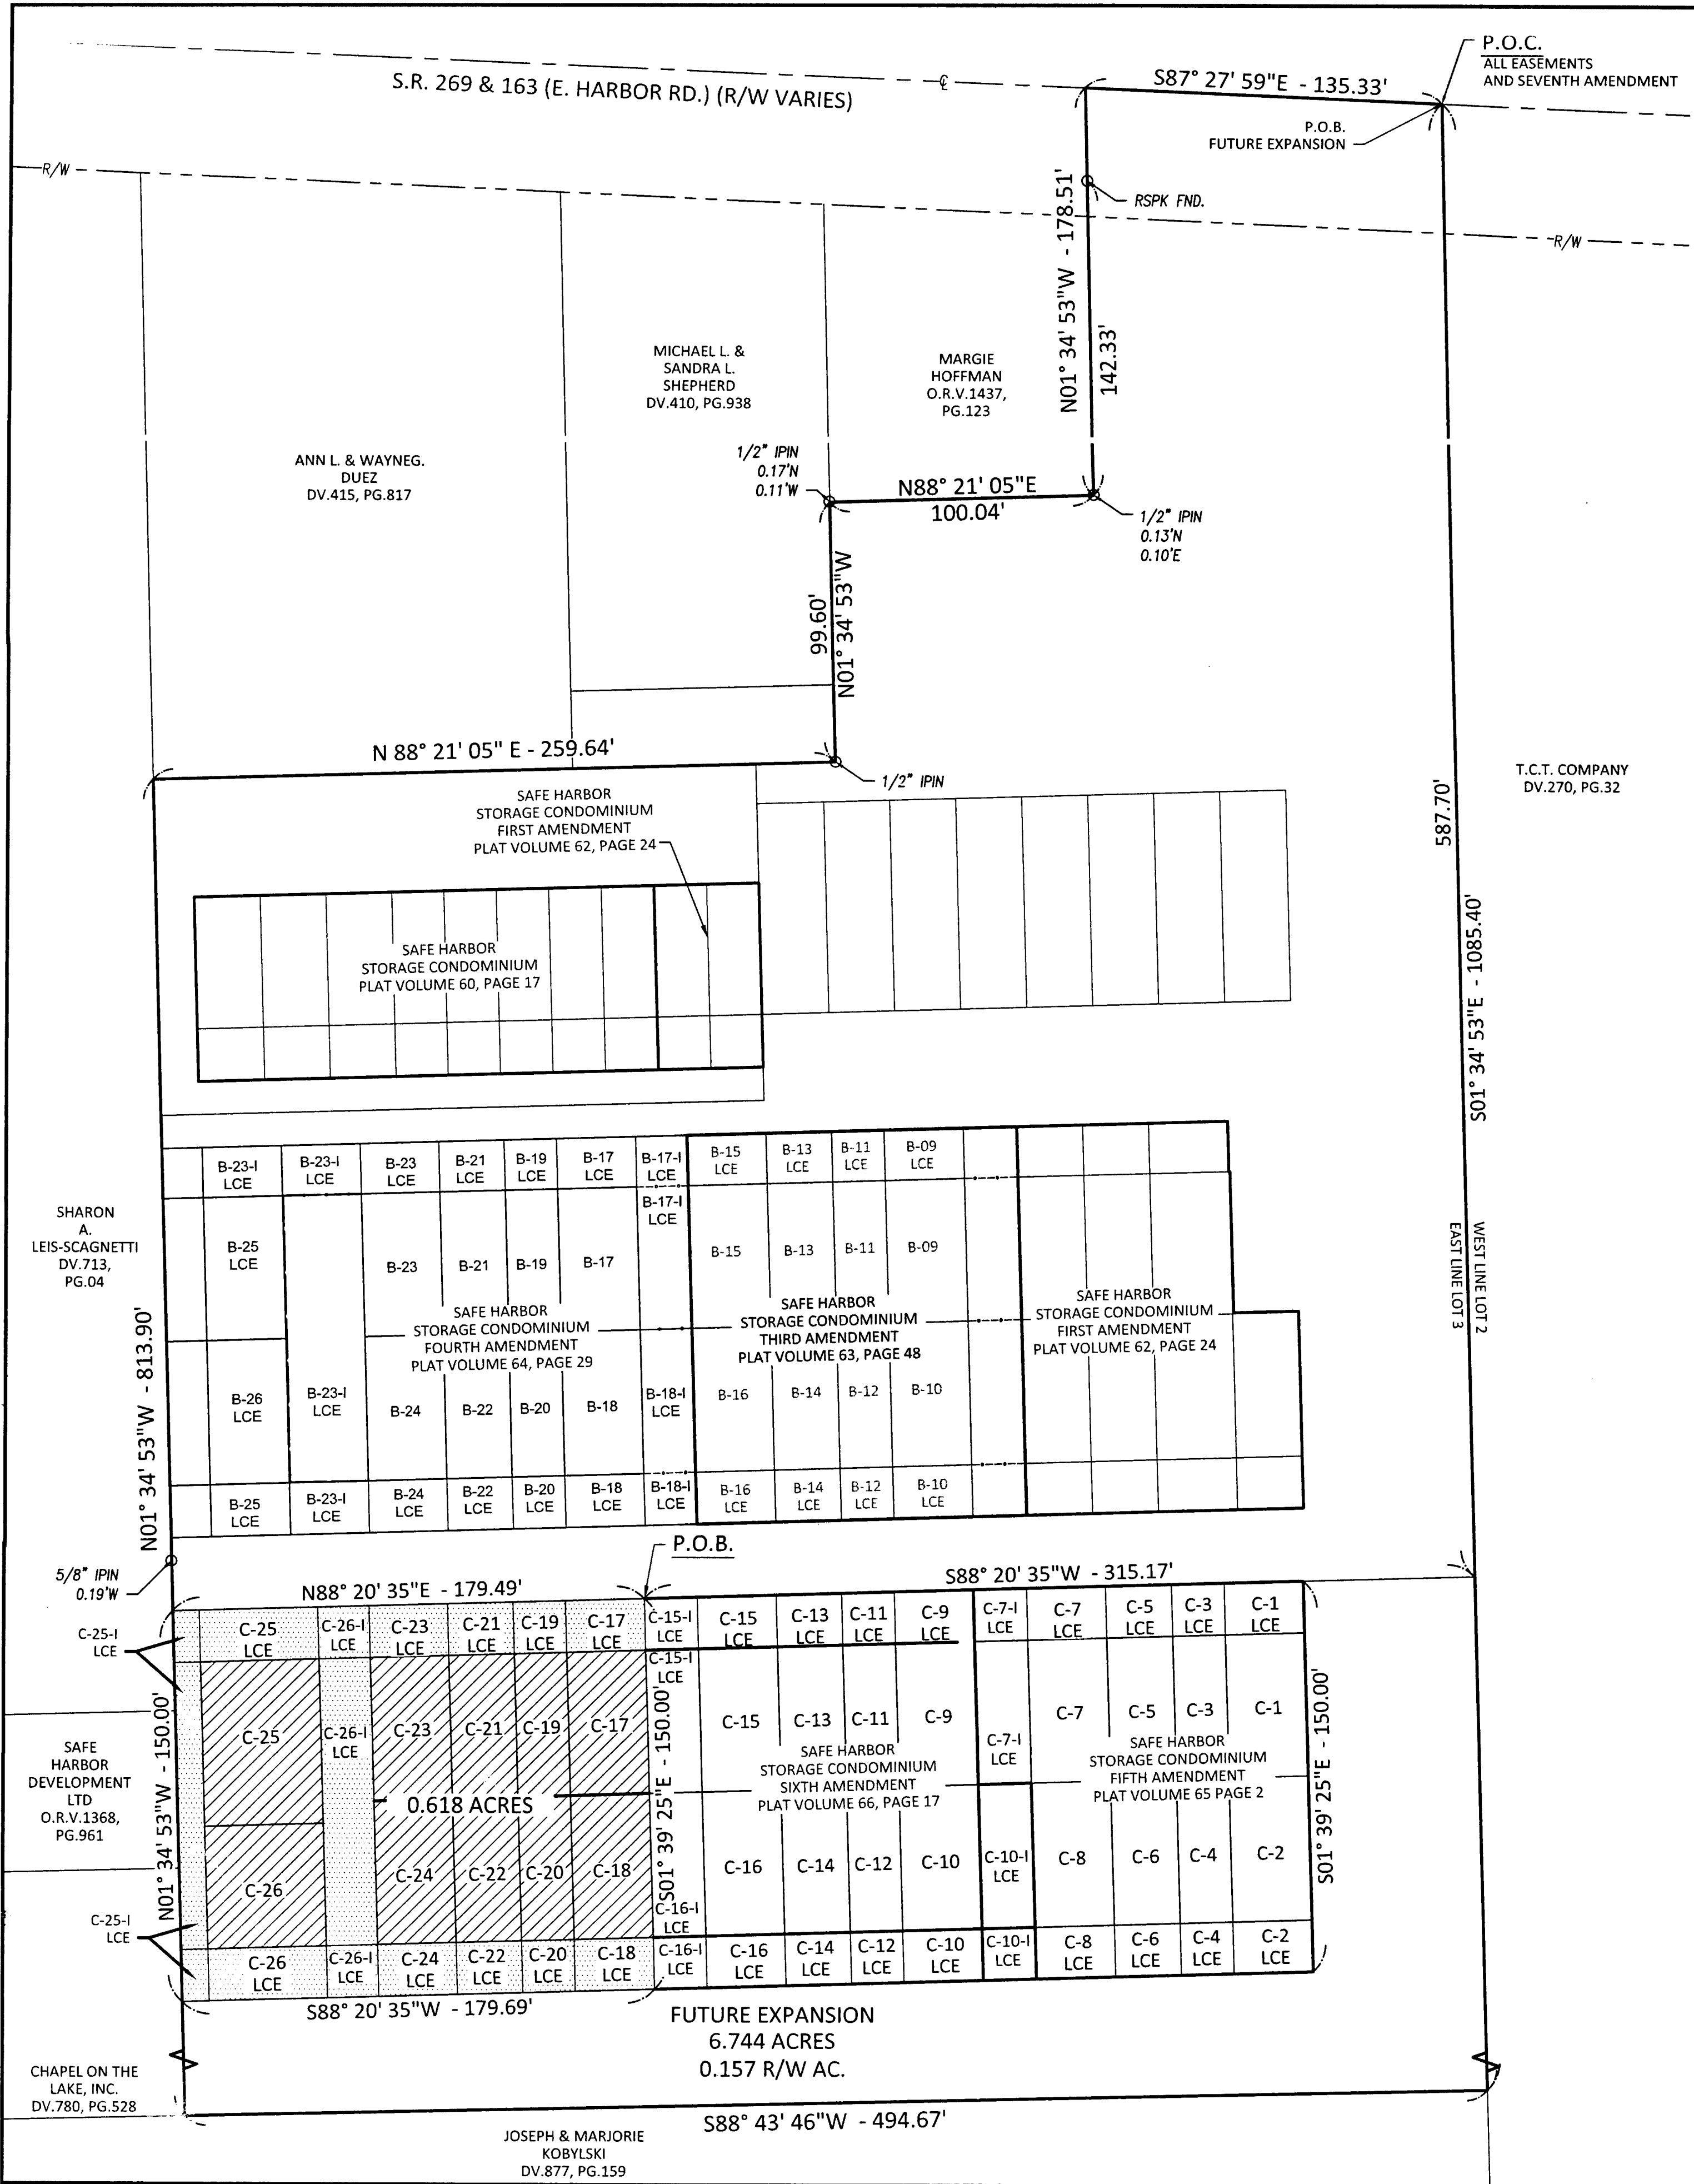


SCALE: 1"=30'

- LEGEND**
- MONUMENT FOUND
 - MONUMENT SET
 - (C) CALCULATED DISTANCE
 - (M) MEASURED DISTANCE
 - (REC) RECORD DISTANCE
 - R/W RIGHT-OF-WAY
 - P.O.B. POINT OF BEGINNING
 - P.O.C. POINT OF COMMENCEMENT
 - ▨ UNITS
 - ▩ LIMITED COMMON ELEMENT
 - FENCE

- REFERENCES**
- DEEDS AS SHOWN.
 - SAFE HARBOR STORAGE CONDOMINIUM FIRST AMENDMENT, PLAT VOLUME 62, PAGE 24.
 - SAFE HARBOR STORAGE CONDOMINIUM, PLAT VOLUME 60, PAGE 17.
 - SAFE HARBOR STORAGE CONDOMINIUM THIRD AMENDMENT, PLAT VOLUME 63, PAGE 48.
 - SAFE HARBOR STORAGE CONDOMINIUM FOURTH AMENDMENT, PLAT VOLUME 64, PAGE 29.
 - SAFE HARBOR STORAGE CONDOMINIUM FIFTH AMENDMENT, PLAT VOLUME 65, PAGE 2.
 - SAFE HARBOR STORAGE CONDOMINIUM SIXTH AMENDMENT, PLAT VOLUME 66, PAGE 17.

Document # 277545, Vol. 67 PGS 36-41
 Date July 5, 2018 Time 10:55a.m.
 Fee \$403.20
Virginia M. Park, Recorder
 Virginia M. Park
 Recorder, Ottawa County Ohio

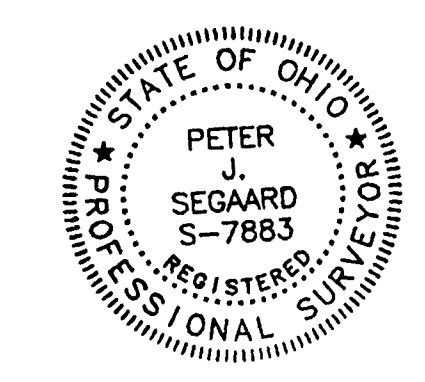

SURVEYOR'S CERTIFICATION:
 I HEREBY DECLARE THAT THE DRAWING ACCURATELY REFLECTS THE LOCATION OF IMPROVEMENTS AND RECORDED EASEMENTS TO THE BEST OF MY KNOWLEDGE AND BELIEF.
Peter J. Segard
 PETER J. SEGARD, P.S.
 OHIO PROFESSIONAL SURVEYOR NO. 7883
 DATE: 6-19-2018

NO	REVISION	DATE
1	REVISED PER OTTAWA COUNTY REVIEW	6/18/18
2		
3		
4		
5		
6		
7		
8		
9		

DGL CONSULTING ENGINEERS, LLC
 3455 BRIARFIELD BLVD., SUITE E
 MAUMEE, OH 43537
 PHONE: 419.535.1015
 www.dgl-td.com



SAFE HARBOR STORAGE CONDOMINIUM SEVENTH AMENDMENT

LOCATED IN PART OF LOT 03, SECTION 04, DANBURY TOWNSHIP, OTTAWA COUNTY, OHIO.

FILE:	SAFE HARBOR
JOB NO.:	15080
DRAWN BY:	PJS
ISSUED:	6/7/2018

1 OF 6

PLOTTED: Jul 02, 2018 - 1:45pm
 DRAWING: W:\15060 (Safe Harbor Development - Safe Harbor Plaza Building Layout)\SURVEY\DWG\22-34 Safe Harbor Condominiums SEVENTH Amendment.dwg PAGE2

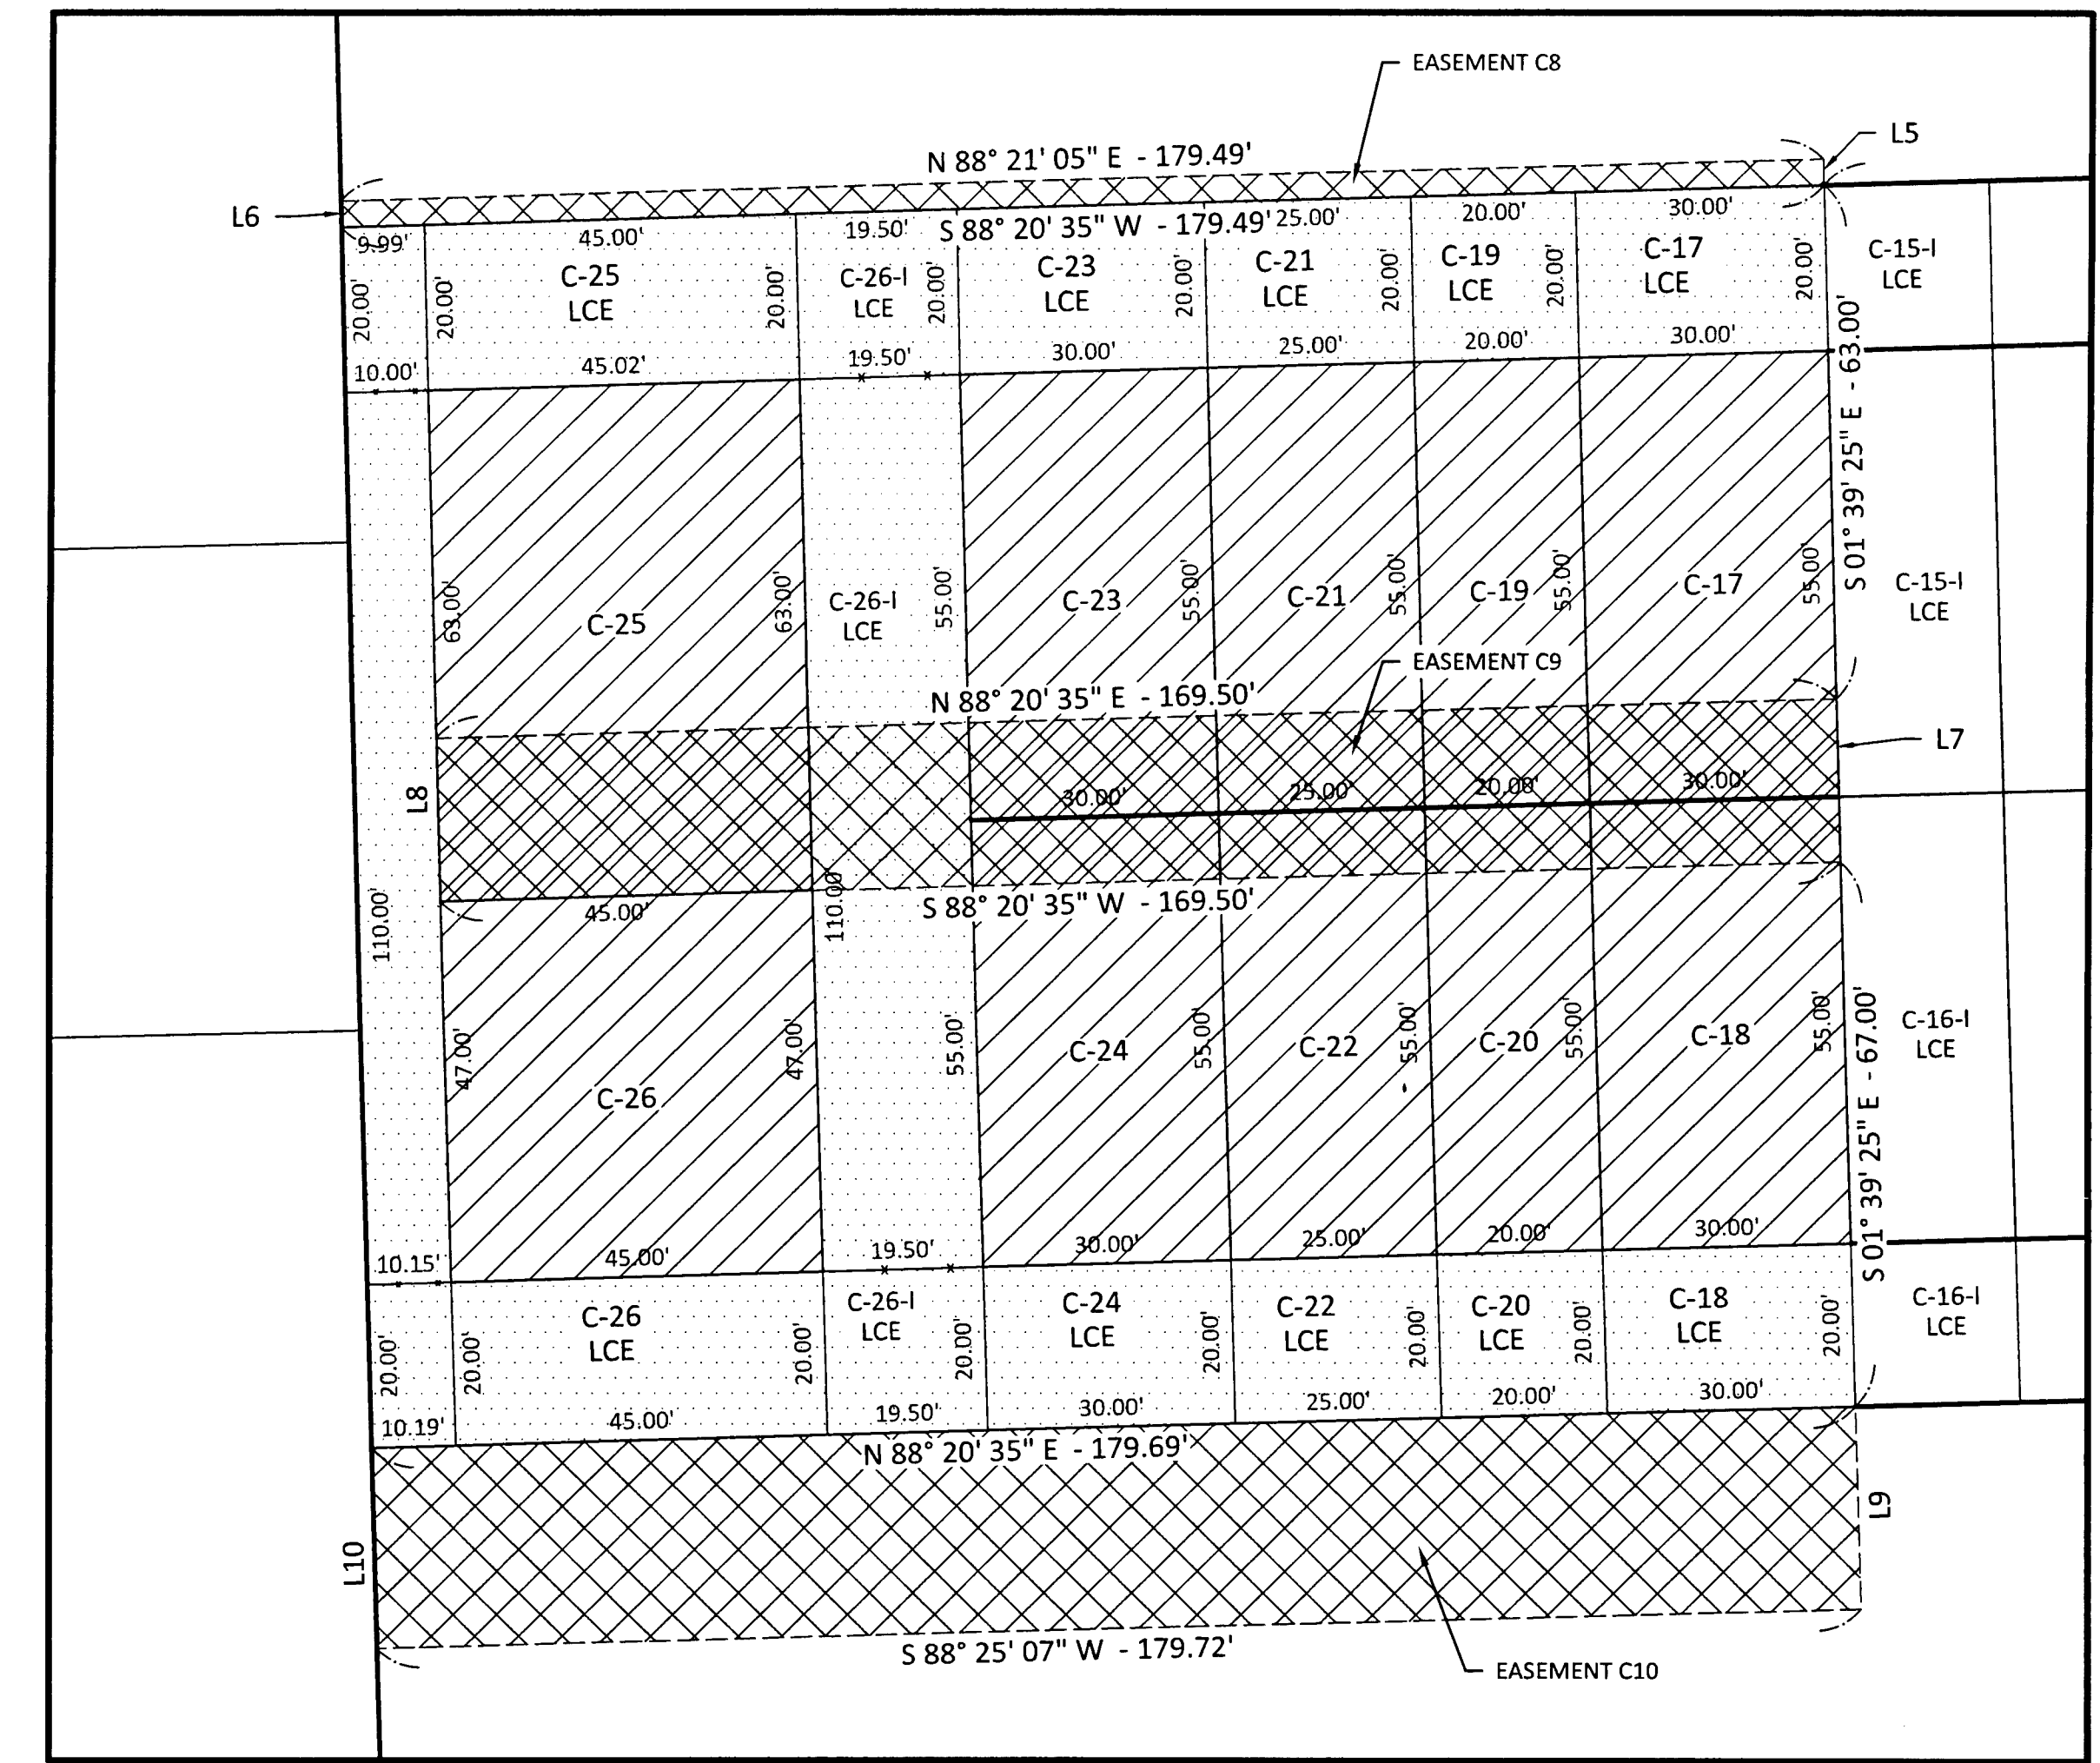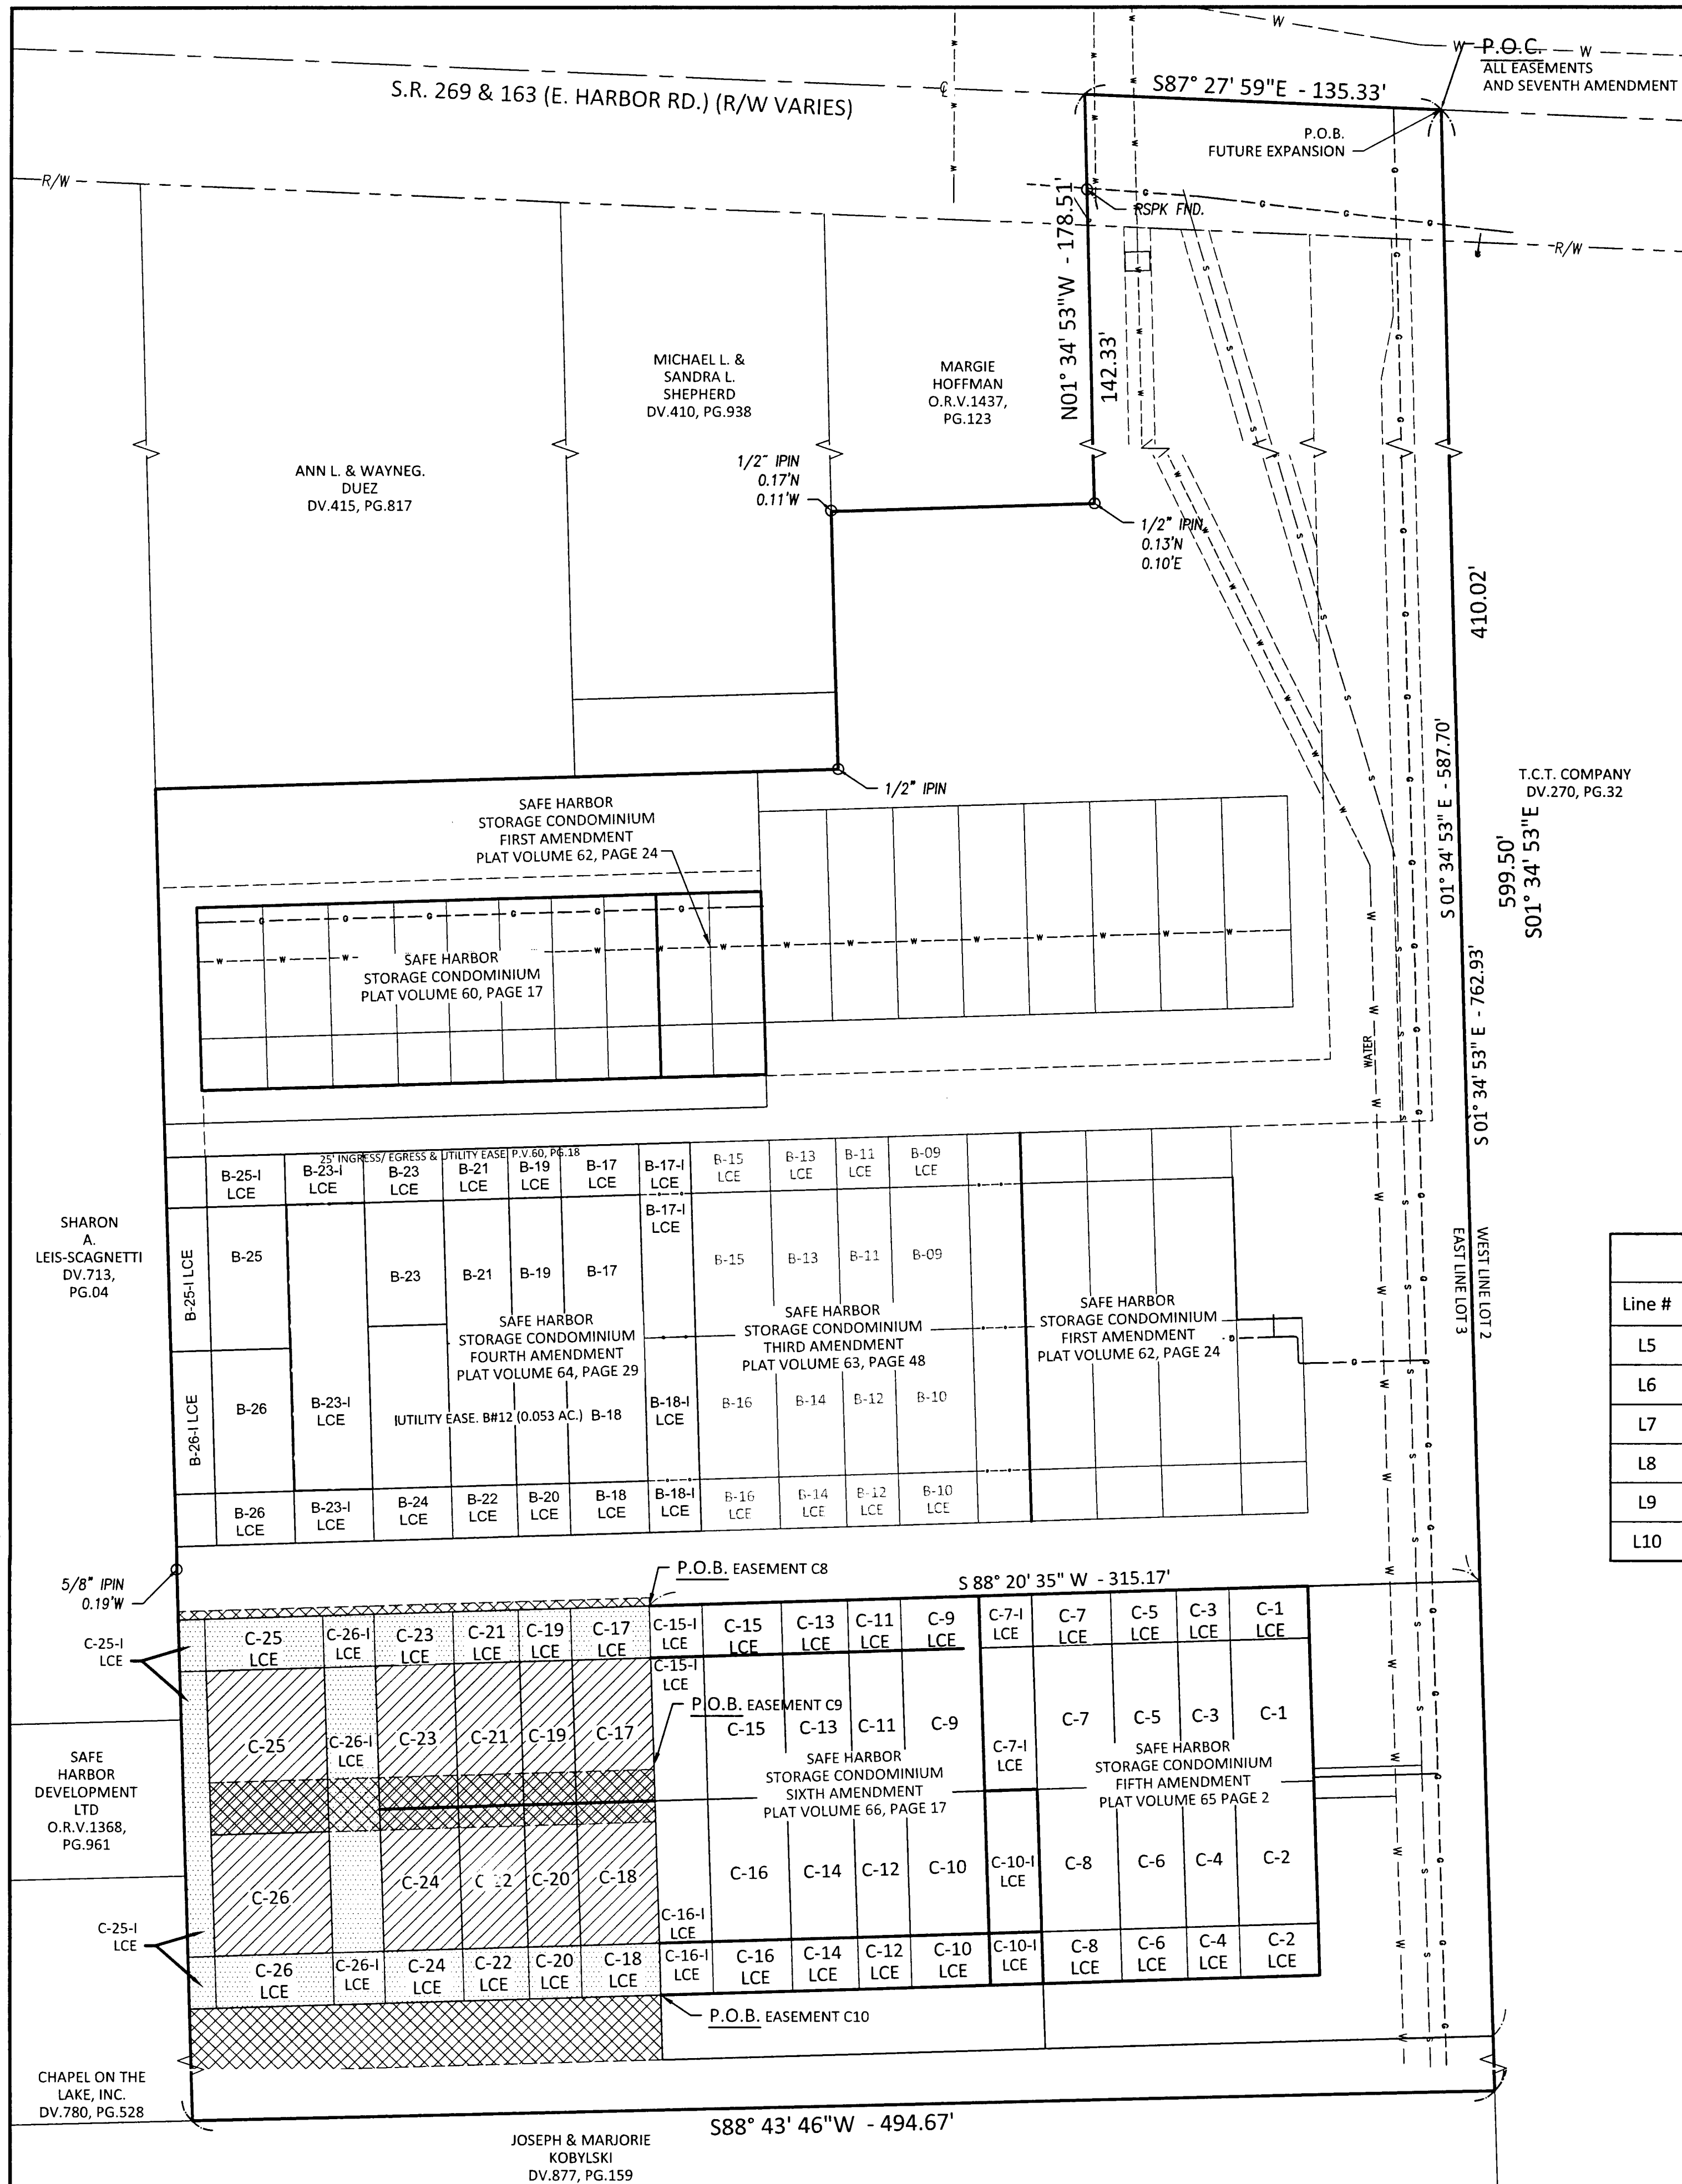


SCALE: 1"=30'


Line #	Direction	Length
L5	S 01° 39' 25" E	3.18'
L6	S 01° 34' 53" E	3.21'
L7	S 01° 39' 25" E	20.00'
L8	N 01° 39' 25" W	20.00'
L9	S 01° 39' 25" E	24.81'
L10	N 01° 34' 53" W	24.57'

- LEGEND**
- MONUMENT FOUND
 - MONUMENT SET
 - (C) CALCULATED DISTANCE
 - (M) MEASURED DISTANCE
 - (REC) RECORD DISTANCE
 - R/W RIGHT-OF-WAY
 - P.O.B. POINT OF BEGINNING
 - P.O.C. POINT OF COMMENCEMENT
 - UNITED COMMON ELEMENT EASEMENT
 - EASEMENT

- REFERENCES**
- DEEDS AS SHOWN.
 - SAFE HARBOR STORAGE CONDOMINIUM FIRST AMENDMENT, PLAT VOLUME 62, PAGE 24.
 - SAFE HARBOR STORAGE CONDOMINIUM, PLAT VOLUME 60, PAGE 17.
 - SAFE HARBOR STORAGE CONDOMINIUM THIRD AMENDMENT, PLAT VOLUME 63, PAGE 48.
 - SAFE HARBOR STORAGE CONDOMINIUM FOURTH AMENDMENT, PLAT VOLUME 64, PAGE 29.
 - SAFE HARBOR STORAGE CONDOMINIUM FIFTH AMENDMENT, PLAT VOLUME 65, PAGE 2.
 - SAFE HARBOR STORAGE CONDOMINIUM SIXTH AMENDMENT, PLAT VOLUME 66, PAGE 17.

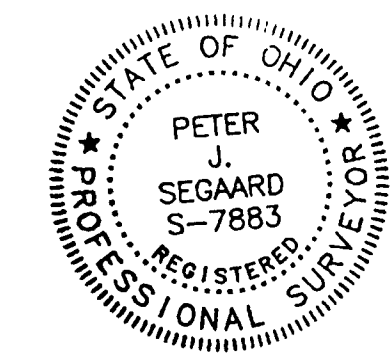

SURVEYOR'S CERTIFICATION:
 I HEREBY DECLARE THAT THE DRAWING ACCURATELY REFLECTS THE LOCATION OF IMPROVEMENTS AND RECORDED EASEMENTS TO THE BEST OF MY KNOWLEDGE AND BELIEF.
 PETER J. SEGGAARD, P.S.
 OHIO PROFESSIONAL SURVEYOR NO. 7883
 DATE: 6/19/2018

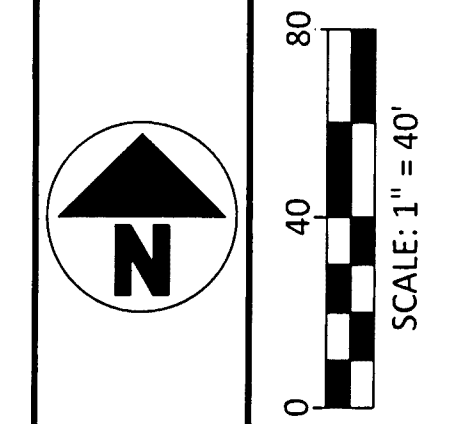


NO	REVISION	DATE
9		
8		
7		
6		
5		
4		
3		
2		
1	XXX	




SAFE HARBOR STORAGE CONDOMINIUM SEVENTH AMENDMENT
 LOCATED IN PART OF LOT 03, SECTION 04, DANBURY TOWNSHIP, OTTAWA COUNTY, OHIO.


FILE:	SAFE HARBOR
JOB NO.:	15080
DRAWN BY:	PJS
ISSUED:	6/6/2018

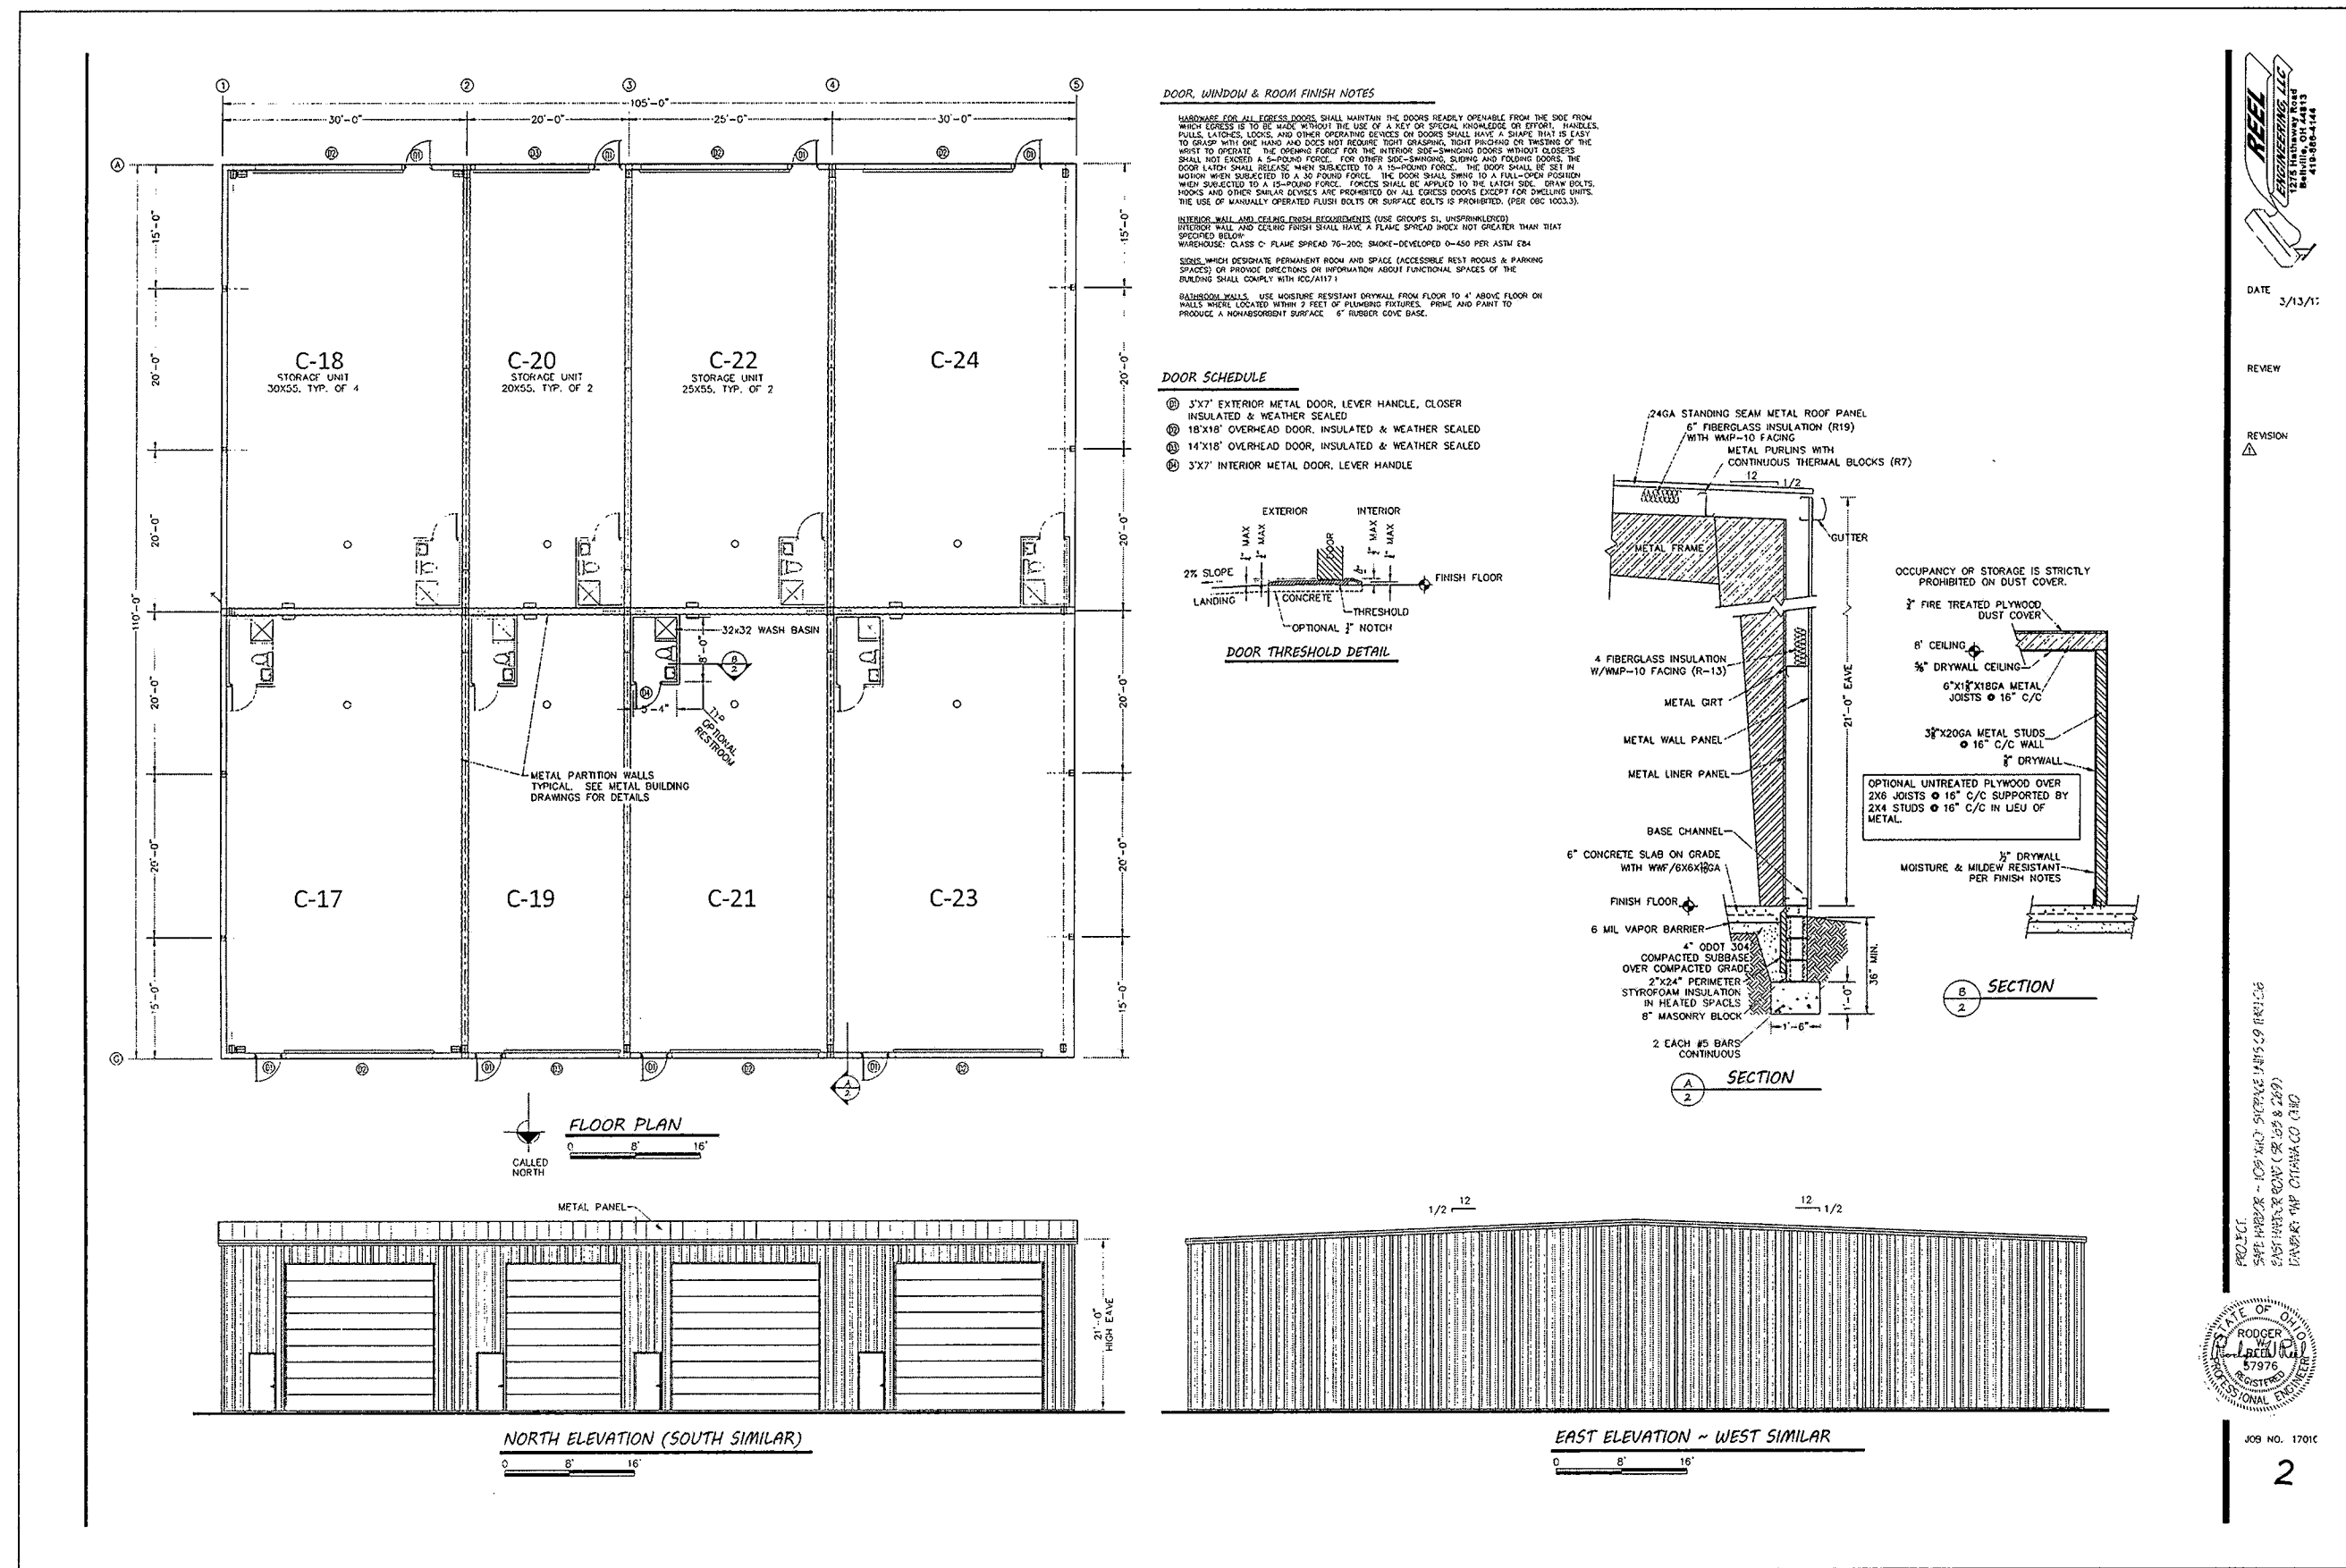

DATE: 3/13/17
 REVIEW:
 REVISION:
 2

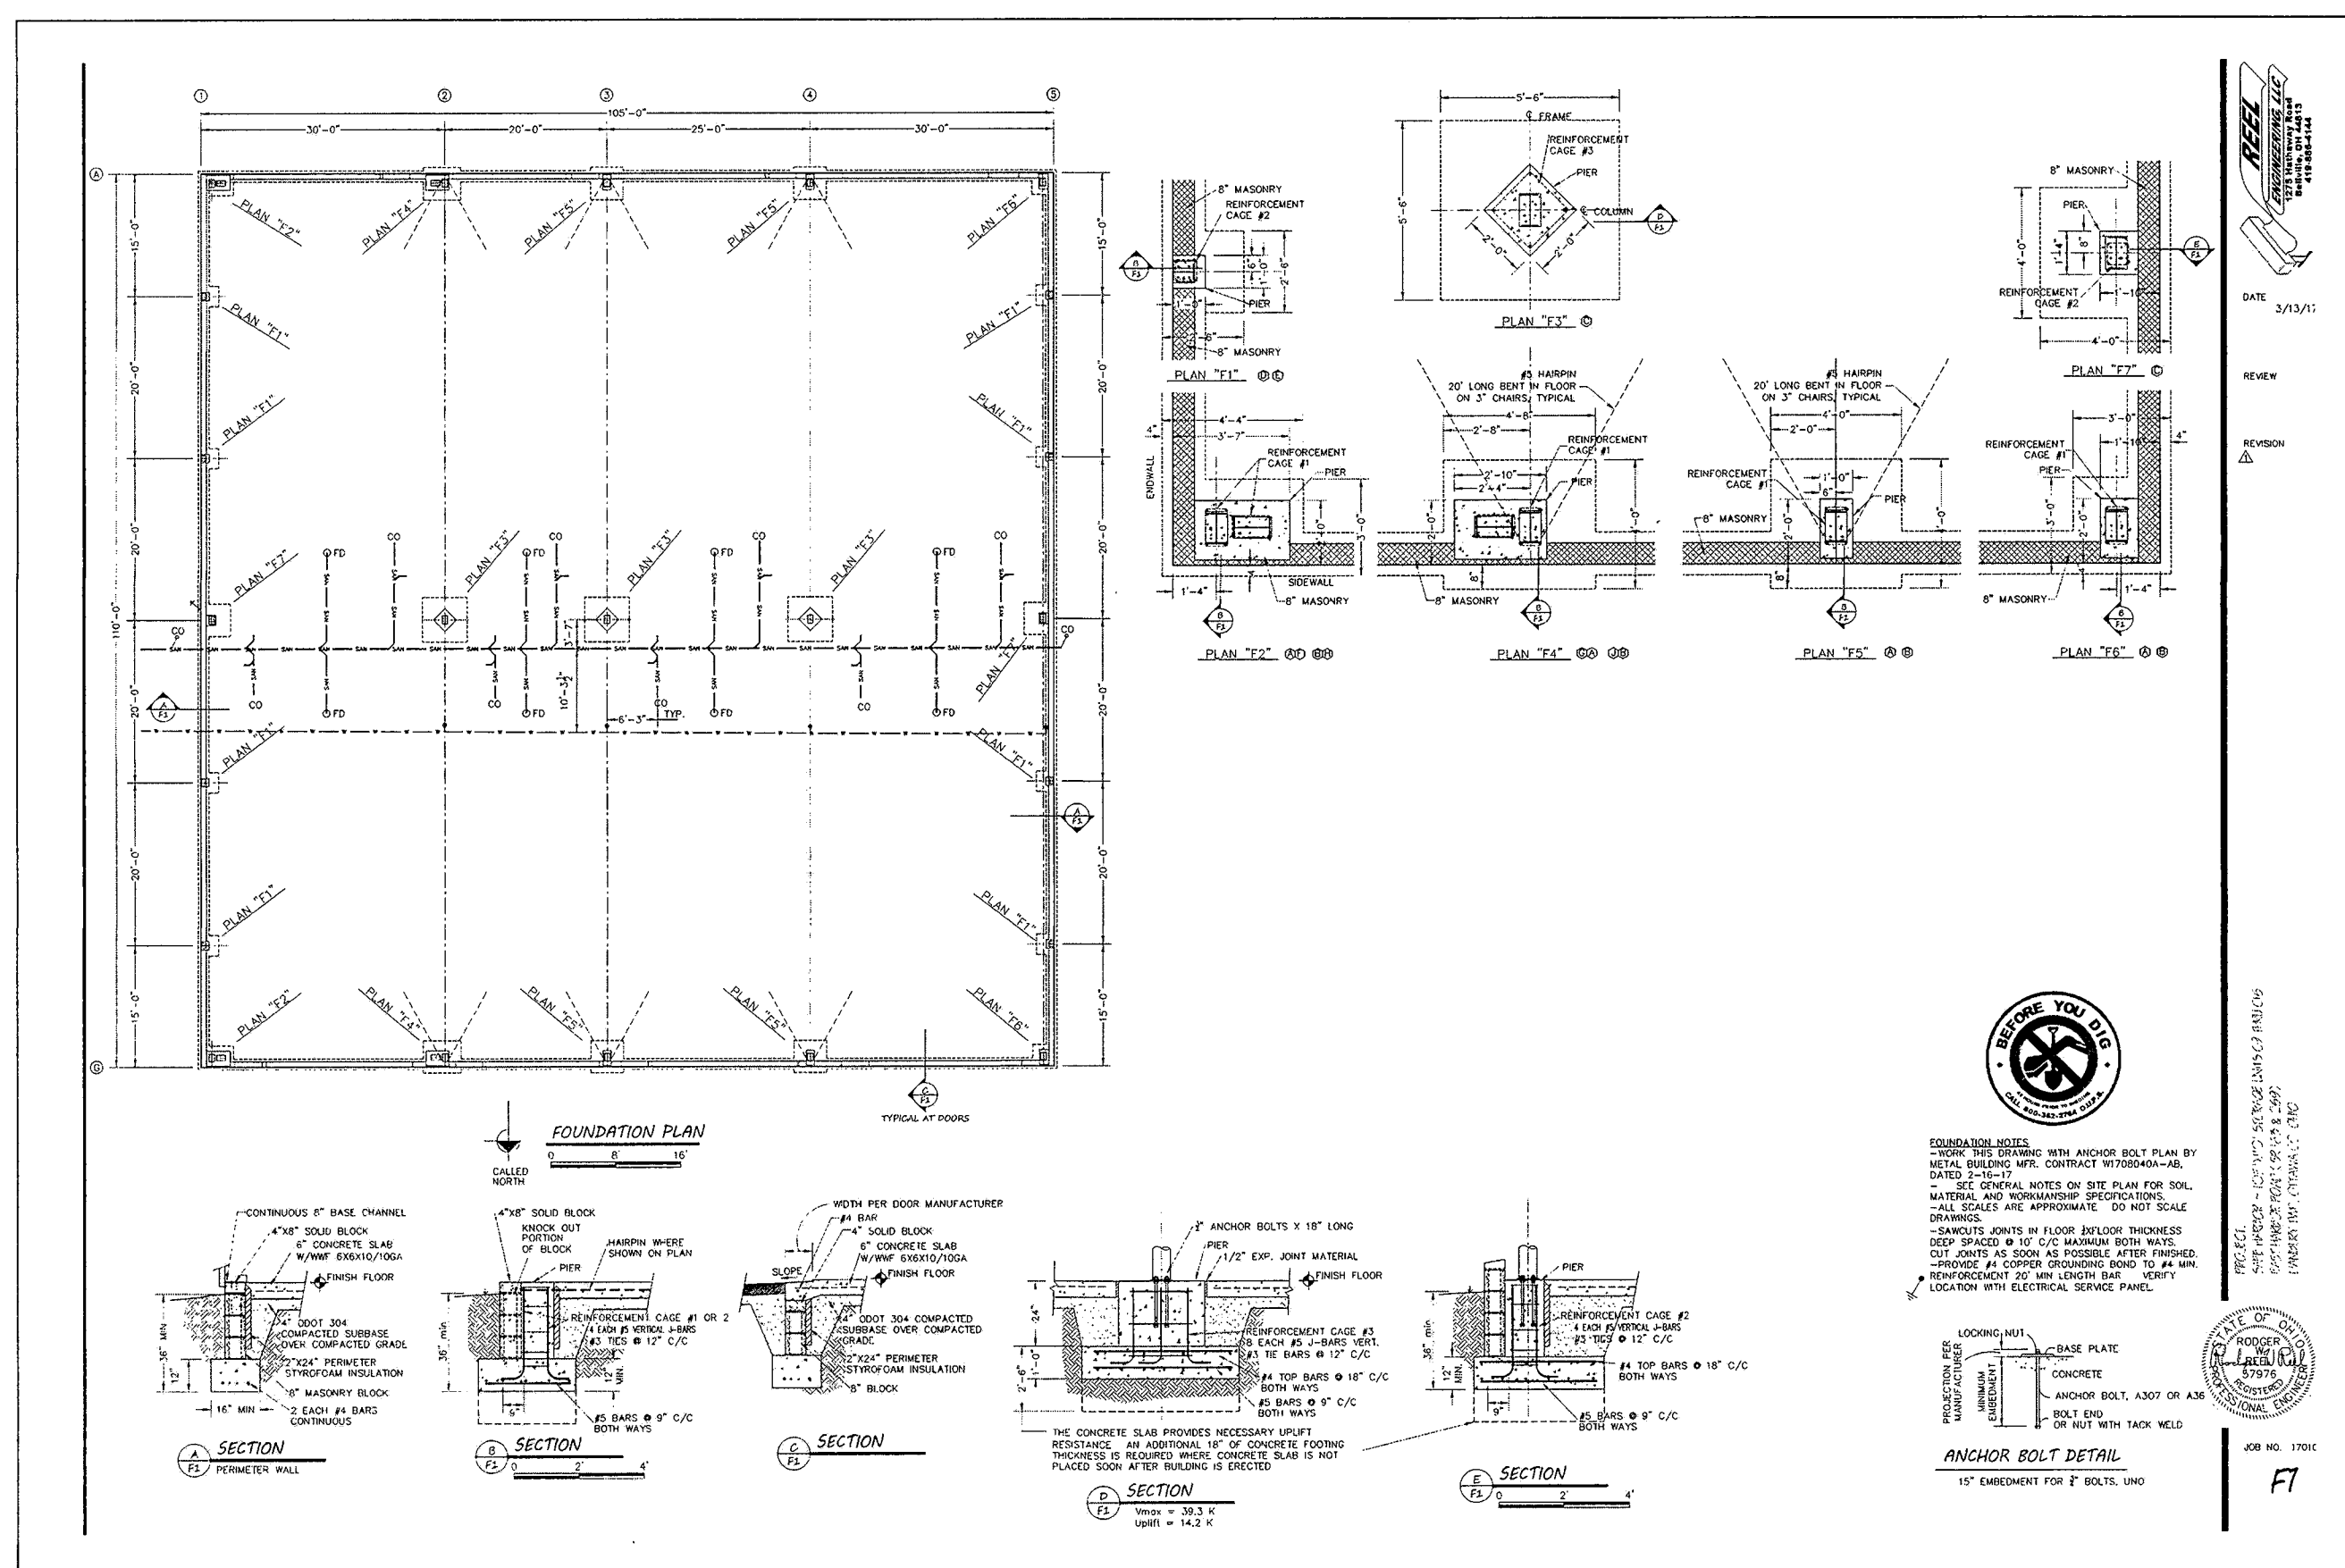


DATE: 3/13/17
 REVIEW:
 REVISION:
 F1

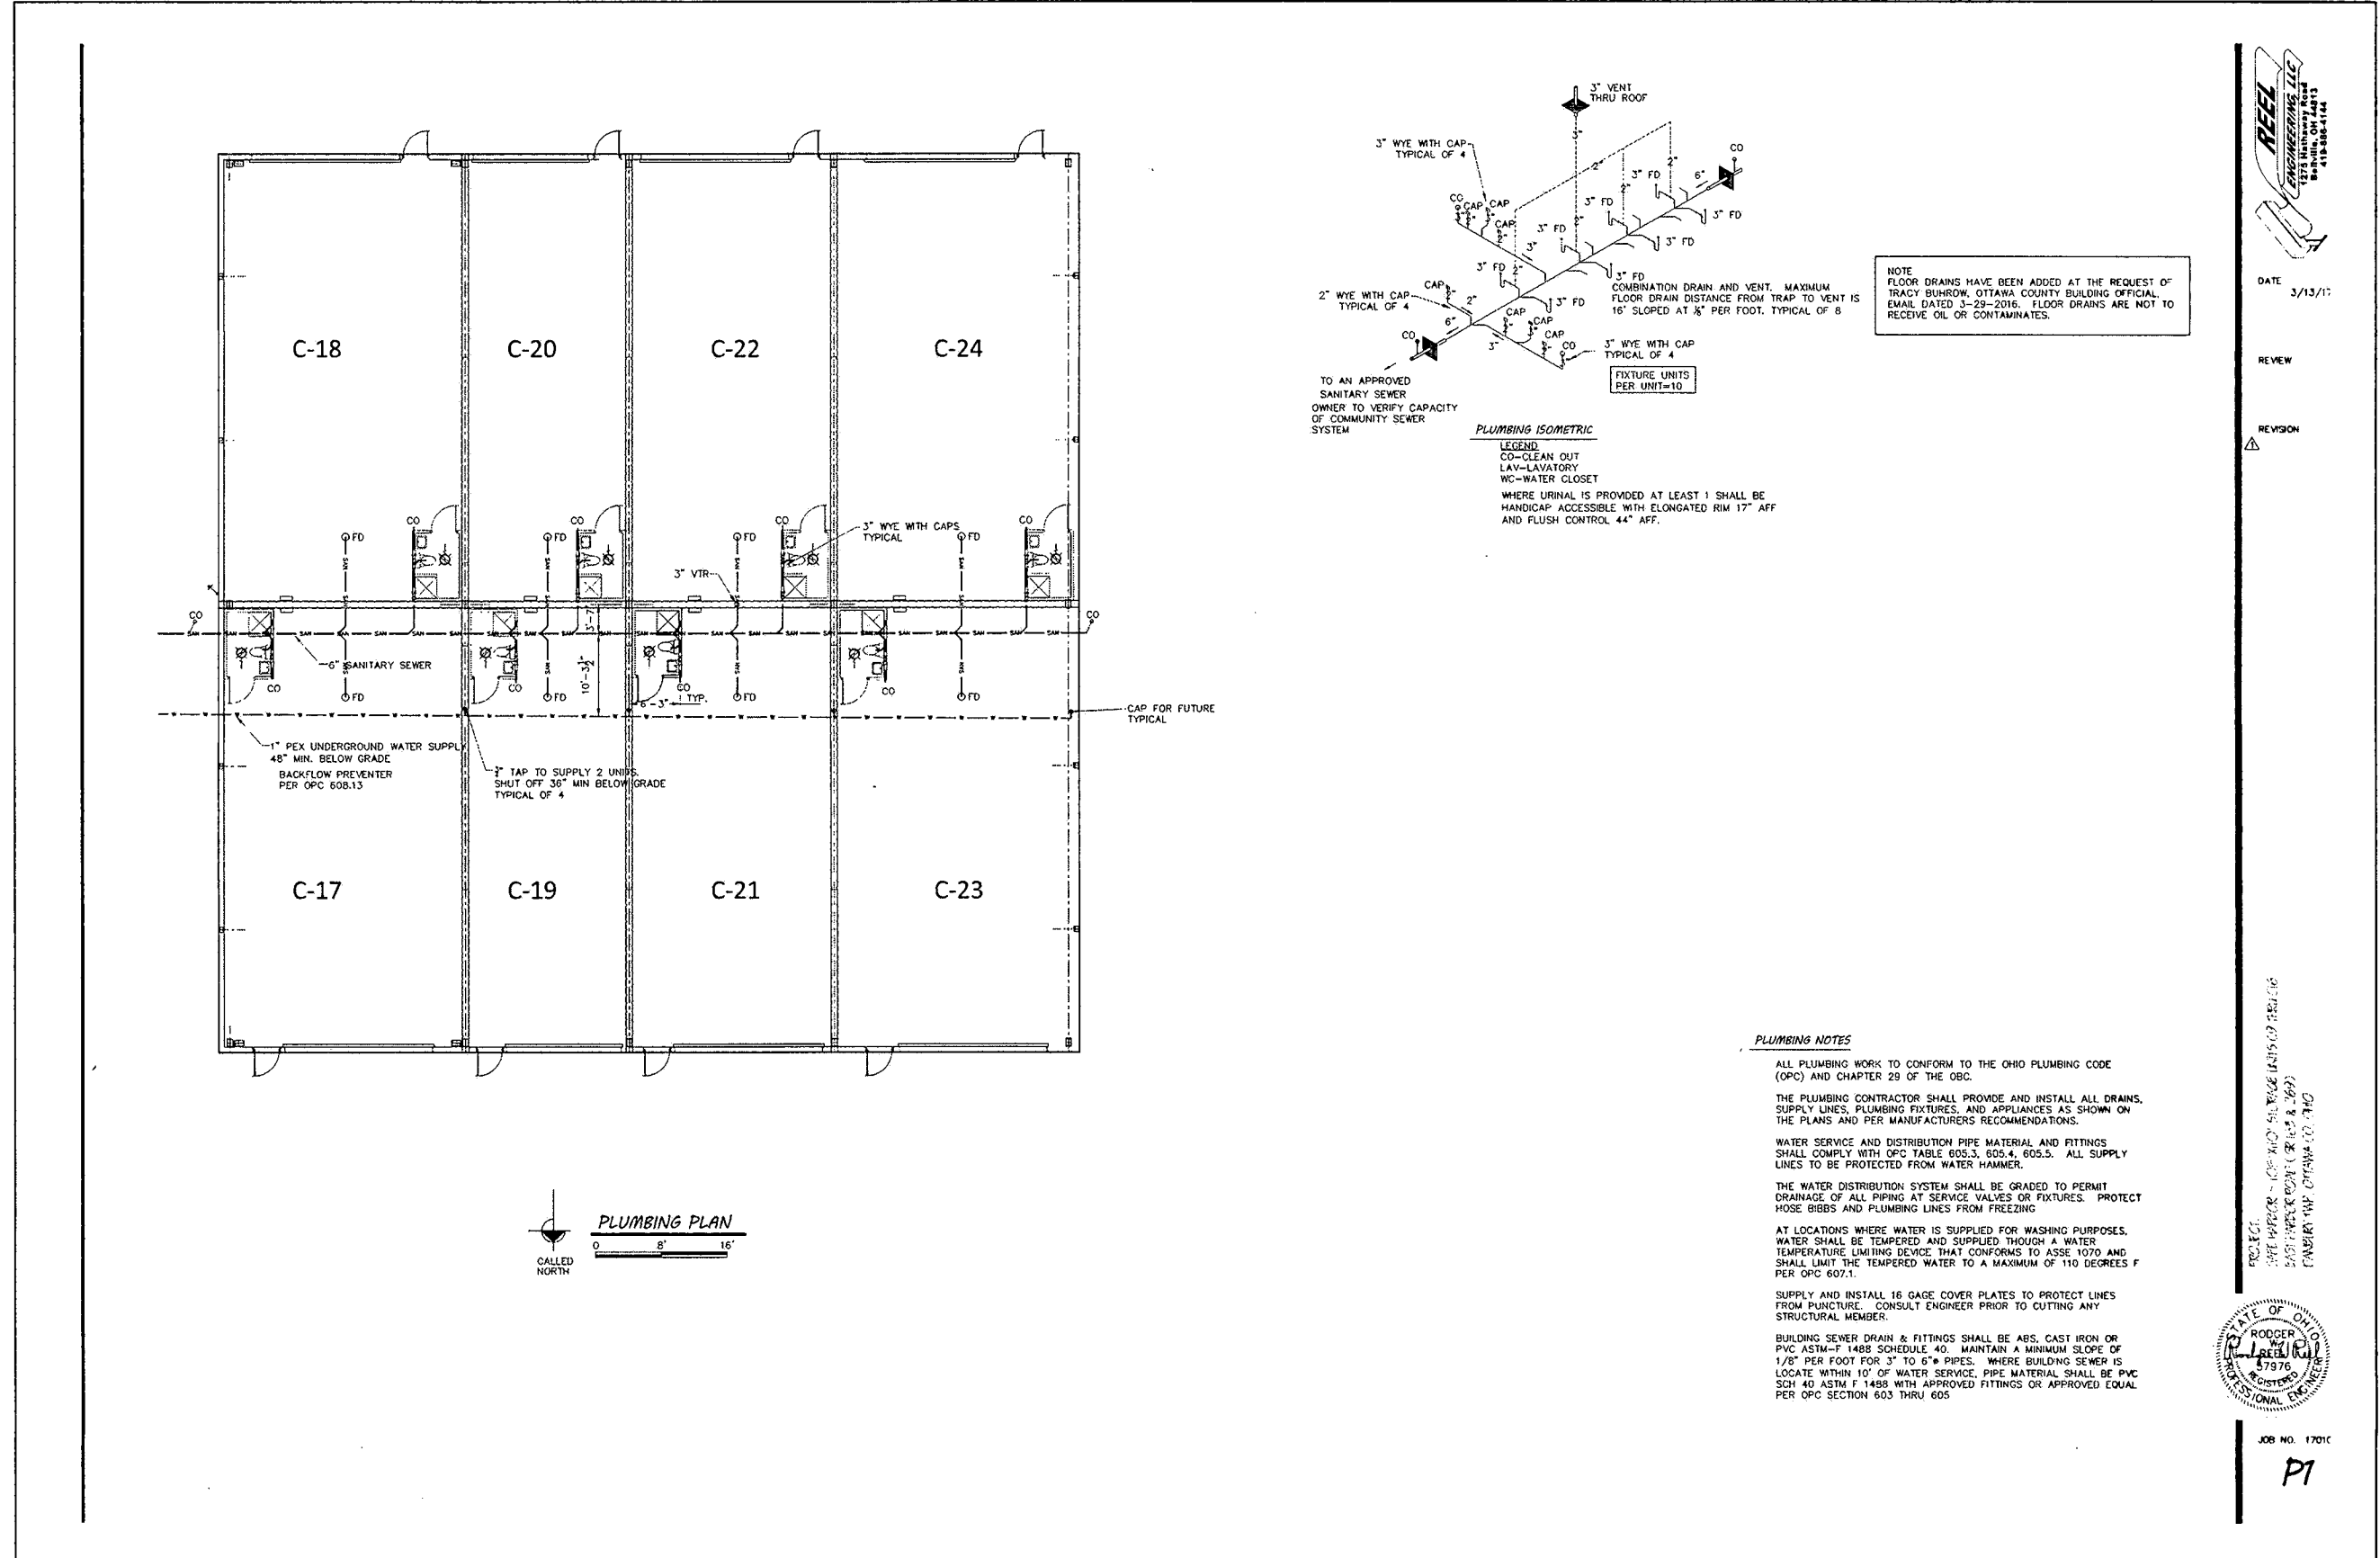

DATE: 3/13/17
 REVIEW:
 REVISION:
 P1

PLOTTED: Jun 19, 2018 - 8:25am
 DRAWING: M:\15080 (Safe Harbor Building Layout)\SURVEY\DWG\22-24 Safe Harbor Condominiums SEVENTH Amendment.dwg: PAGE 3

SAFE HARBOR STORAGE CONDOMINIUM SEVENTH AMENDMENT
 LOCATED IN PART OF LOT 03, SECTION 04, DANBURY TOWNSHIP, OTTAWA COUNTY, OHIO.

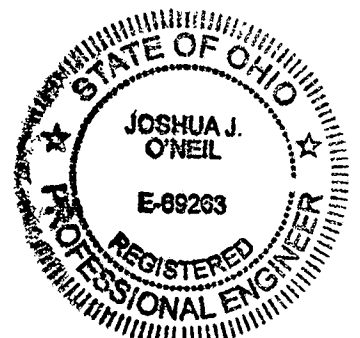

ENGINEER'S CERTIFICATION:
 I HEREBY DECLARE THAT THE DRAWING ACCURATELY SHOWS EACH BUILDING AS BUILT TO THE BEST OF MY KNOWLEDGE AND BELIEF.

Joshua J. O'Neil
 JOSHUA J. O'NEIL, P.E.
 OHIO PROFESSIONAL ENGINEER NO. 69263

6-19-2018
 DATE

