
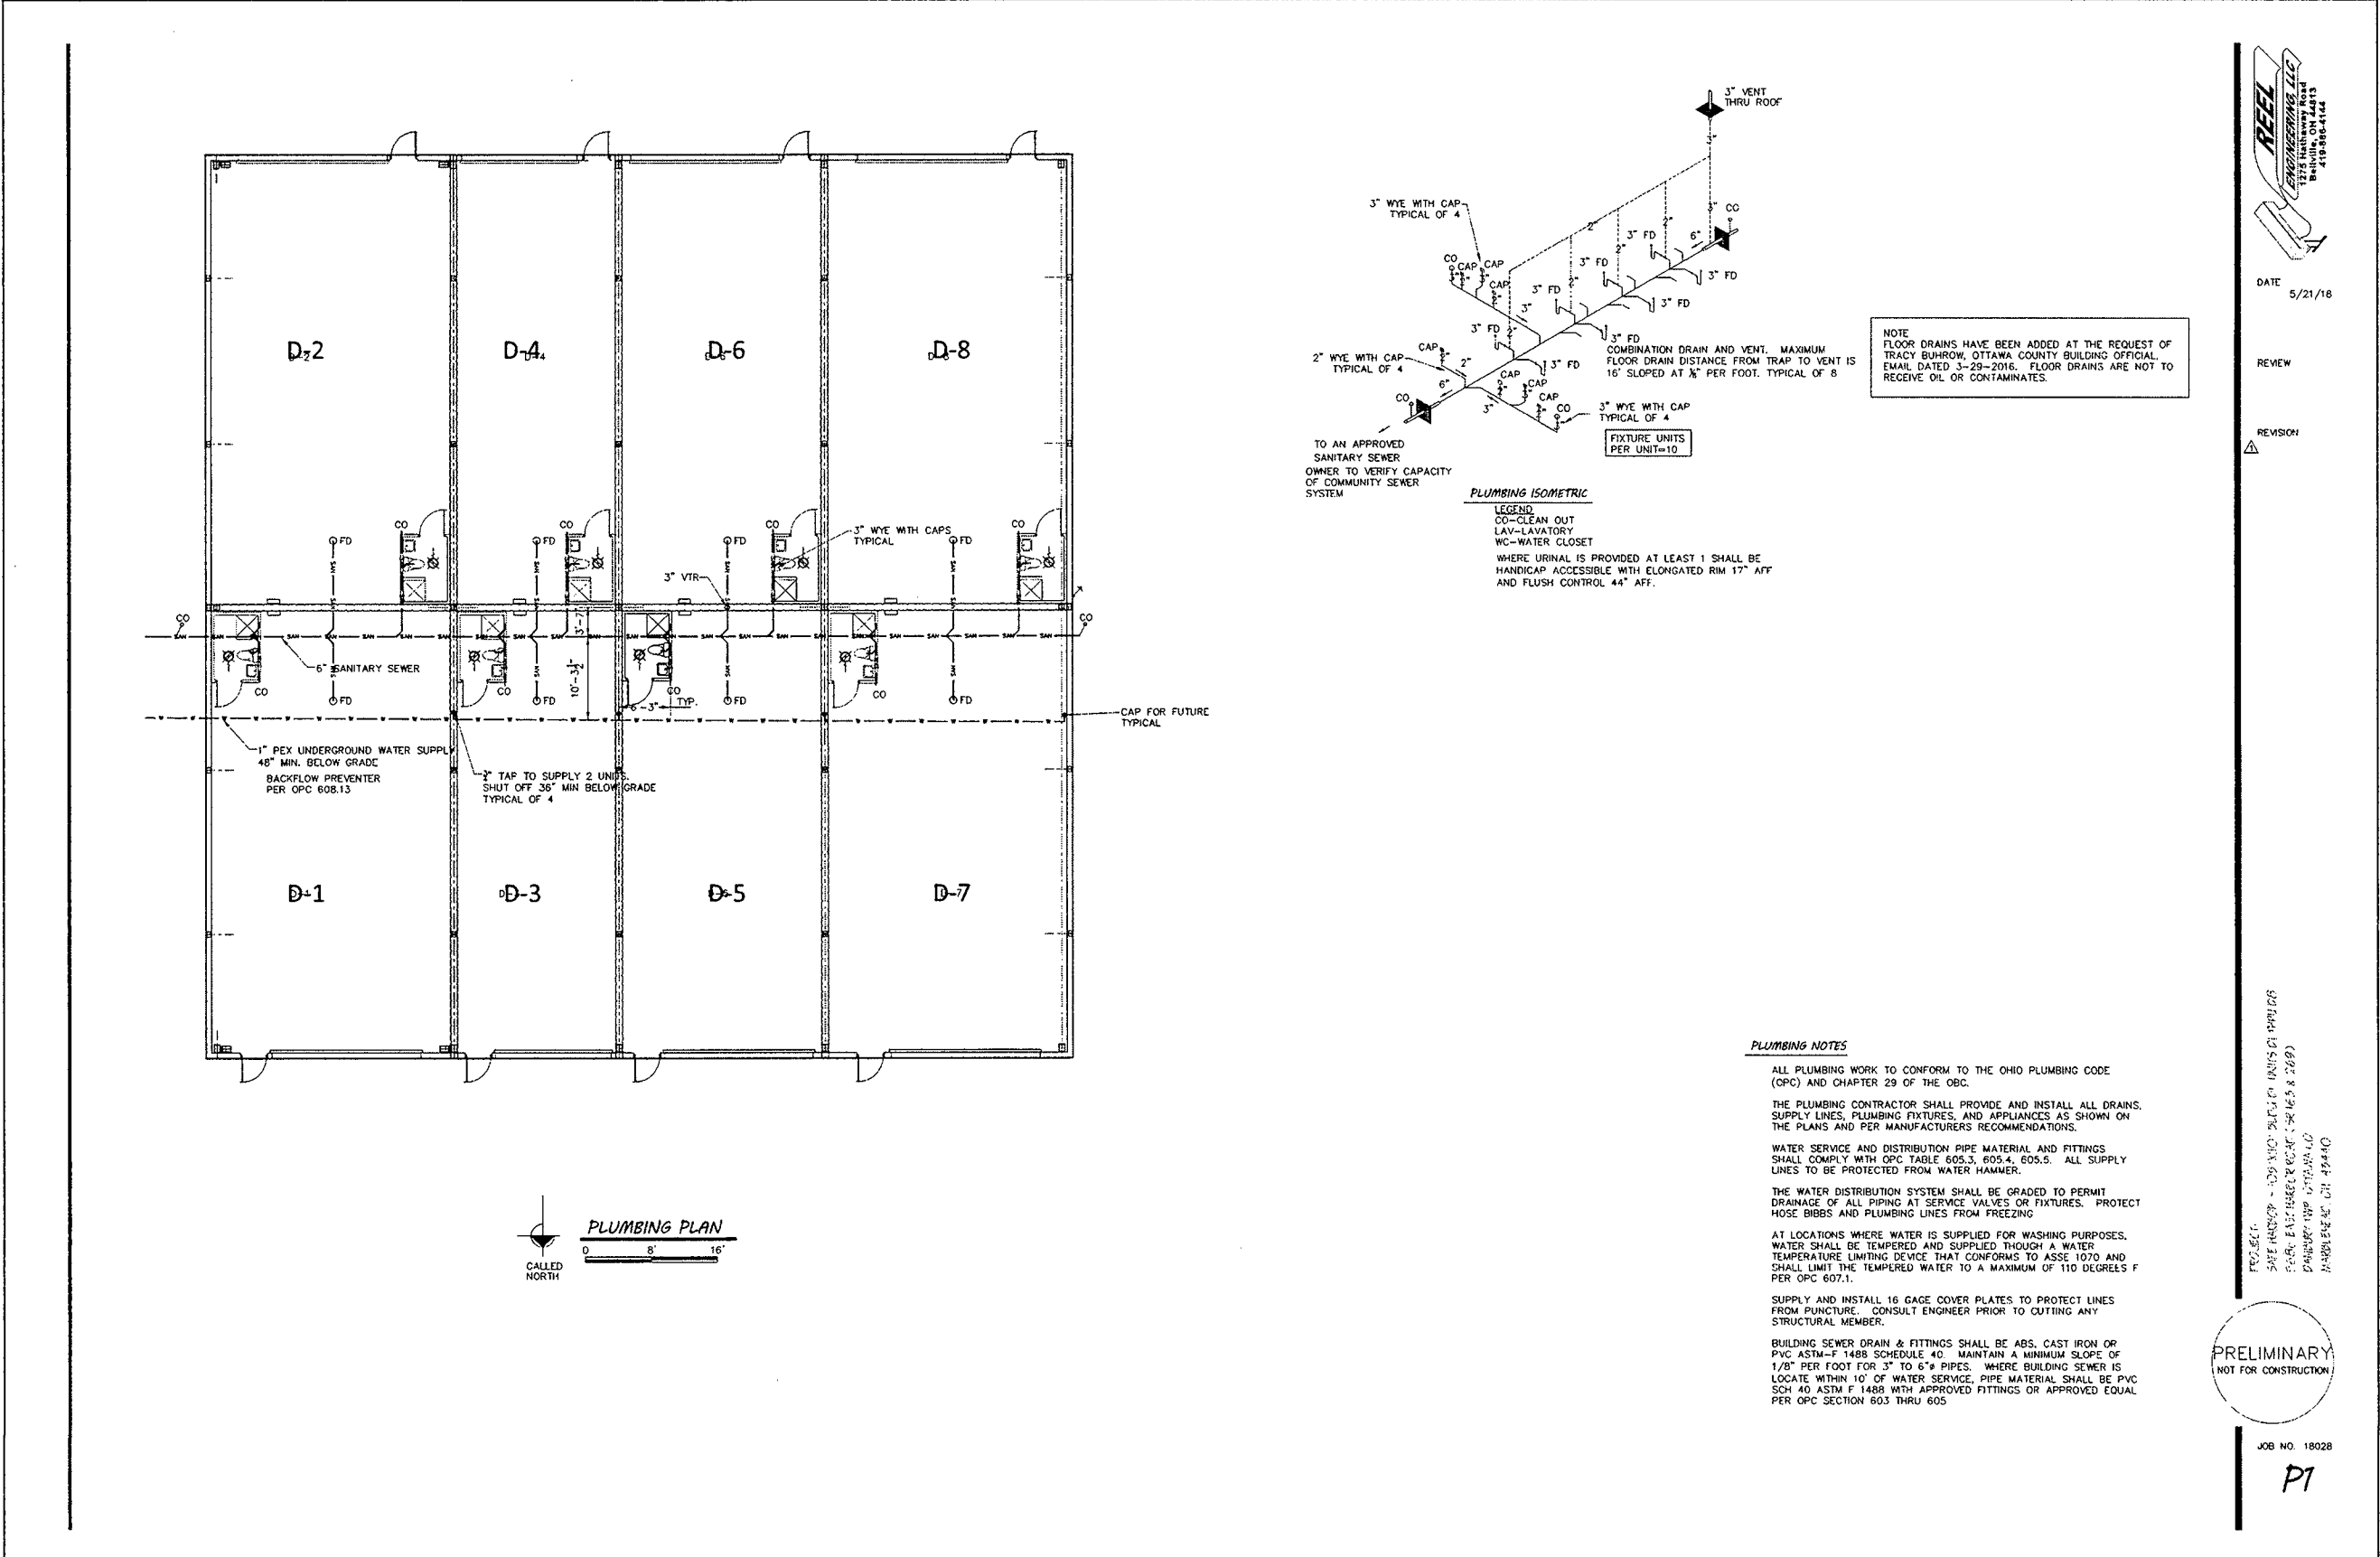
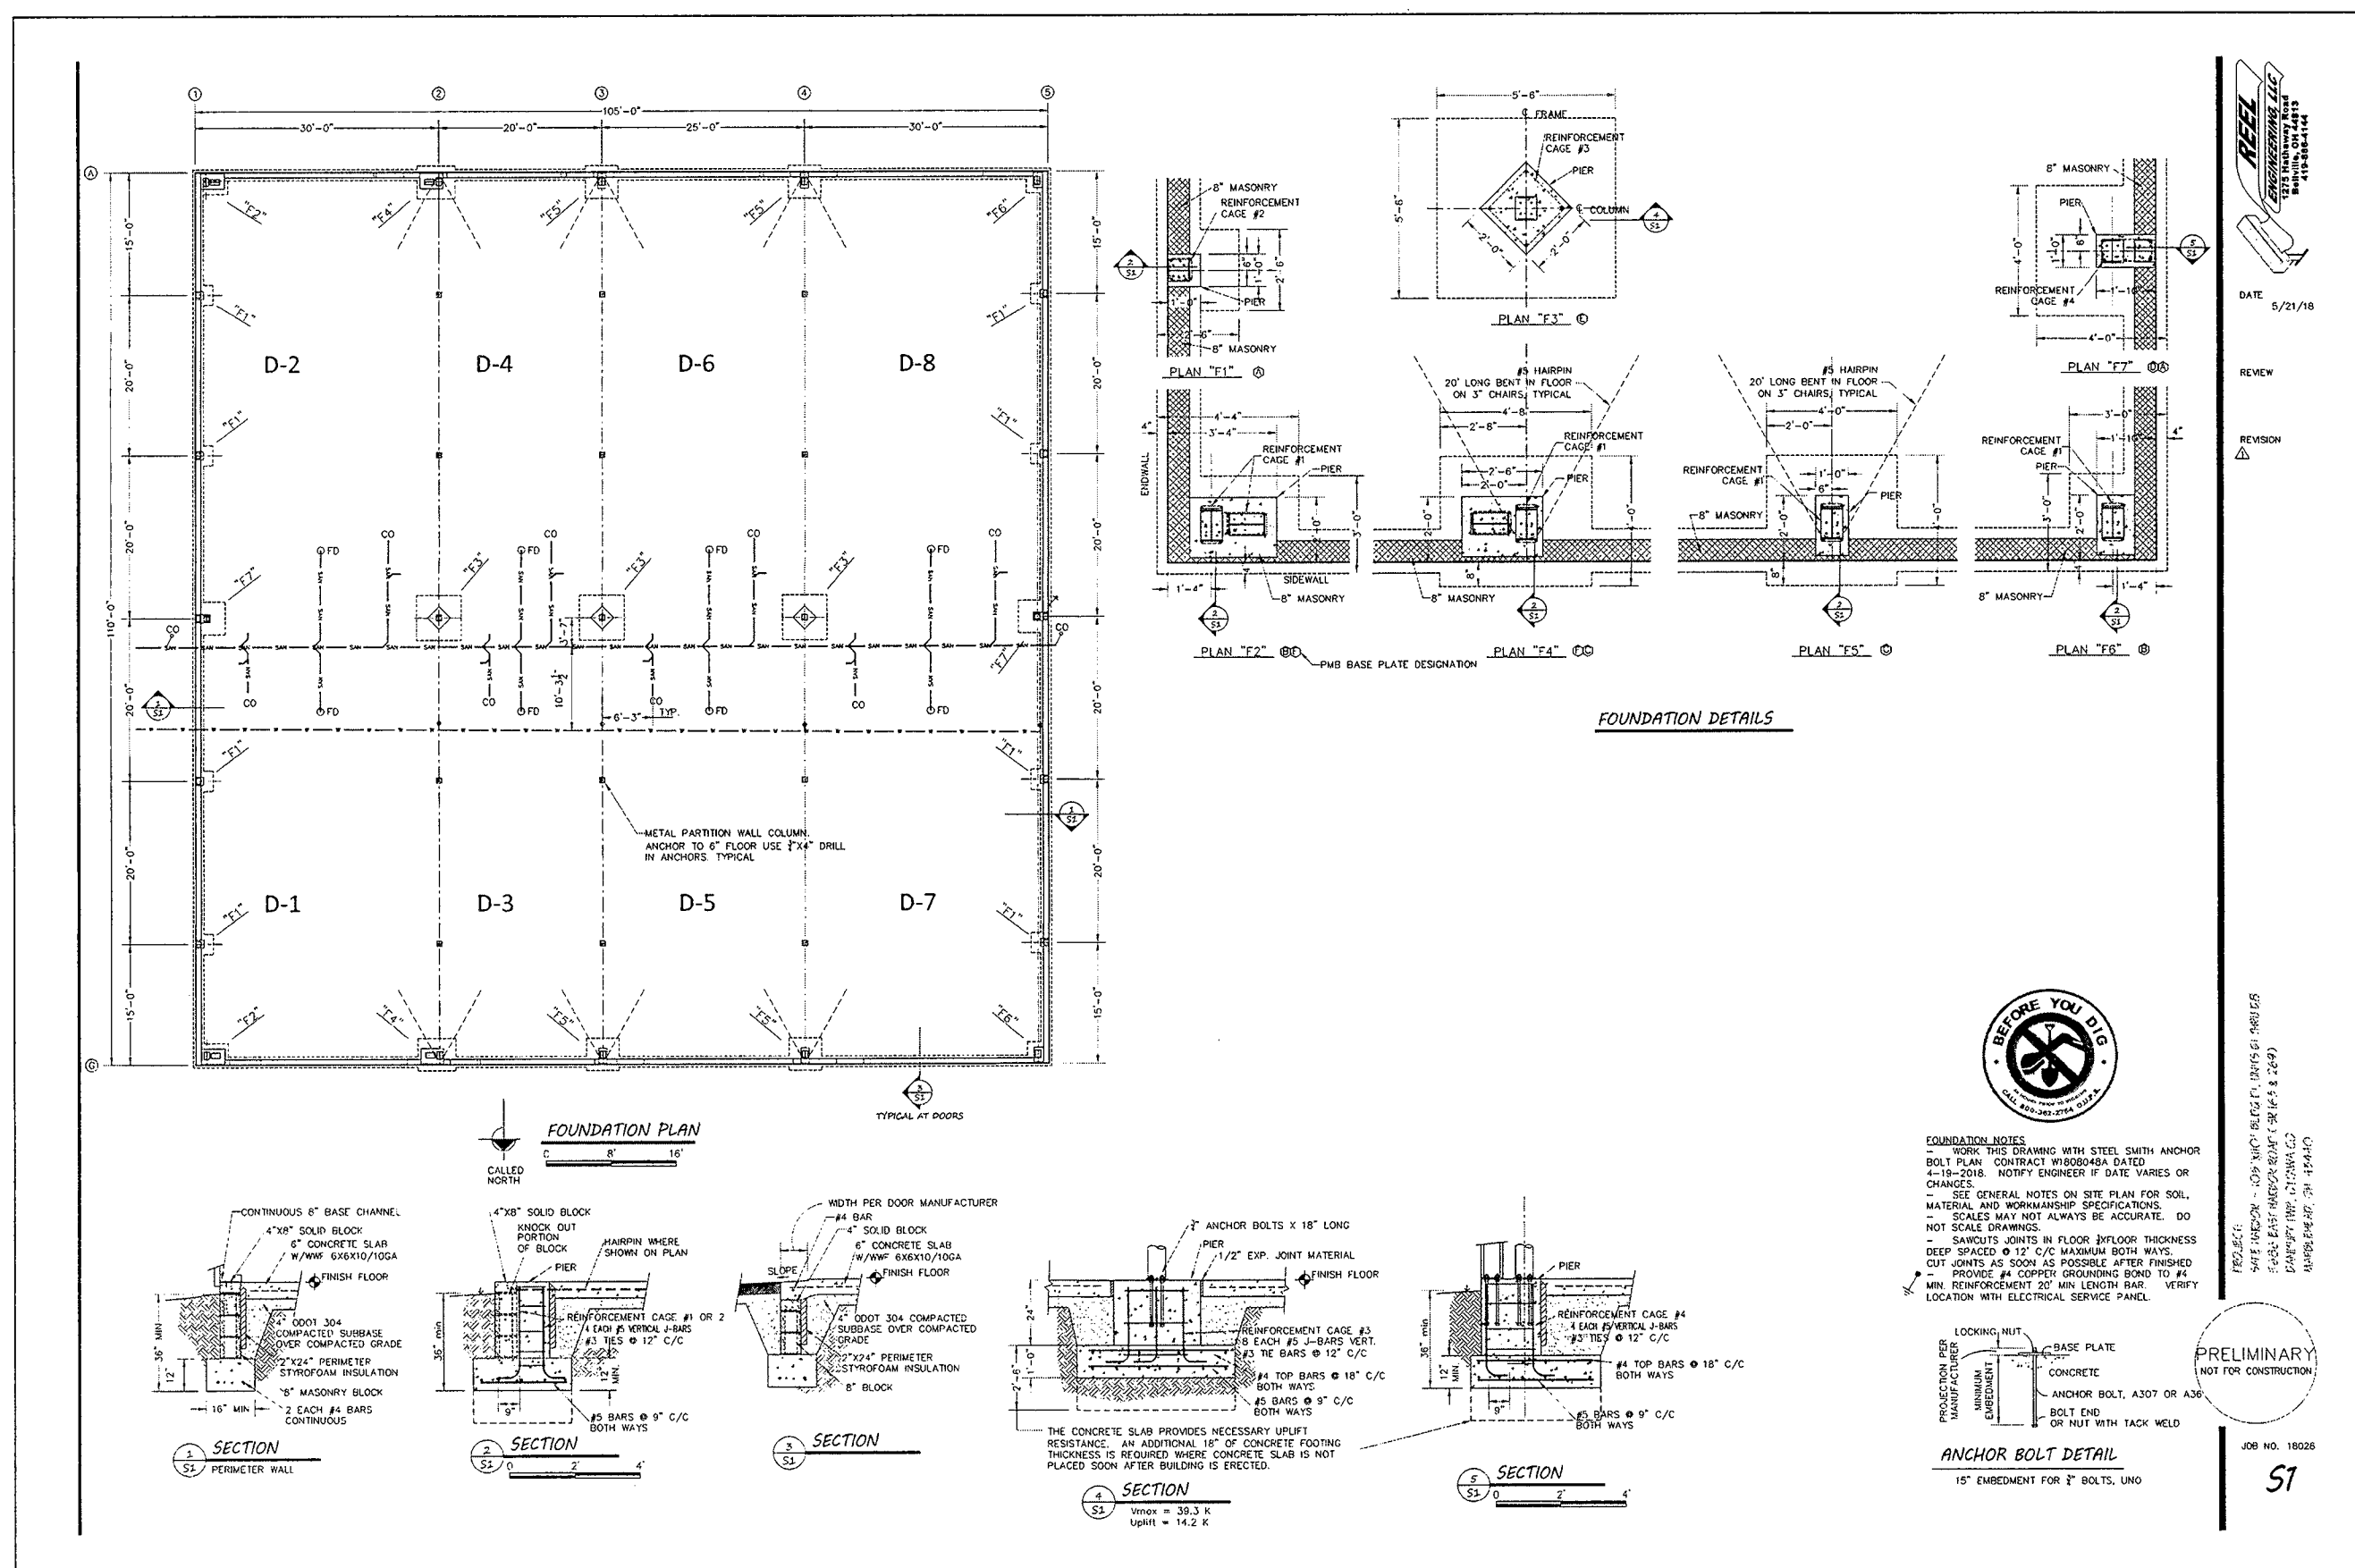


PLOTTED: Oct 16, 2018 11:58am
DRAWING: M:\15080 (Safe Harbor Development - Safe Harbor Plaza Building Layout)\SURVEY\DWG\22x34 Safe Harbor Condominiums EIGHTH Amendment.dwg PAGE3

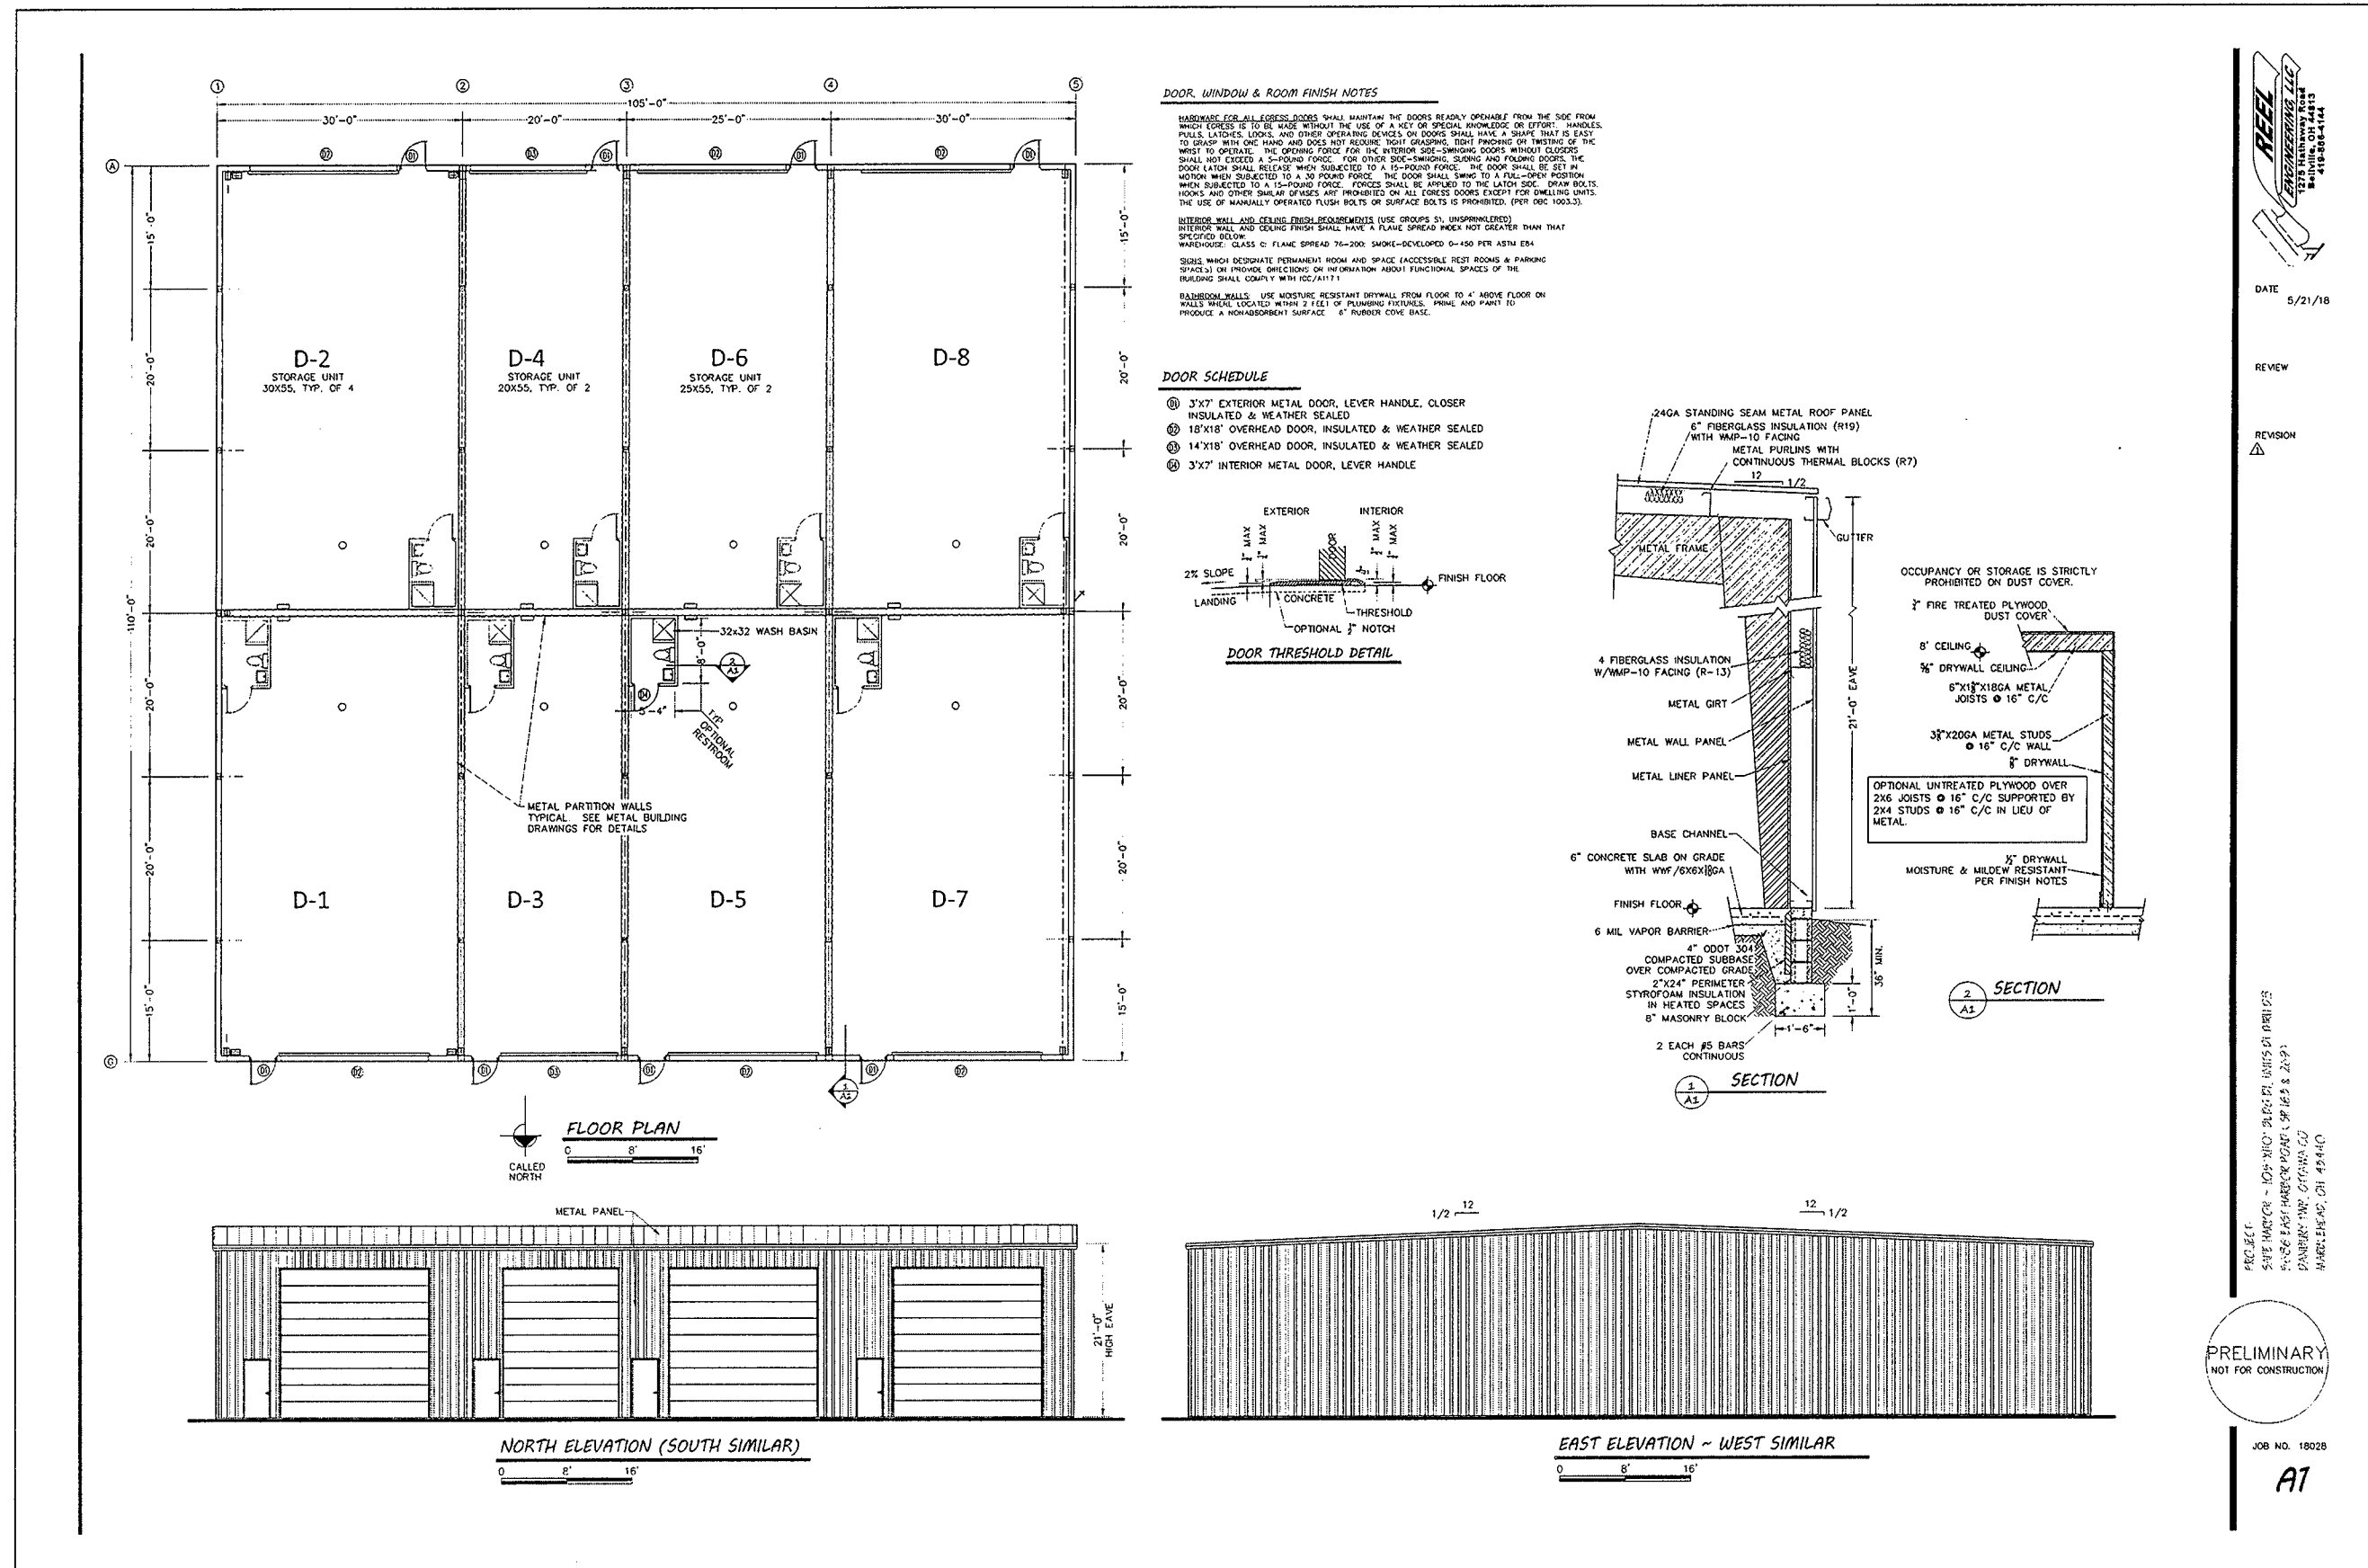

ENGINEER'S CERTIFICATION:
I HEREBY DECLARE THAT THE DRAWING ACCURATELY SHOWS EACH BUILDING AS BUILT TO THE BEST OF MY KNOWLEDGE AND BELIEF.

Joshua J. O'Neil
DATE: 10.17.2018
OHIO PROFESSIONAL ENGINEER NO. 69283

SAFE HARBOR STORAGE
CONDOMINIUM
EIGHTH AMENDMENT
LOCATED IN PART OF LOT 03, SECTION 04, DANEBURY
TOWNSHIP, OTTAWA COUNTY, OHIO.

