


SCALE: 1"=20'
FIRST AMENDMENT


20240003786 06/24/2024 03:19 PM
 Filed for Record in OTTAWA County, Ohio
 Nathan J. Daniels Rec Fees: \$134.40
 OR Vol 74 Pgs 203 - 204

- REFERENCES:
- COUNTY DEED/OFFICIAL RECORD BOOKS AND PAGES AS SHOWN.
 - SURVEY FOR ESTATE OF ALBERTA TEWERS, BY KUSMER & ASSOCIATES, INC., OCTOBER 1999.
 - OTTAWA COUNTY SURVEY RECORDS:
 1-7-98A 1-7-98B 2-7-57 3-7-88B 4-7-104
 4-7-108B 4-7-110M
 DANBURY-4-11-00038P1 DANBURY-4-11-00038P2
 DANBURY-54-11-00271

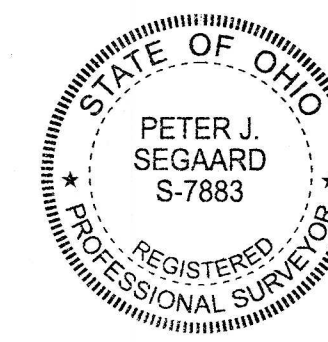


SURVEYOR'S CERTIFICATION:
 I HEREBY DECLARE THAT THE DRAWING ACCURATELY REFLECTS THE LOCATION OF IMPROVEMENTS AND RECORDED EASEMENTS TO THE BEST OF MY KNOWLEDGE AND BELIEF.

Peter J. Segard
 PETER J. SEGARD, P.S.
 OHIO PROFESSIONAL SURVEYOR NO. 7883
 DATE: 6-11-2024

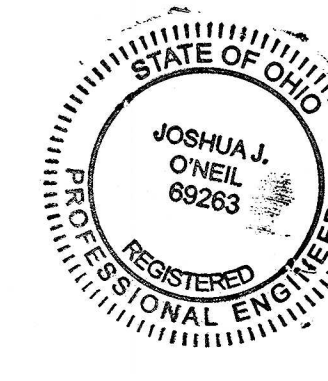

ENGINEER'S CERTIFICATION:
 I HEREBY DECLARE THAT THE DRAWING ACCURATELY SHOWS EACH BUILDING AS BUILT TO THE BEST OF MY KNOWLEDGE AND BELIEF.

Joshua J. O'Neil
 JOSHUA J. O'NEIL, P.E.
 OHIO PROFESSIONAL ENGINEER NO. 69263
 DATE: 6-13-2024

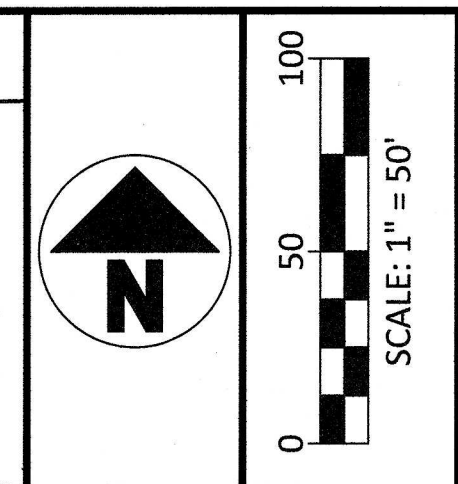

NO	REVISION	DATE
9		
8		
7		
6		
5		
4		
3		
2		
1		

DGL CONSULTING ENGINEERS, LLC
 123 B MAPLE STREET
 PORT CLINTON, OH 43452
 PHONE: 419.635.7541
 www.dgl-td.com

SHORELINE STORAGE CONDOMINIUM SUITES

PART OF LOT 2, SECTION 4, OF THE FIRELANDS SURVEY,
 DANBURY TOWNSHIP,
 OTTAWA COUNTY, OHIO

FIRST AMENDMENT

Shoreline Storage Suites Amend 1.dwg
 JOB NO.: 22127-5-1
 DRAWN BY: PJS
 ISSUED: 2024-06-10

1/2