


SCALE: 1"=20'  
**SECOND AMENDMENT**

LEGEND:  
 A - UNIT  
 AA - LIMITED COMMON ELEMENT


20240006320 10/09/2024 03:45 PM  
 Filed for Record in OTTAWA County, Ohio  
 Nathan J. Daniels Rec Fees: \$145.40  
 OR Vol 74 Pgs 264 - 265

REFERENCES:  
 - COUNTY DEED/OFFICIAL RECORD BOOKS AND PAGES AS SHOWN.  
 - SURVEY FOR ESTATE OF ALBERTA TEWERS, BY KUSMER & ASSOCIATES, INC., OCTOBER 1999.  
 - OTTAWA COUNTY SURVEY RECORDS:  
 1-7-98A 1-7-98B 2-7-57 3-7-88B 4-7-104  
 4-7-108B 4-7-110M  
 DANBURY-4-11-00038P1 DANBURY-4-11-00038P2  
 DANBURY-54-L1-00271

SURVEYOR'S CERTIFICATION:  
 I HEREBY DECLARE THAT THE DRAWING ACCURATELY REFLECTS THE LOCATION OF IMPROVEMENTS AND RECORDED EASEMENTS TO THE BEST OF MY KNOWLEDGE AND BELIEF.  
 P.J.S. 10-4-2024  
 PETER J. SEGAARD, P.S.  
 OHIO PROFESSIONAL SURVEYOR NO. 7883

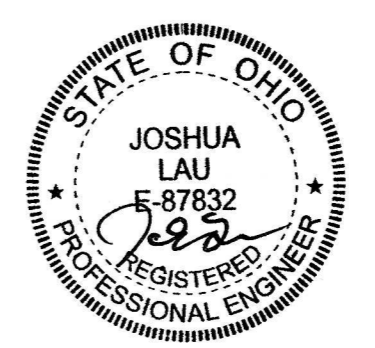

ENGINEER'S CERTIFICATION:  
 I HEREBY DECLARE THAT THE DRAWING ACCURATELY SHOWS EACH BUILDING AS BUILT TO THE BEST OF MY KNOWLEDGE AND BELIEF.  
 J.L. 10/04/2024  
 JOSHUA LAU, P.E.  
 OHIO PROFESSIONAL ENGINEER NO. 87832

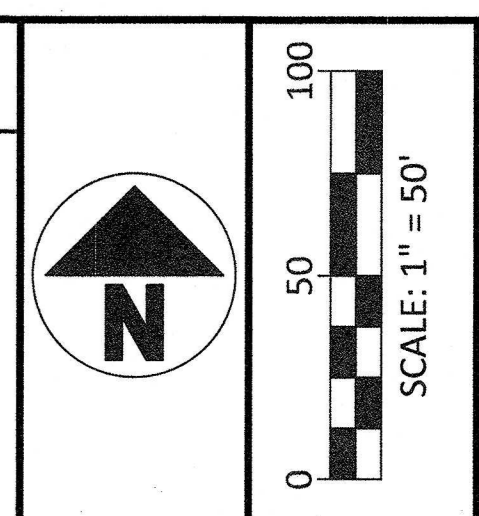

NO	REVISION	DATE
9		
8		
7		
6		
5		
4		
3		
2		
1		

DGL CONSULTING ENGINEERS, LLC  
 11000 W. STATE ST. SUITE 200  
 PORT WINTON, OHIO 43150  
 PHONE: 614.635.7541  
 www.dgl-td.com

**SHORELINE STORAGE CONDOMINIUM SUITES**  
 PART OF LOT 2, SECTION 4, OF THE FIRELANDS SURVEY,  
 DANBURY TOWNSHIP,  
 OTTAWA COUNTY, OHIO  
**SECOND AMENDMENT**

Shoreline Storage Suites Amend 2.dwg  
 JOB NO.: 22127-5-1  
 DRAWN BY: PJS  
 ISSUED: 2024-10-01  
**1/2**