
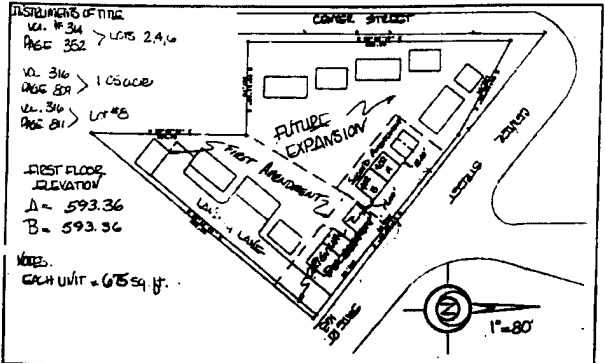


STONELANDING CONDOMINIUM OF MARBLEHEAD SECOND AMENDMENT





Buildings as constructed.
David A. Brunkhorst
 David A. Brunkhorst, P.E., S.S.
 Professional Engineer 039610
 Registered Surveyor 06714

MAIN ST - STATE ROUTE #163

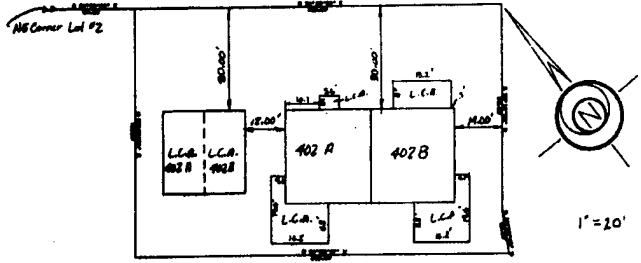

Stonelanding Condominium of Marblehead
Second Amendment

STONELANDING
CONDOMINIUM



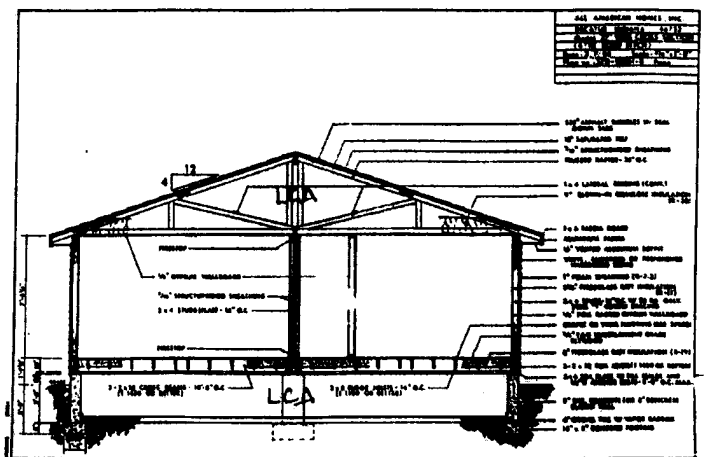
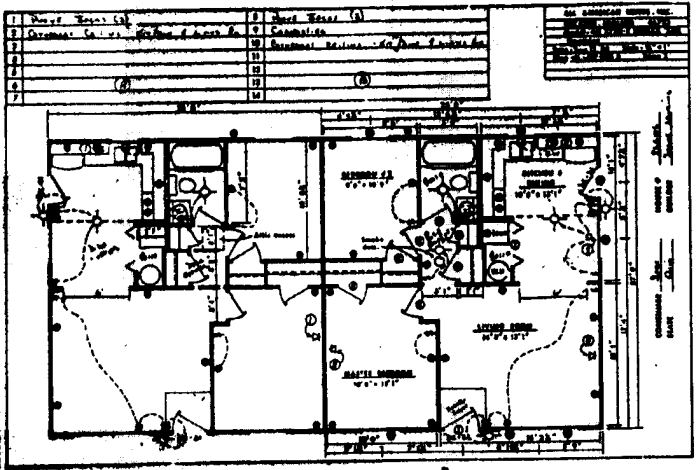
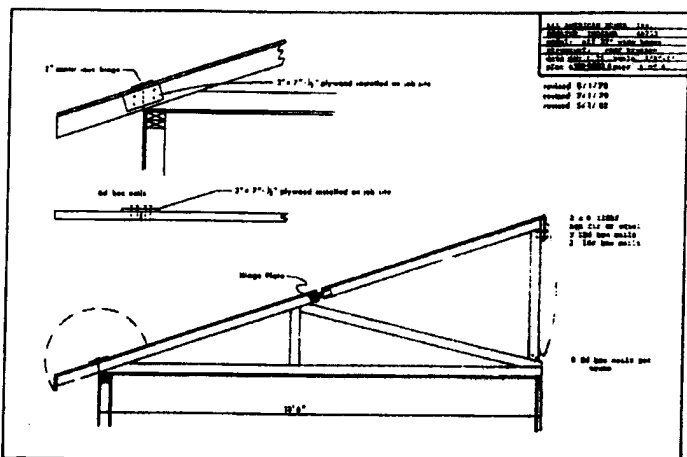
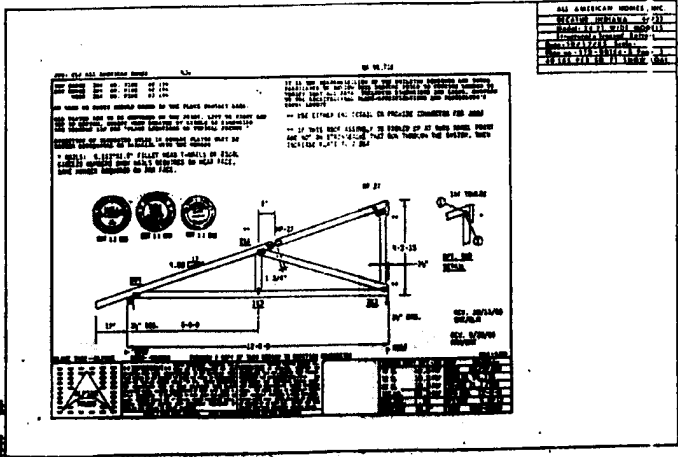


VOL. 23
13A

GARBER'S
 PRINTING, BOUNDING, OFFICE FURNISHING
 27 S. GARDEN ST. DELAWARE, OHIO 43015

STONELANDING CONDOMINIUM OF MARBLEHEAD SECOND AMENDMENT

SHEET 3 of 4

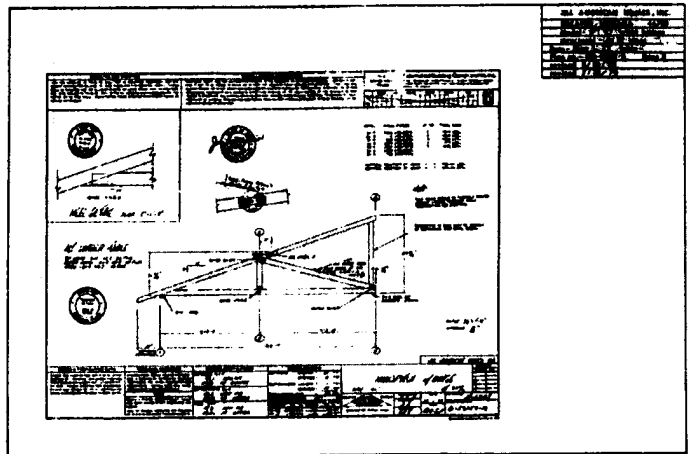
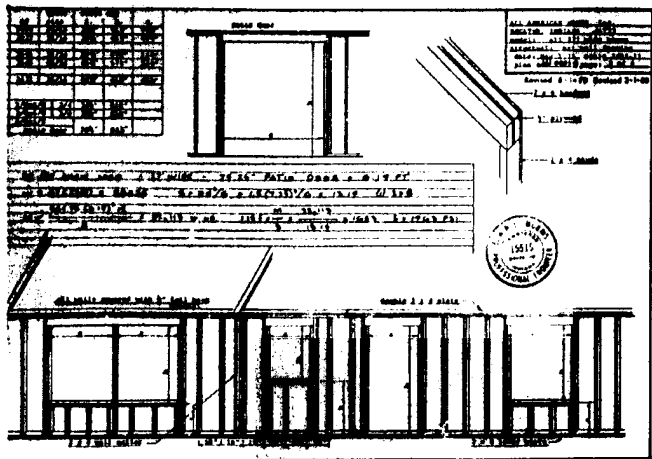
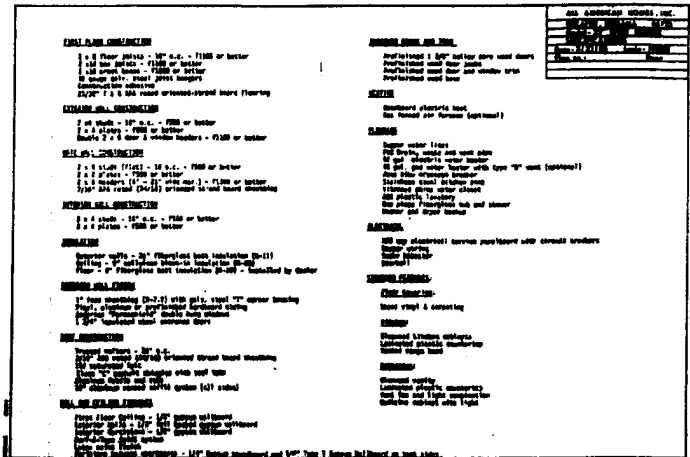
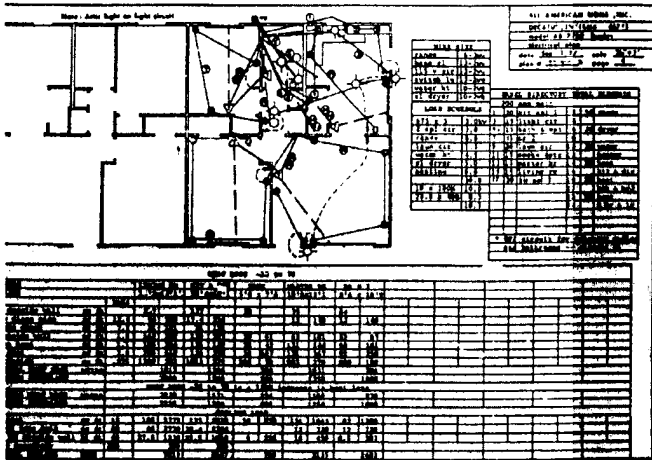
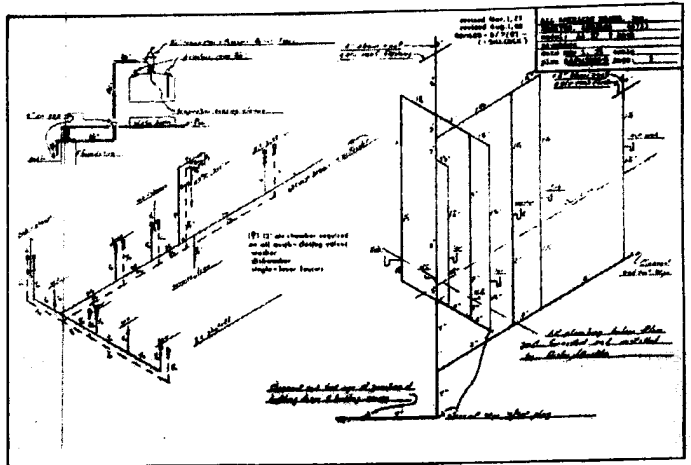
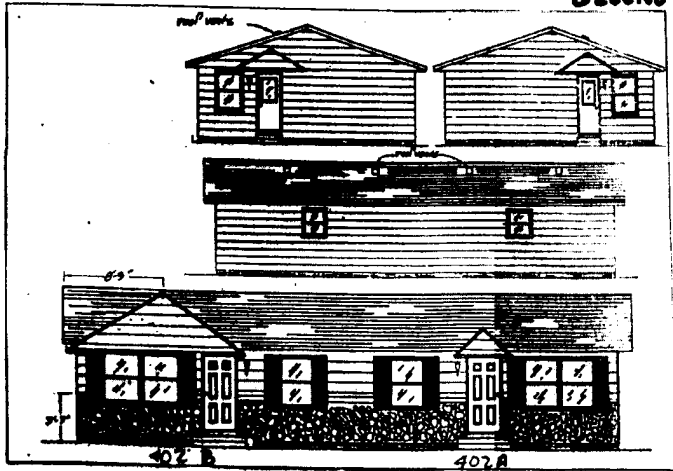


MADE IN U.S.A.
 1951
 GARDNER S
 218 SUMMIT WILMINGTON OHIO 43081
 William F. Rorer
 Vice President, Recorder
 Van Co., Ohio, Phone 2-2660

Vol. 23 13B

STONELANDING CONDOMINIUM OF MARBLEHEAD SECOND AMENDMENT

SHEET 2 OF 4

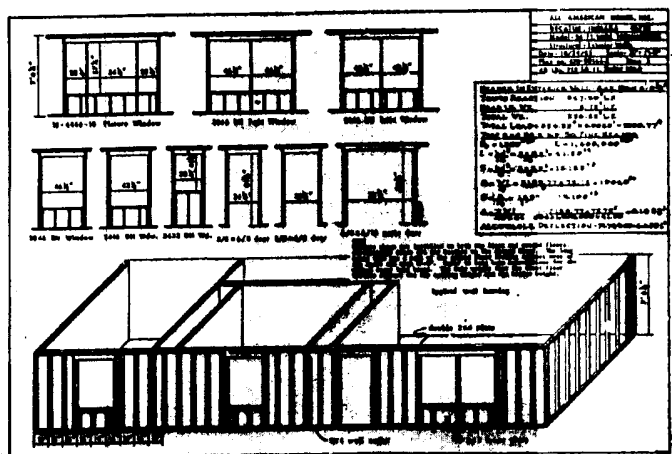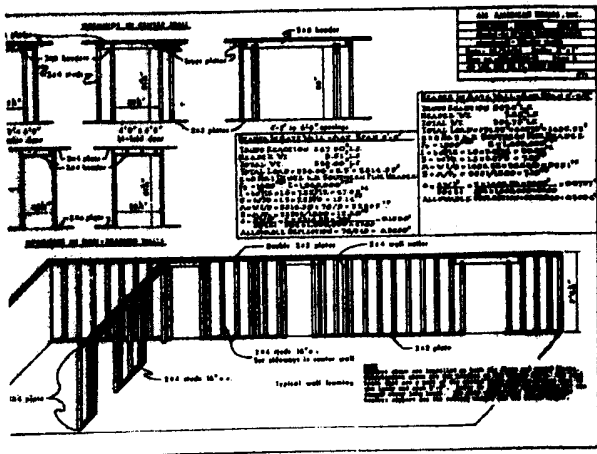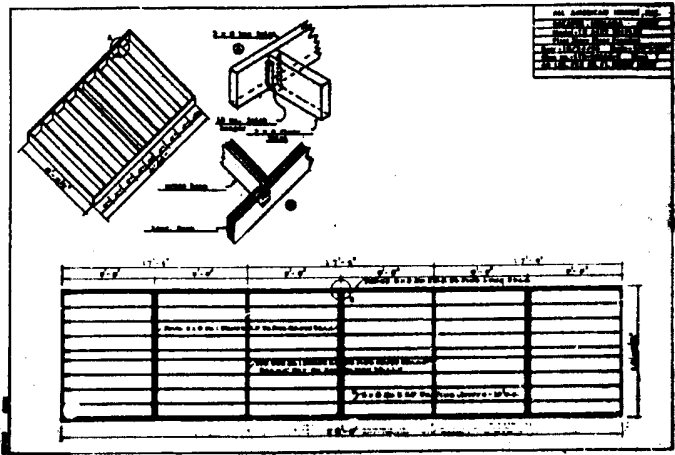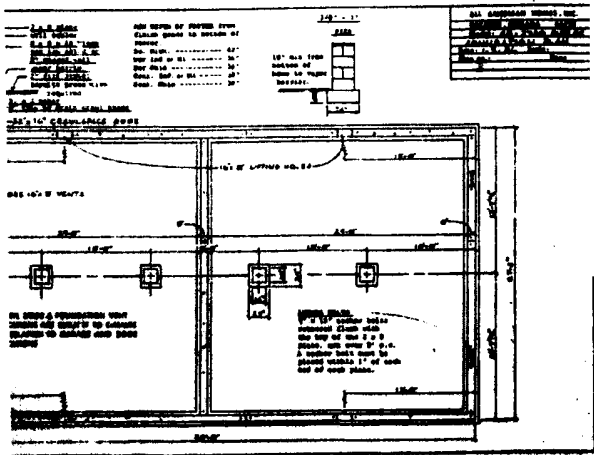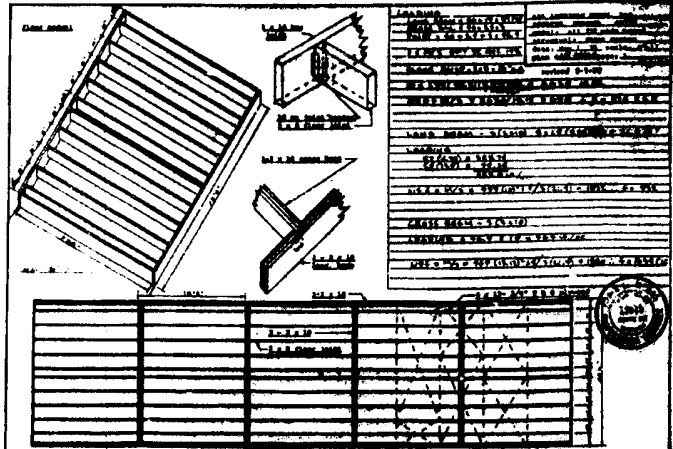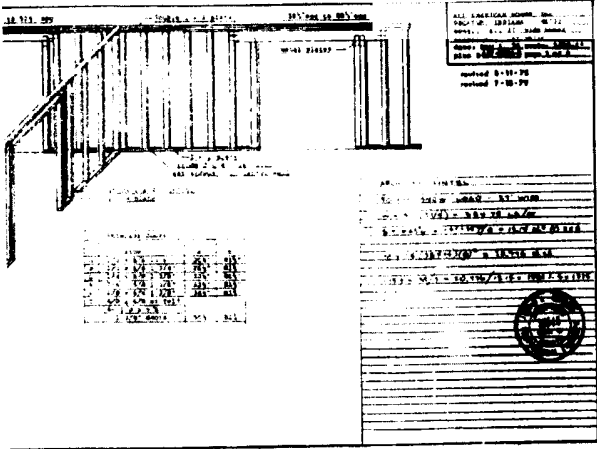

© 1978
 1000 W. 10th St., Dept. 100
 Chicago, Ill. 60607
 Phone: 312-321-1100
 Telex: 251100
 Cable: 251100