



ANY INFORMATION OR DATA ON THIS DRAWING IS NOT INTENDED TO BE SUITABLE FOR REUSE BY ANY PERSON, FIRM, OR CORPORATION OR ANY OTHERS ON EXTENSIONS OF THIS PROJECT OR FOR ANY USE ON ANY OTHER PROJECT WITHOUT THE WRITTEN CONSENT OF THE ENGINEER. THE ENGINEER'S LIABILITY IS LIMITED TO THE PURPOSE INTENDED BY THE USER'S SOLE RISK AND WITHOUT LIABILITY OR LEGAL EXPOSURE TO THE ENGINEER OR SURVEYOR.

I HEREBY CERTIFY THAT THE DRAWING ACCURATELY REFLECTS THE LOCATION OF UNITS, IMPROVEMENTS, AND RECORDED EASEMENTS TO THE BEST OF MY KNOWLEDGE AND BELIEF.


PETER J. SEGAARD, P.E. 7883
 5-27-2011
 DATE
 OHIO PROFESSIONAL SURVEYOR

I HEREBY CERTIFY THAT THE DRAWING ACCURATELY REFLECTS EACH UNIT AS BUILT OR CONSTRUCTED TO THE BEST OF MY KNOWLEDGE AND BELIEF.


MILTON R. POMMERANZ, P.E. 39476
 5-27-2011
 DATE
 OHIO PROFESSIONAL ENGINEER

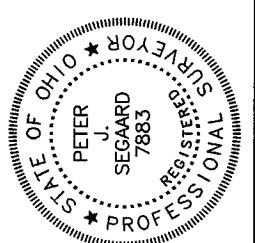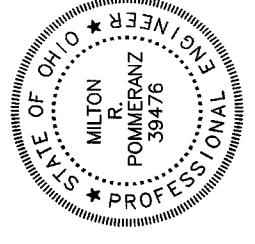


BRACED WALL DETAILS

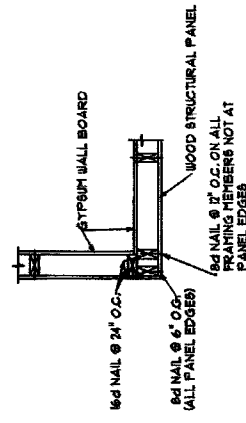


DETAIL 'A'
OUTSIDE CORNER
(R40232A)

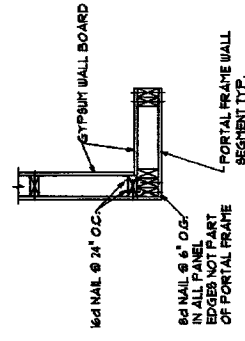


DETAIL 'C'
CORNER
A.P.A. CORNER

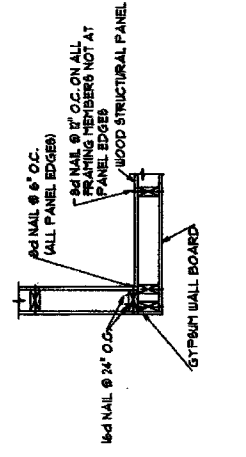


DETAIL 'B'
INSIDE CORNER
(R40232B)

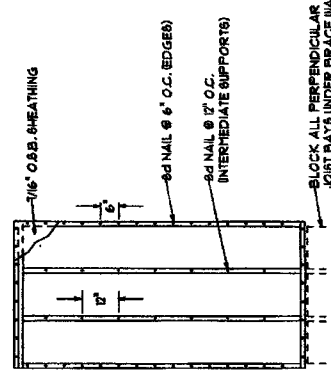

DETAIL 'D'
CONTINUOUS STRUCTURAL PANEL SHEATHING
(R40232D)

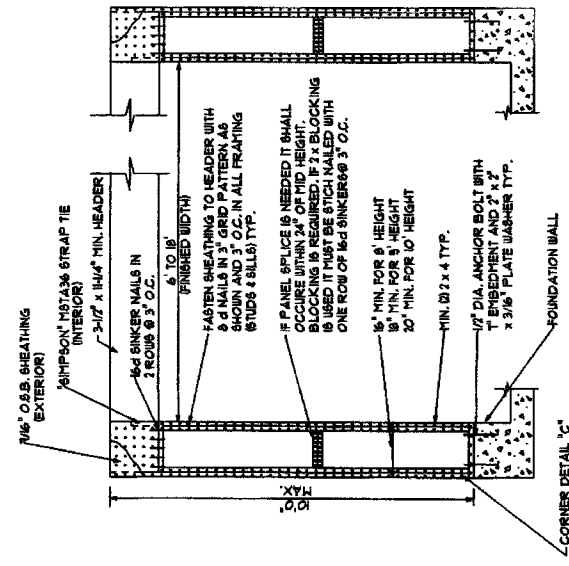

DETAIL 'E'
A.P.A. BRACED WALL
GARAGE DOOR OPENING

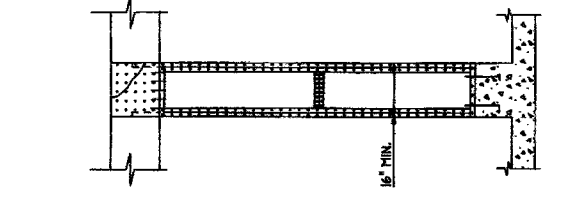


DETAIL 'F'
A.P.A. BRACED WALL
GARAGE DOOR INTERMEDIATE SUPPORT

PLEASE NOTE:

THE CONTRACTOR SHALL BE RESPONSIBLE FOR ANY DAMAGE TO EXISTING UTILITIES OR STRUCTURES CAUSED BY THE CONSTRUCTION OF THIS PROJECT. THE CONTRACTOR SHALL BE RESPONSIBLE FOR OBTAINING ALL NECESSARY PERMITS AND APPROVALS FROM THE APPROPRIATE AGENCIES. THE CONTRACTOR SHALL BE RESPONSIBLE FOR OBTAINING ALL NECESSARY PERMITS AND APPROVALS FROM THE APPROPRIATE AGENCIES. THE CONTRACTOR SHALL BE RESPONSIBLE FOR OBTAINING ALL NECESSARY PERMITS AND APPROVALS FROM THE APPROPRIATE AGENCIES.

NOTE: BUILDER MUST USE ALTERNATE MATERIALS THAT SATISFY LOCAL BUILDING CODES.

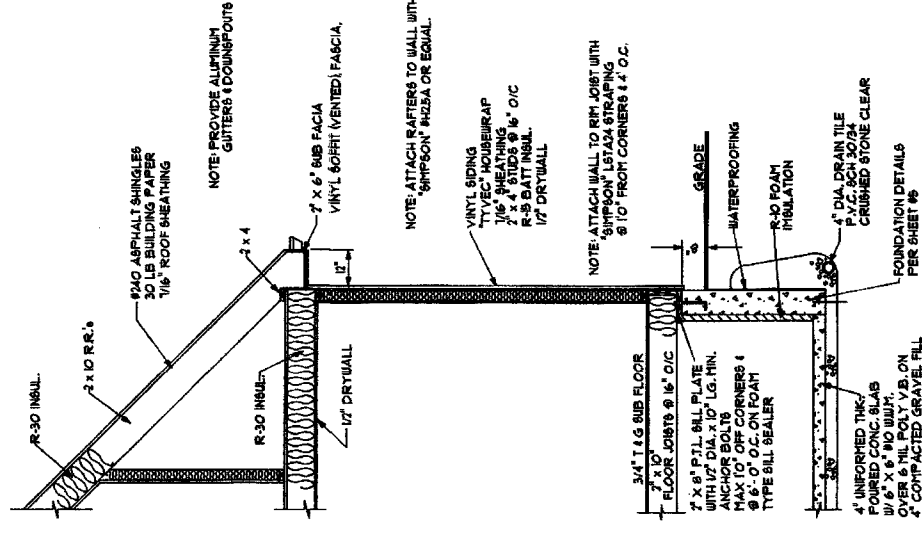


SECTION 1
SCALE 1/4\"/>

ANY INFORMATION OR DATA ON THIS DRAWING IS NOT INTENDED TO BE SUITABLE FOR REUSE BY ANY PERSON, FIRM, OR CORPORATION OR ANY OTHER PROJECT. ANY REUSE WITHOUT WRITTEN VERIFICATION OF THE ORIGINAL ENGINEER SHALL BE AT THE USER'S SOLE RISK AND WITHOUT LIABILITY OR LEGAL EXPOSURE TO THE ENGINEER OR SURVEYOR.

I HEREBY CERTIFY THAT THE DRAWING ACCURATELY REFLECTS THE LOCATION OF UNITS, IMPROVEMENTS, AND RECORDED EASEMENTS TO THE BEST OF MY KNOWLEDGE AND BELIEF.

Peter J. Segard, P.S. 7883
 5.27.2011
 DATE

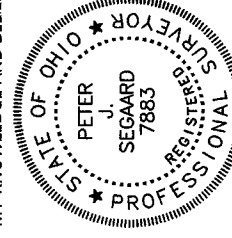

I HEREBY CERTIFY THAT THE DRAWING ACCURATELY REFLECTS EACH UNIT AS BUILT OR CONSTRUCTED TO THE BEST OF MY KNOWLEDGE AND BELIEF.

Milton R. Pommeranz, P.E. 5/12/2011
 DATE

