

I HEREBY CERTIFY THAT THE DRAWING ACCURATELY REFLECTS EACH UNIT AS BUILT OR TO BE CONSTRUCTED AND THAT I AM A LICENSED ARCHITECT IN THE STATE OF CALIFORNIA.

Michael J. Galt
 ARCHITECT
 MICHAEL J. GALT ARCHITECTURE, INC.
 1000 S. GARDEN AVENUE, SUITE 100
 ANAHEIM, CALIFORNIA 92805
 (714) 771-1111

I HEREBY CERTIFY THAT THE DRAWING ACCURATELY REFLECTS THE LOCATION OF UNITS, STAIRS AND ELEVATORS TO THE BEST OF MY KNOWLEDGE AND BELIEF.



Michael J. Galt
 ARCHITECT
 MICHAEL J. GALT ARCHITECTURE, INC.
 1000 S. GARDEN AVENUE, SUITE 100
 ANAHEIM, CALIFORNIA 92805
 (714) 771-1111

ANY INFORMATION OR DATA ON THIS DRAWING IS NOT INTENDED TO BE USED FOR ANY OTHER PURPOSES AND IS NOT TO BE REPRODUCED OR TRANSMITTED IN ANY FORM OR BY ANY MEANS, ELECTRONIC OR MECHANICAL, INCLUDING PHOTOCOPYING, RECORDING, OR BY ANY INFORMATION STORAGE AND RETRIEVAL SYSTEM, WITHOUT THE WRITTEN PERMISSION OF THE ARCHITECT.

DATE: 08/14/11

PROJECT: SUNSET COVE AT BAY POINT PHASE 2 UNIT 4

A1

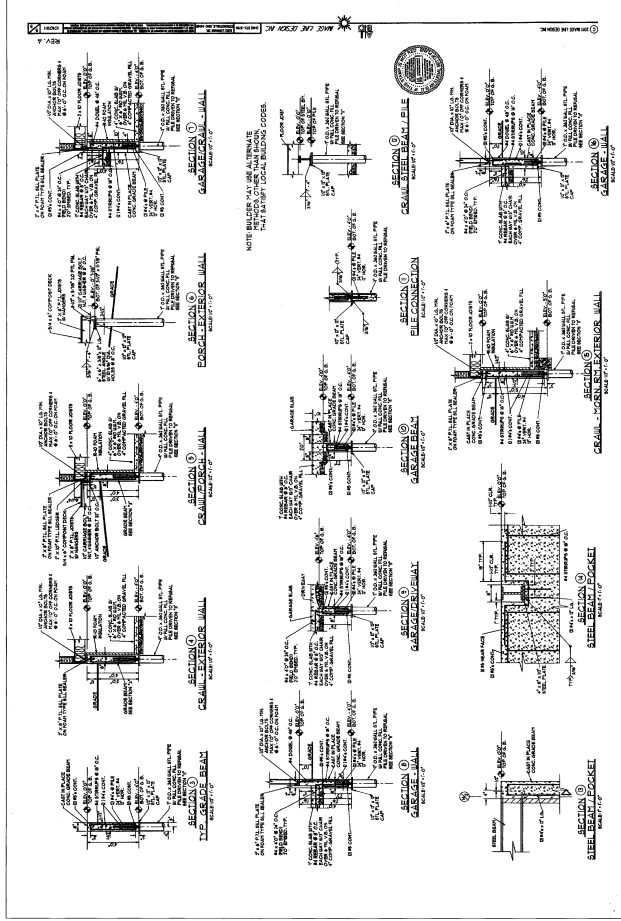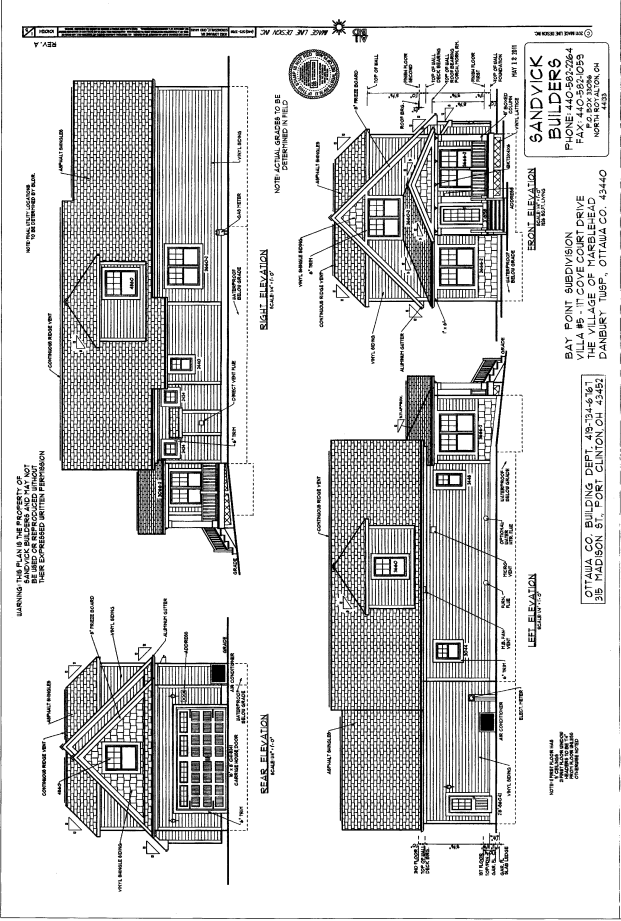

I HEREBY CERTIFY THAT THE DRAWING ACCURATELY INDICATES EACH UNIT AS BUILT OR CONSTRUCTED TO THE BEST OF MY KNOWLEDGE AND BELIEF.

Michael J. Stiller
 PROFESSIONAL ENGINEER
 STATE OF OHIO



I HEREBY CERTIFY THAT THE DRAWING ACCURATELY INDICATES THE LOCATION OF WALLS, WINDOWS, DOORS, AND RECORDED EASEMENTS TO THE BEST OF MY KNOWLEDGE AND BELIEF.

Robert J. Stiller
 PROFESSIONAL ENGINEER
 STATE OF OHIO

I, SANDYCK BUILDERS, HEREBY CERTIFY THAT THE DRAWING ACCURATELY INDICATES THE LOCATION OF WALLS, WINDOWS, DOORS, AND RECORDED EASEMENTS TO THE BEST OF MY KNOWLEDGE AND BELIEF.

Sandyck Builders
 PROFESSIONAL ENGINEER
 STATE OF OHIO

