

OTTAWA COUNTY ENGINEERS OFFICE

REFERENCE NO. 20-7-16-G
 SW CORNER POST SEC. 20
 ERIE TWP.
 SHEET 1 OF 1.

ROUTE: C-15 CAMP PERRY WESTERN RD.

TOWNSHIP: ERIE


SECTION: 20

T 7 NR 16 E.

NORTHING:

EASTING:

DATUM:

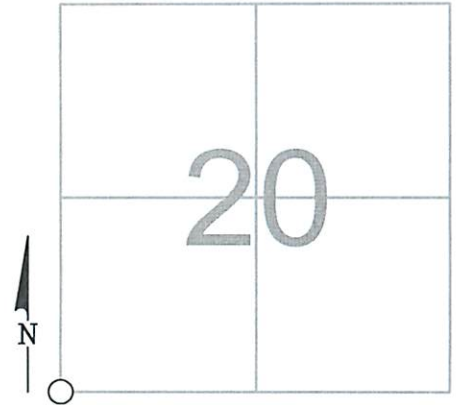

PERSONNEL:
 M. WITTMAN, P.S.
 J. ALLEN
 J. TIMMONS

DATE / WEATHER / TEMP:
 JULY 13, 2016
 SUNNY - W-SW
 80° F

MONUMENT INFORMATION

MONUMENT TYPE: FD. 1" Ø IRON PIN
 ON SURFACE - BELOW: 0.37'
 LEFT - CL PAV'T - RIGHT: 2.40'

IRON PIN PER SURVEY BY K.E.W. - NO DATE IN COUNTY RECORDS.



MISC. INFORMATION

IRON PIN HAS A SLIGHT WESTERLY LEAN.
 ACCEPTED IRON PIN AS CORNER AS IT IS OF RECORD AND ALL SURVEYS IN AREA ARE TIED TO THIS PIN. DISTNACE FROM N1/4 POST TO THIS PIN WAS 0.11' LONG. IRON PIN HAD PUNCH MARK THAT WAS ENHANCED WITH A DRILL HOLE.

JULY 12, 2016

SET MONUMENT BOX OVER
 1" Ø IRON PIN

