

# OTTAWA COUNTY ENGINEERS OFFICE

REFERENCE NO. 28-7-16-H  
SOUTH QUARTER POST SEC. 28  
ERIE TWP.  
SHEET 1 OF 1.

PERSONNEL:  
M. WITTMAN, P.S.  
J. ALLEN

DATE / WEATHER / TEMP:  
JULY 21, 2014  
SUNNY, N-NE  
87° F

ROUTE: S- #358 @ S- #2

TOWNSHIP: ERIE


SECTION: 28

T 7 NR 16 E.

NORTHING:

EASTING:

DATUM:

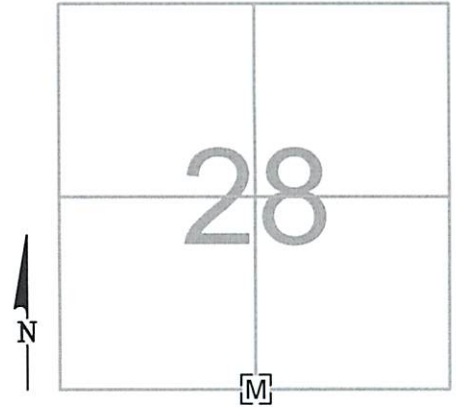

## MONUMENT INFORMATION

MONUMENT TYPE: FD 1" SQ. IRON PIN IN MON BOX  
ON SURFACE - BELOW: 0.06'  
LEFT - CL PAV'T - RIGHT: 14.30'



## MISC. INFORMATION

8-13-1999 - FD 5-1/2" X 4" TRIANGULAR STONE 2.34'  
BELOW SURFACE BY ODOT CREWS WORKING IN  
CONJUNCTION WITH OCE STAFF, R. NUHFER, P.S. &  
M. BROUGH. PHOTO OF STONE NOT TAKEN. ODOT  
SET IRON PIN IN MOMUMENT BOX OVER STONE  
AUGUST OR SEPTEMBER 1999.

