

OTTAWA COUNTY ENGINEERS OFFICE

REFERENCE NO. 28-7-16-K
EAST 1/16 POST SECTION 28
ERIE TWP.
SHEET 1 OF 1.

ROUTE: C-171 CAMP PERRY EAST RD.

TOWNSHIP: ERIE

SECTION: 28

T 7 NR 16 E.

PERSONNEL:
M. WITTMAN, P.S.
J. ALLEN


NORTHING:

EASTING:

DATUM:

DATE / WEATHER / TEMP:

JULY 1, 2014
OVERCAST, SW
84° F

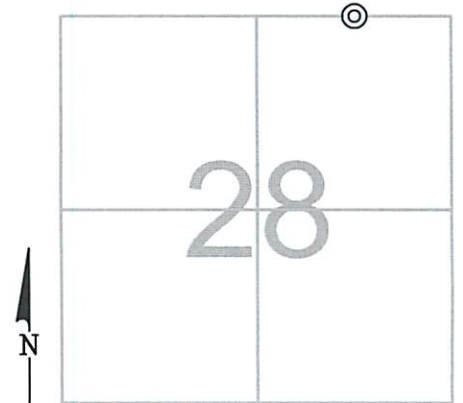

MONUMENT INFORMATION

MONUMENT TYPE: FD 1-1/4" Ø IRON PIPE
ON SURFACE - BELOW: 0.37'
LEFT - CL PAV'T - RIGHT: 8.70' (FROM C/L CURVE)



MISC. INFORMATION

JULY 1, 2014

SET MONUMENT BOX OVER
FOUND IRON PIPE

