

OTTAWA COUNTY ENGINEERS OFFICE

REFERENCE NO. 28-7-16-P
CENTER EAST 1/16 POST SEC. 28
ERIE TWP.
SHEET 1 OF 1.

ROUTE: C-171 CAMP PERRY EAST RD.
@ JACKSON BOHLING RD.

TOWNSHIP: ERIE

SECTION: 28

T 7 N R 16 E.

PERSONNEL:
M. WITTMAN, P.S.
J. ALLEN


NORTHING:

EASTING:

DATUM:

DATE / WEATHER / TEMP:


JULY 1, 2014
OVERCAST, S-SW
84° F

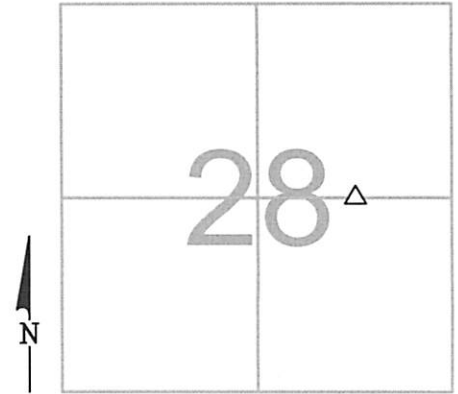

MONUMENT INFORMATION

MONUMENT TYPE: FD 8-1/2" X 5" TRIANGULAR STONE
ON SURFACE - BELOW: 2.25'
LEFT - CL PAV'T - RIGHT: 0.90'

USED CENTER OF STONE.

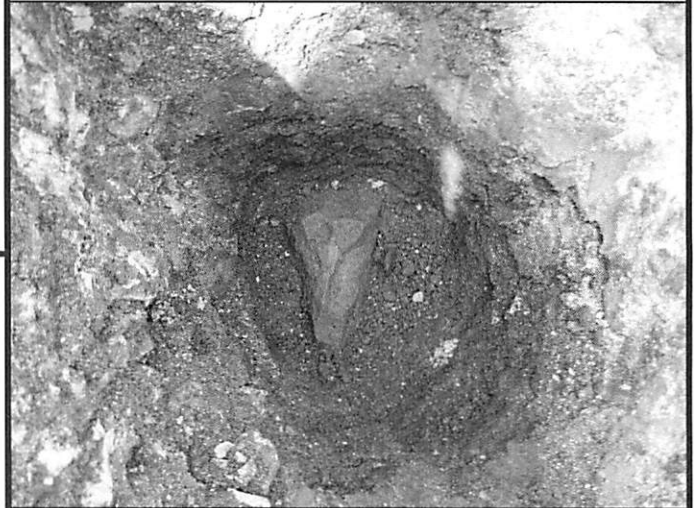

MISC. INFORMATION

FD SQUARE HEAD BOLT 0.58' BELOW SURFACE, TIED
W/ X-TIES AND DUG FOR STONE OF RECORD. BOLT
WAS OVER CENTER OF STONE.

JULY 1, 2014

SET 1" SQUARE IRON PIN
IN MONUMENT BOX OVER
STONE

