

OTTAWA COUNTY ENGINEERS OFFICE

REFERENCE NO. 29-7-16-A
NW CORNER POST SEC. 29
ERIE TWP.
SHEET 1 OF 1.

PERSONNEL:
M. WITTMAN, P.S.
J. ALLEN
J. TIMMONS

DATE / WEATHER / TEMP:
JULY 13, 2016
SUNNY - W-SW
80° F

ROUTE: C-15 CAMP PERRY WESTERN RD.

TOWNSHIP: ERIE


SECTION: 29

T 7 N R 16 E.

NORTHING:

EASTING:

DATUM:

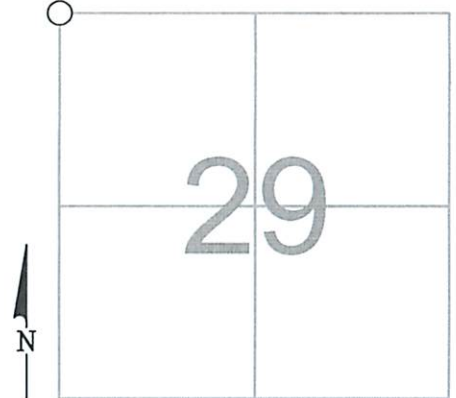

MONUMENT INFORMATION

MONUMENT TYPE: FD. 1" Ø IRON PIN
ON SURFACE - BELOW: 0.37'
LEFT - CL PAV'T - RIGHT: 2.40'

IRON PIN PER SURVEY BY K.E.W. - NO DATE IN
COUNTY RECORDS.



MISC. INFORMATION

IRON PIN HAS A SLIGHT WESTERLY LEAN.
ACCEPTED IRON PIN AS CORNER AS IT IS OF
RECORD AND ALL SURVEYS IN AREA ARE TIED TO
THIS PIN. DISTNACE FROM N1/4 POST TO THIS
PIN WAS 0.11' LONG. IRON PIN HAD PUNCH MARK
THAT WAS ENHANCED WITH A DRILL HOLE.

JULY 12, 2016

SET MONUMENT BOX OVER
1" Ø IRON PIN

