

OTTAWA COUNTY ENGINEERS OFFICE

REFERENCE NO. 29-7-16-G
SW CORNER POST SECTION 29
ERIE TWP.
SHEET 1 OF 1.

ROUTE: T-131 FRITCHIE RD.

TOWNSHIP: ERIE

SECTION: 29

T 7 NR 16 E.


NORTHING:

EASTING:

DATUM:

PERSONNEL:
M. WITTMAN, P.S.
J. ALLEN

DATE / WEATHER / TEMP:
JULY 14, 2014 JULY 21, 2014
SUNNY, E-NE SUNNY, E-NE
76° F 82°

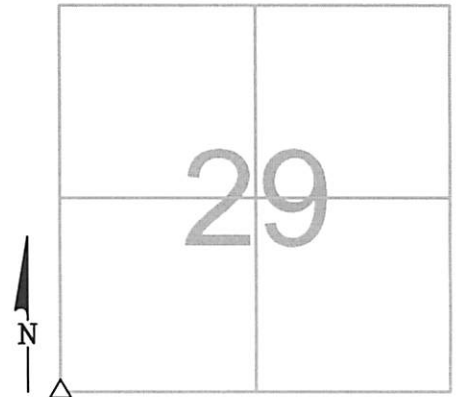

MONUMENT INFORMATION

MONUMENT TYPE: FD 6" X 4-1/2" RECTANGULAR STONE
ON SURFACE - BELOW: 1.87'
LEFT - CL PAVT - RIGHT:
USED CENTER OF STONE.



MISC. INFORMATION

7-17-14 - FD MAG NAIL ON SURFACE WITH 2'-0" TIES N,S,E & W.
DUG FOR MONUMENT BOX OF RECORD. FOUND MONUMENT
BOX 0.62' BELOW SURFACE. CLEANED OUT STONES AND
DIRT FROM BOX AND DID NOT FIND IRON PIN. PRODDED
BOTTOM OF BOX AND HIT STONE 1' BELOW THE TOP OF THE
BOX.

7-21-14 - RETURNED TO SITE REMOVED BOX AND FOUND
STONE.

JULY 21, 2014

SET 1" SQUARE IRON PIN
IN MONUMENT BOX OVER
STONE

