


OTTAWA COUNTY ENGINEERS OFFICE

REFERENCE NO. 30-7-16-A
NW CORNER POST SECTION 30
ERIE TWP.
SHEET 1 OF 1.

ROUTE: C-15 CAMP PERRY WESTERN RD
@ C-26 CARROLL - ERIE RD.

TOWNSHIP: ERIE
SECTION: 30
T 7 NR 16 E.

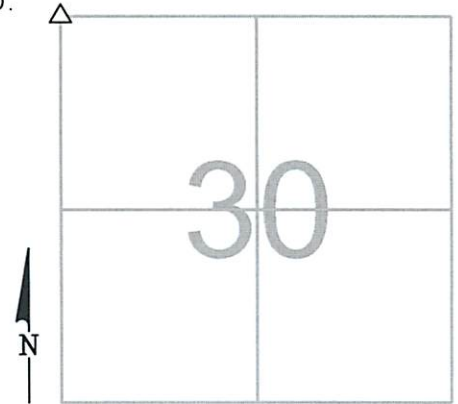

PERSONNEL:
M. WITTMAN, P.S.
J. ALLEN

NORTHING:
EASTING:
DATUM:

DATE / WEATHER / TEMP:
JUNE 10, 2014
OVERCAST, NE
70° F

MONUMENT INFORMATION

MONUMENT TYPE: FD POINTED LIMESTONE
ON SURFACE - BELOW: 1.55'
LEFT - CL PAV'T - RIGHT: 1.0'

3-1/2" X 7" POINTED LIMESTONE W/ DH
USED DRILL HOLE.



MISC. INFORMATION

FD PK NAIL 0.17' BELOW SURFACE, TIED W/
X-TIES AND DUG FOR STONE. PK NAIL WAS 0.14'
WEST AND 0.01' NORTH OF DRILL HOLE IN
STONE.

THIS IS A CLOSING CORNER.

JUNE 10, 2014

SET 1" SQUARE IRON PIN
IN MONUMENT BOX OVER
STONE

