

# OTTAWA COUNTY ENGINEERS OFFICE

REFERENCE NO. 30-7-16-G  
 SW CORNER POST SEC. 30  
 ERIE TWP.  
 SHEET 1 OF 1.

ROUTE: T-131 FRITCHIE RD.  
 @ C-26 CARROLL-ERIE RD.

TOWNSHIP: ERIE

SECTION: 30

T 7 NR 16 E.


PERSONNEL:  
 M. WITTMAN, P.S.  
 J. ALLEN

NORTHING:

EASTING:

DATUM:

DATE / WEATHER / TEMP:  
 NOVEMBER 9, 2012  
 SUNNY  
 50° F

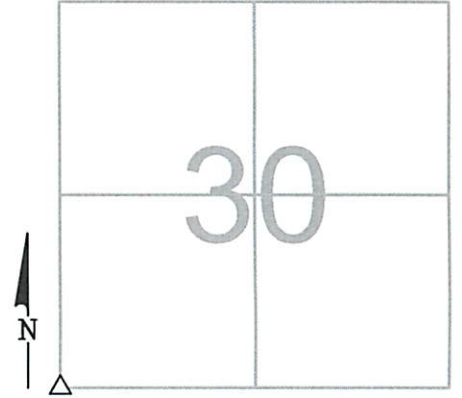

### MONUMENT INFORMATION

MONUMENT TYPE: FD. 5-1/2" SQ. STONE W/ DH  
 ON SURFACE - BELOW: 1.57'  
 LEFT - CL PAV'T - RIGHT: 2.40'

USED DRILL HOLE.



### MISC. INFORMATION

FD. PK NAIL 0.30' BELOW SURFACE, TIED W/ X-TIES  
 AND DUG FOR STONE. PK NAIL WAS 0.04' NORTH  
 AND 0.01' WEST OF DRILL HOLE.

THIS IS A CLOSING CORNER.

