

OTTAWA COUNTY ENGINEERS OFFICE

REFERENCE NO. 30-7-16-H
SOUTH QUARTER POST SEC. 30
ERIE TWP.
SHEET 1 OF 1.

ROUTE: T-13 RYMERS RD.
@ T-131 FRITCHIE RD.

TOWNSHIP: ERIE

SECTION: 30

T 7 NR 16 E.


NORTHING:

EASTING:

DATUM:

PERSONNEL:
M. WITTMAN, P.S.
J. ALLEN

DATE / WEATHER / TEMP:
JULY 15, 2014
SUNNY, SW
75° F

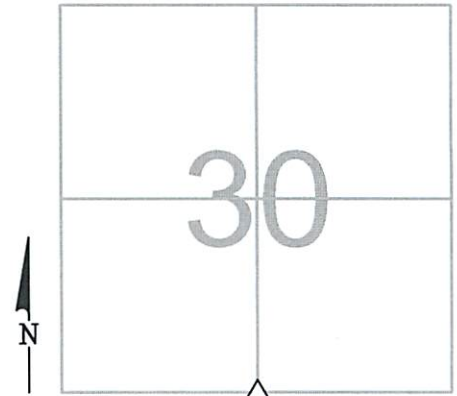

MONUMENT INFORMATION

MONUMENT TYPE: FD LIMESTONE W/ DH
ON SURFACE - BELOW: 2.23'
LEFT - CL PAV'T - RIGHT:

4" X 3-1/2" ROUND LIMESTONE

USED DRILL HOLE IN STONE.



MISC. INFORMATION

NOTHING FOUND IN EXISTING DIG HOLE ON SURFACE. FD PK NAIL 0.37' BELOW SURFACE, TIED W/ X-TIES AND DUG FOR STONE. PK NAIL FOUND WAS DIRECTLY OVER THE DRILL HOLE FOUND IN THE STONE.

JULY 15, 2014

SET 1" SQUARE IRON PIN
IN MONUMENT BOX OVER
STONE

