

# OTTAWA COUNTY ENGINEERS OFFICE

**REFERENCE NO.** 30-7-16-1  
 SE CORNER POST SECTION 30  
 ERIE TWP.  
**SHEET** 1 OF 1.

**ROUTE:** T-131 FRITCHIE RD.

**TOWNSHIP:** ERIE

**SECTION:** 30

**T** 7 **N** **R** 16 **E.**


**PERSONNEL:**  
 M. WITTMAN, P.S.  
 J. ALLEN

**NORTHING:**

**EASTING:**

**DATE / WEATHER / TEMP:**  
 JULY 14, 2014    JULY 21, 2014  
 SUNNY, E-NE    SUNNY, E-NE  
 76° F                      82°

**DATUM:**

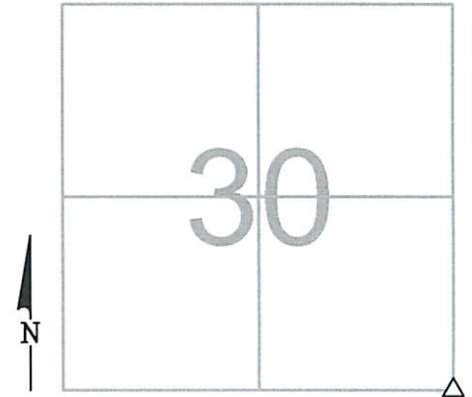

### MONUMENT INFORMATION

MONUMENT TYPE: FD 6" X 4-1/2" RECTANGULAR STONE  
 ON SURFACE - BELOW: 1.87'  
 LEFT - CL PAV'T - RIGHT:  
 USED CENTER OF STONE.



### MISC. INFORMATION

7-17-14 - FD MAG NAIL ON SURFACE WITH 2'-0" TIES N,S,E & W.  
 DUG FOR MONUMENT BOX OF RECORD. FOUND MONUMENT  
 BOX 0.62' BELOW SURFACE. CLEANED OUT STONES AND  
 DIRT FROM BOX AND DID NOT FIND IRON PIN. PRODDED  
 BOTTOM OF BOX AND HIT STONE 1' BELOW THE TOP OF THE  
 BOX.

7-21-14 - RETURNED TO SITE REMOVED BOX AND FOUND  
 STONE.

JULY 21, 2014

SET 1" SQUARE IRON PIN  
 IN MONUMENT BOX OVER  
 STONE

