

OTTAWA COUNTY ENGINEERS OFFICE

REFERENCE NO. 31-7-16-B
 NORTH QUARTER POST SEC. 31
 ERIE TWP.
SHEET 1 OF 1.

ROUTE: T-13 RYMERS RD.
 @ T-131 FRITCHIE RD.

TOWNSHIP: ERIE


SECTION: 31

T 7 NR 16 E.

NORTHING:

EASTING:

DATUM:

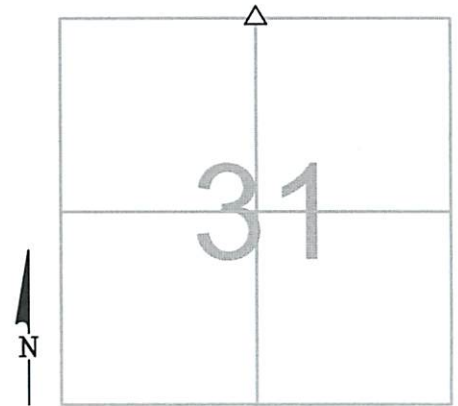

PERSONNEL:
 M. WITTMAN, P.S.
 J. ALLEN

DATE / WEATHER / TEMP:
 JULY 15, 2014
 SUNNY, SW
 75° F

MONUMENT INFORMATION

MONUMENT TYPE: FD LIMESTONE W/ DH
 ON SURFACE - BELOW: 2.23'
 LEFT - CL PAV'T - RIGHT:

4" X 3-1/2" ROUND LIMESTONE

USED DRILL HOLE IN STONE.



MISC. INFORMATION

NOTHING FOUND IN EXISTING DIG HOLE ON SURFACE. FD PK NAIL 0.37' BELOW SURFACE, TIED W/ X-TIES AND DUG FOR STONE. PK NAIL FOUND WAS DIRECTLY OVER THE DRILL HOLE FOUND IN THE STONE.

JULY 15, 2014

SET 1" SQUARE IRON PIN
 IN MONUMENT BOX OVER
 STONE

