

OTTAWA COUNTY ENGINEERS OFFICE

REFERENCE NO. 31-7-16-C
 NE CORNER POST SECTION 31
 ERIE TWP.
SHEET 1 OF 1.

ROUTE: T-131 FRITCHIE RD.

TOWNSHIP: ERIE

SECTION: 31

T 7 **N** **R** 16 **E.**


NORTHING:

EASTING:

DATUM:

PERSONNEL:
 M. WITTMAN, P.S.
 J. ALLEN

DATE / WEATHER / TEMP:
 JULY 14, 2014 JULY 21, 2014
 SUNNY, E-NE SUNNY, E-NE
 76° F 82°

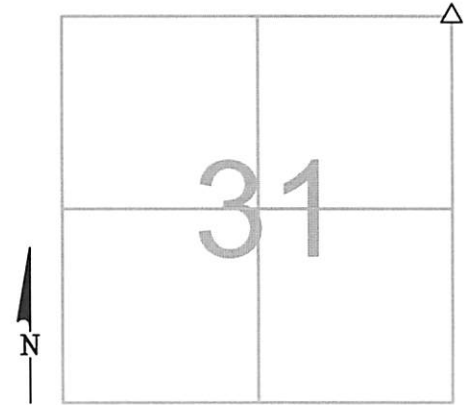

MONUMENT INFORMATION

MONUMENT TYPE: FD 6" X 4-1/2" RECTANGULAR STONE
 ON SURFACE - BELOW: 1.87'
 LEFT - CL PAV'T - RIGHT:
 USED CENTER OF STONE.



MISC. INFORMATION

7-17-14 - FD MAG NAIL ON SURFACE WITH 2'-0" TIES N,S,E & W.
 DUG FOR MONUMENT BOX OF RECORD. FOUND MONUMENT
 BOX 0.62' BELOW SURFACE. CLEANED OUT STONES AND
 DIRT FROM BOX AND DID NOT FIND IRON PIN. PRODDED
 BOTTOM OF BOX AND HIT STONE 1' BELOW THE TOP OF THE
 BOX.

7-21-14 - RETURNED TO SITE REMOVED BOX AND FOUND
 STONE.

JULY 21, 2014

SET 1" SQUARE IRON PIN
 IN MONUMENT BOX OVER
 STONE

