

OTTAWA COUNTY ENGINEERS OFFICE

REFERENCE NO. 31-7-16-D
WEST QUARTER POST SEC. 31
ERIE TWP.
SHEET 1 OF 1.

ROUTE: C-26 CARROLL-ERIE RD.

TOWNSHIP: ERIE

SECTION: 31

T 7 NR 16 E.

PERSONNEL:

M. WITTMAN, P.S.
J. ALLEN
M. ULLRICH, S. ULLRICH
A. WEIRICH, P.S.(BEC), J. HAYES
(BEC), M. POMMERANZ (BEC)

NORTHING:

EASTING:

DATUM:



DATE / WEATHER / TEMP:

JUNE 27, 2008
SUNNY SW
76° F

MONUMENT INFORMATION

MONUMENT TYPE: FD. 6" X 5" HARDHEAD STONE
ON SURFACE - BELOW: 1.90'
LEFT - CL PAV'T - RIGHT: 1.30'




MISC. INFORMATION

SET DRILL HOLE CENTER OF STONE

THIS IS A CLOSING CORNER

JUNE 27, 2008

SET 1" SQUARE IRON PIN
IN MONUMENT BOX OVER
STONE

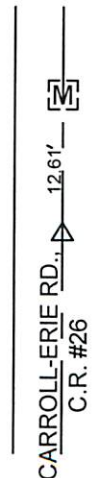

EAST $\frac{1}{4}$ POST SALEM SECTION 36
IRON PIN IN MONUMENT BOX