

OTTAWA COUNTY ENGINEERS OFFICE

REFERENCE NO. 31-7-16-E
CENTER POST SECTION 31
ERIE TWP.
SHEET 1 OF 1.

ROUTE: T-13 RYMERS RD.

TOWNSHIP: ERIE

SECTION: 31

T 7 NR 16 E.

PERSONNEL:

M. WITTMAN, P.S.,
D. BRUNKHORST, P.E., R.S.,
R. LAJTI, P.E., S.I.T.,
B. JEFFRIES, M. ULLRICH, S. ULLRICH,
A. WEIRICH P.S. (BEC), J. HAYES (BEC),
M. POMMERANZ (BEC)


NORTHING:

EASTING:

DATE / WEATHER / TEMP:

JULY 2, 2008
SUNNY SW
76° F

DATUM:

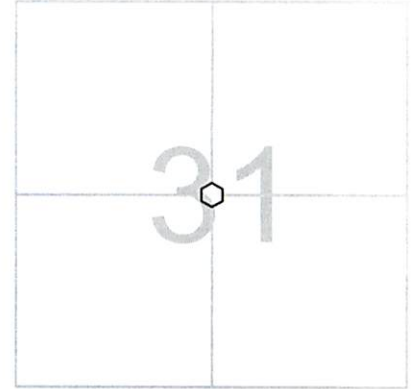

MONUMENT INFORMATION

MONUMENT TYPE: FD. 2" Ø DETERIORATED
WOOD STAKE
ON SURFACE - BELOW: 2.72'
LEFT - CL PAV'T - RIGHT:




MISC. INFORMATION

STAKE MATCHED ANGLE AND WAS 0.86' ± SOUTH
OF DISTANCE FOR C. DEWITT SURVEY DATED
6/13/1894: SEE SURVEY BOOK 3 PG. 96
FOR ADDITIONAL INFORMATION. STAKE WAS
WITNESSED AND CALLED BY DAVID A.
BRUNKHORST P.E., R.S., OTTAWA COUNTY
ENGINEER

JULY 2, 2008

SET 1" SQUARE IRON PIN X 5' LONG
DOWN CENTER OF WOOD STAKE
(WOOD STAKE NOT SALVAGEABLE,
ALTHOUGH REMNANTS WERE KEPT)
SET MONUMENT BOX OVER IRON
PIN

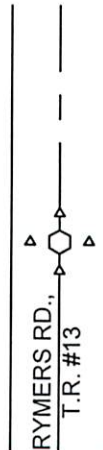

SET 3.0' TIES
MAG NAILS N, S, E, W