

OTTAWA COUNTY ENGINEERS OFFICE

REFERENCE NO. 31-7-16-G
 SW CORNER POST SECTION 31
 ERIE TWP.
 SHEET 1 OF 1.

ROUTE: C-26 CARROLL-ERIE RD.

TOWNSHIP: ERIE

SECTION: 31


T 7 NR 16 E.

PERSONNEL:
 M. WITTMAN, P.S.
 J. ALLEN
 V. SZABO

NORTHING:

EASTING:

DATUM:

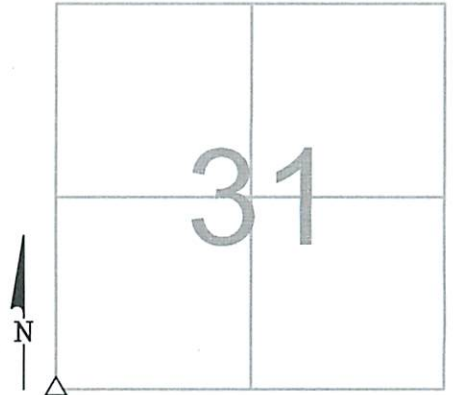

DATE / WEATHER / TEMP:

JULY 10, 2018
 SUNNY - NE
 88° F

MONUMENT INFORMATION

MONUMENT TYPE: FD. POINTED LIMESTONE
 ON SURFACE - BELOW: 1.88'
LEFT - CL PAV'T - RIGHT: 3.80'

4" x 6" POINTED LIMESTONE.

USED CENTER OF POINT ON STONE.



MISC. INFORMATION

FD. PONY SPIKE 0.25' BELOW SURFACE, TIED W/
 X-TIES AND DUG FOR STONE. FD. MULTIPLE
 PIECES OF SCRAP IRON OVER STONE. PONY
 SPIKE WAS DIRECTLY OVER POINT OF STONE.

JULY 10, 2018

SET 1" SQUARE IRON PIN
 IN MONUMENT BOX OVER
 STONE

SALEM SEC. 36 T7N
 SALEM SEC. 1 T6N

