

# OTTAWA COUNTY ENGINEERS OFFICE

REFERENCE NO. 31-7-16-H  
 SOUTH QUARTER POST SEC. 31  
 ERIE TWP.  
 SHEET 1 OF 1.

ROUTE: T-13 RYMERS RD.  
 @ SR-163

TOWNSHIP: ERIE

SECTION: 31

T 7 NR 16 E.


PERSONNEL:  
 M. WITTMAN, P.S.  
 B. JEFFRIES  
 M. ULLRICH  
 S. ULLRICH

NORTHING:

EASTING:

DATUM:

DATE / WEATHER / TEMP:  
 JULY 8, 2008  
 SUNNY SW  
 78° F

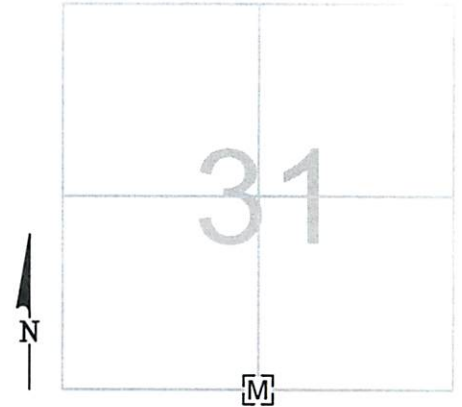

### MONUMENT INFORMATION

MONUMENT TYPE: FD. 1" SQUARE IRON PIN IN  
 MONUMENT BOX  
 ON SURFACE - BELOW: 0.58'  
 LEFT - CL PAV'T - RIGHT: 1.0'



### MISC. INFORMATION

JULY 8, 2008

RAISED TO SURFACE

