

OTTAWA COUNTY ENGINEERS OFFICE

REFERENCE NO. 32-7-16-J
W 1/16 POST SECTION 32
ERIE TWP.
SHEET 1 OF 1.

PERSONNEL:
M. WITTMAN, P.S.
J. ALLEN

DATE / WEATHER / TEMP:
JULY 21, 2014
SUNNY, N-NE
86° F

ROUTE: T-131 FRITCHIE RD.

TOWNSHIP: ERIE


SECTION: 32

T 7 NR 16 E.

NORTHING:

EASTING:

DATUM:

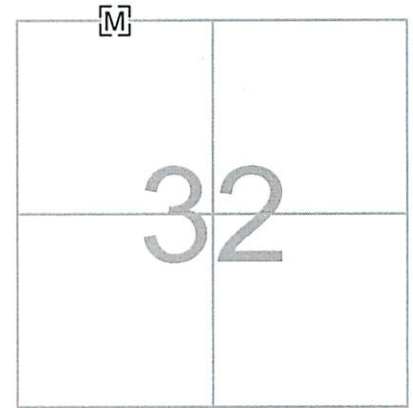

MONUMENT INFORMATION

MONUMENT TYPE: FD 3/4" Ø IRON PIN IN MON BOX
ON SURFACE - BELOW: 0.66'
LEFT - CL PAV'T - RIGHT: 0.60'



MISC. INFORMATION

JULY 21, 2014

SET MONUMENT BOX OVER
FD IRON PIN IN MONUMENT BOX

